

Bally Kiss

554.126.v37 GL (10/16/2020)


© 2013-2020 Art Form Architecture, Inc., all rights reserved . You may not build this design without purchasing a license, even if you make changes. This design may have geographic restrictions.



603-431-9559

Living Area this Floor: 1264 sq ft
9 ft Ceilings, unless noted otherwise

Window grids- Top only
Slider - no grids

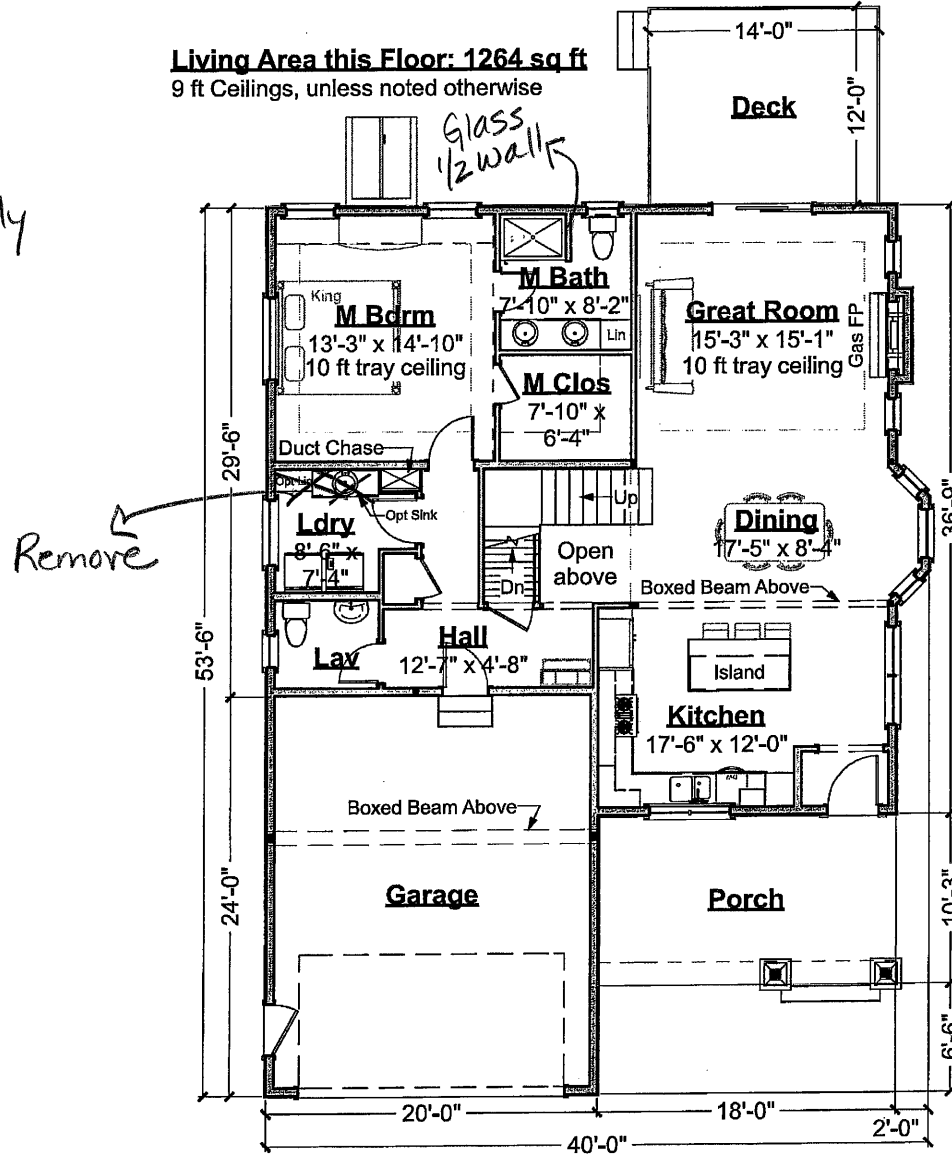

 11/09/21 5:31 PM EST CNC verified	 11/09/21 6:08 PM EST CNC verified	 11/09/21 4:35 PM EST JC verified
--	--	---

First Floor Plan

Scale: 3/32" = 1'-0"

