

Sir Zach


845.124.v8 GR (12/7/2020)

© 2016-2020 Art Form Architecture, Inc., all rights reserved. You may not build this design without purchasing a license, even if you make changes. This design may have geographic restrictions.



603-431-9559

Flip Plan-Garage Left
Window grids- Top only
Slider- full grids

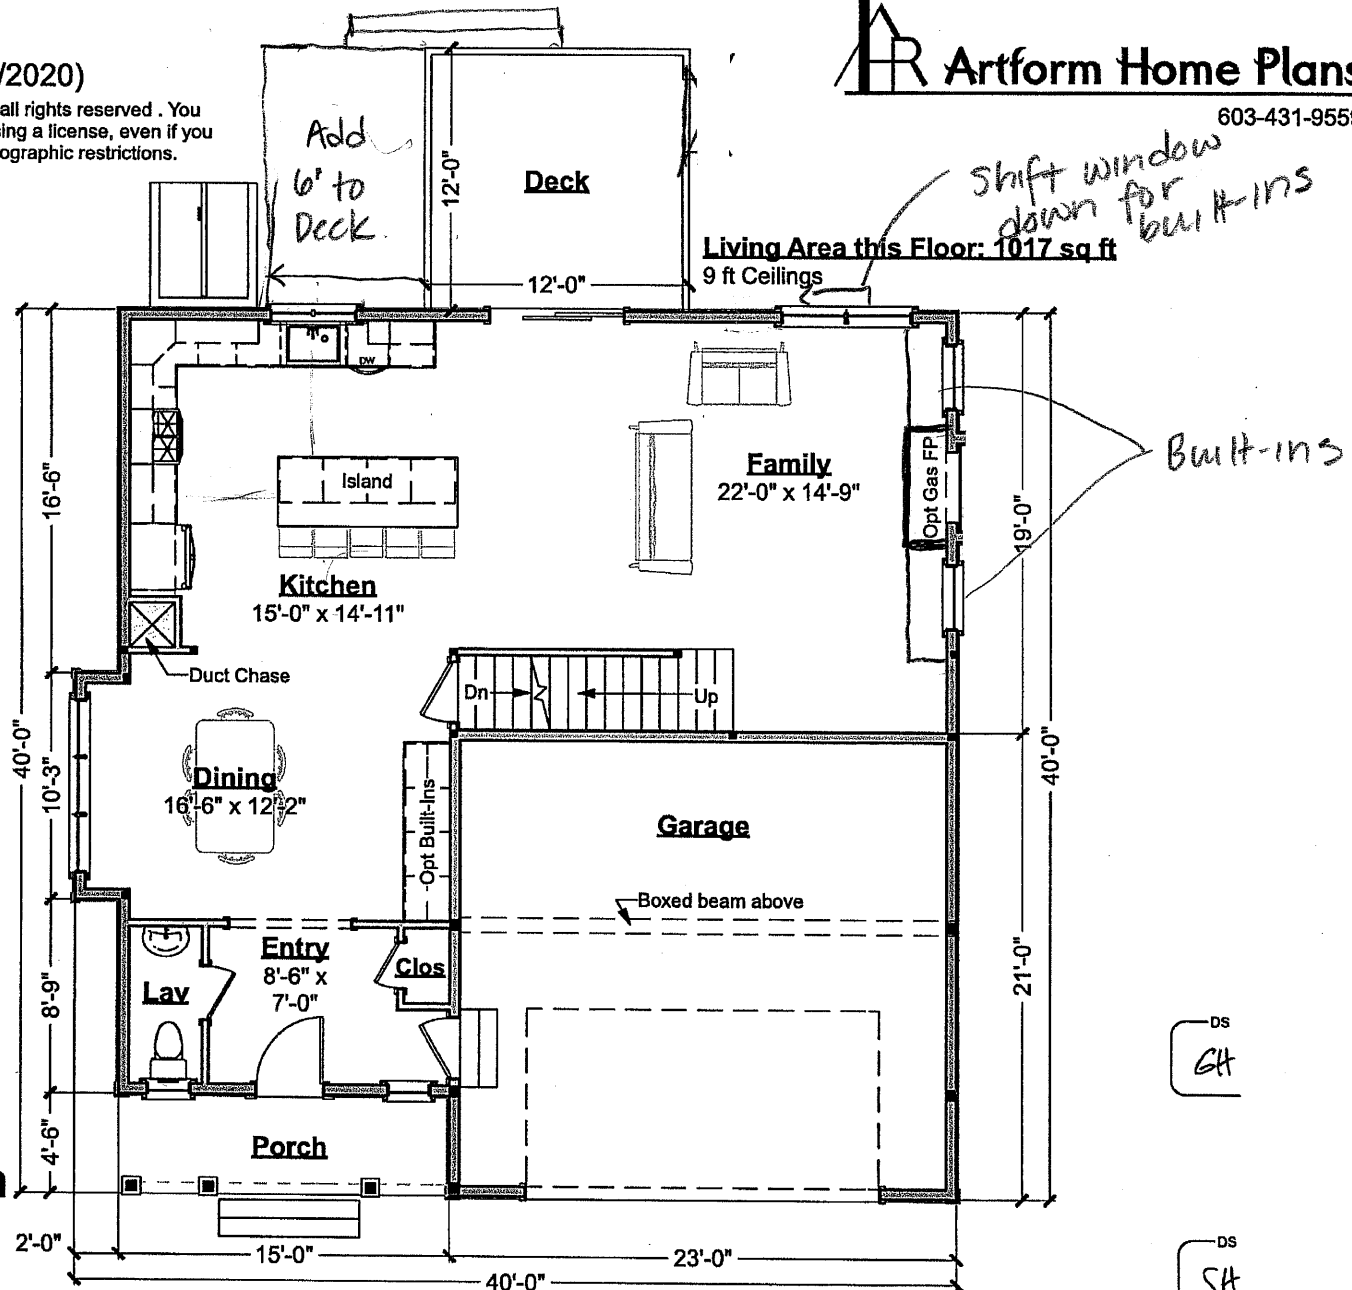

First Floor Plan

Scale: 1/8" = 1'-0"


Sir Zach

845.124.v8 GR (12/7/2020)

© 2016-2020 Art Form Architecture, Inc., all rights reserved. You may not build this design without purchasing a license, even if you make changes. This design may have geographic restrictions.

Artform Home Plans

603-431-9559

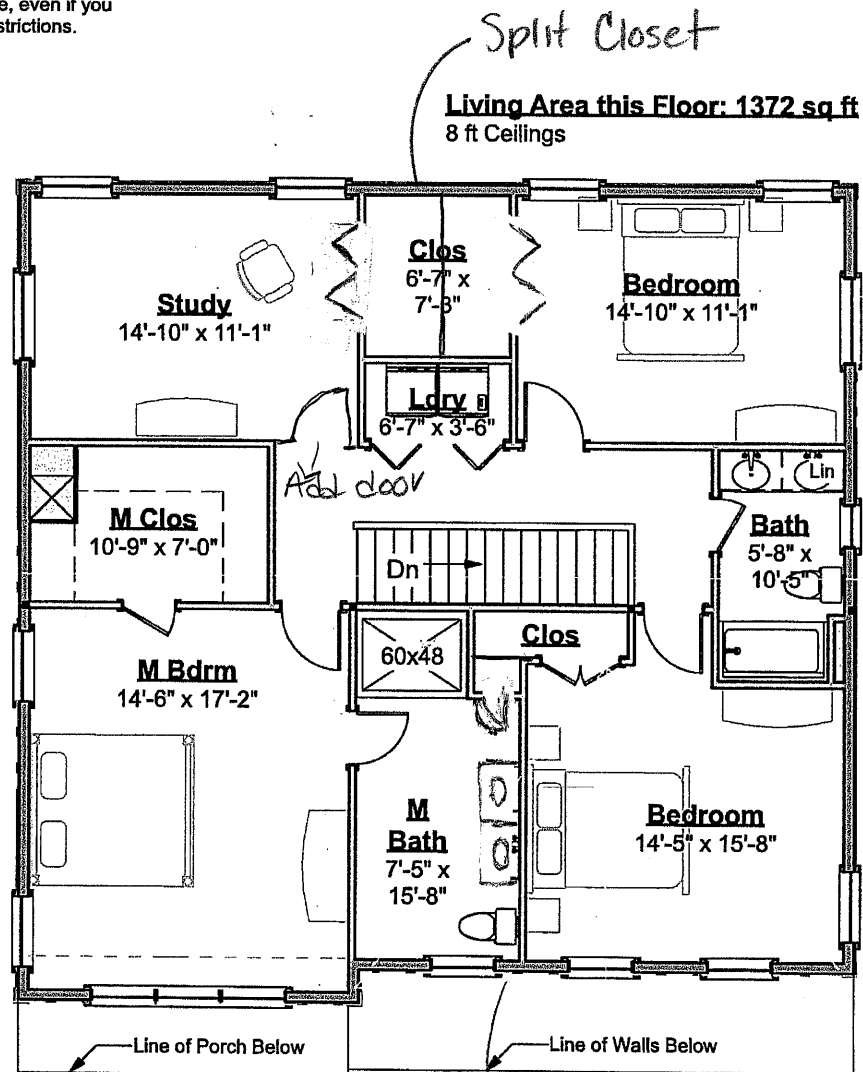

Second Floor Plan

Scale: 1/8" = 1'-0"