

New Saffron, custom

036.021 A1-c-C2


© 2008-2010 Wendy Welton, all rights reserved. You may not build this design without purchasing a license, even with changes. Some Artform designs have geographic restrictions. Contact the Builder or RE Agent or call Artform at 603-431-9559

Artform Home Plans

(printed 11/3/2011)

First Floor

Spicy Not-a-Colonial 28x36
First Floor A1 Custom

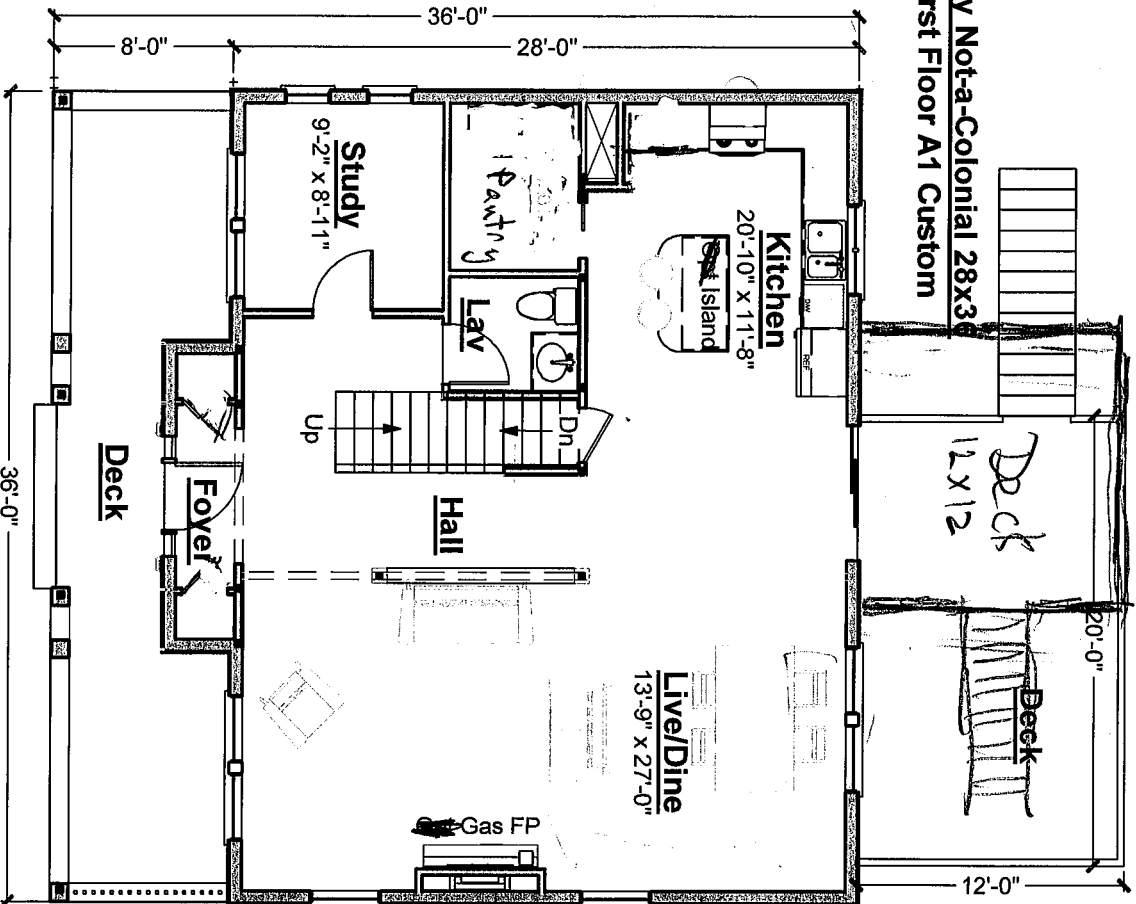

New Saffron, custom

036.021 A1-C2


© 2008-2010 Wendy Walton, all rights reserved. You may not build this design without purchasing a license, even with changes. Some Artform designs have geographic restrictions. Contact the Builder or RE Agent or call Artform at 603-431-9559

(printed 11/3/2011)
Artform Home Plans

Second Floor

New Saffron 28x36 Second Floor C2

Dine under
left side

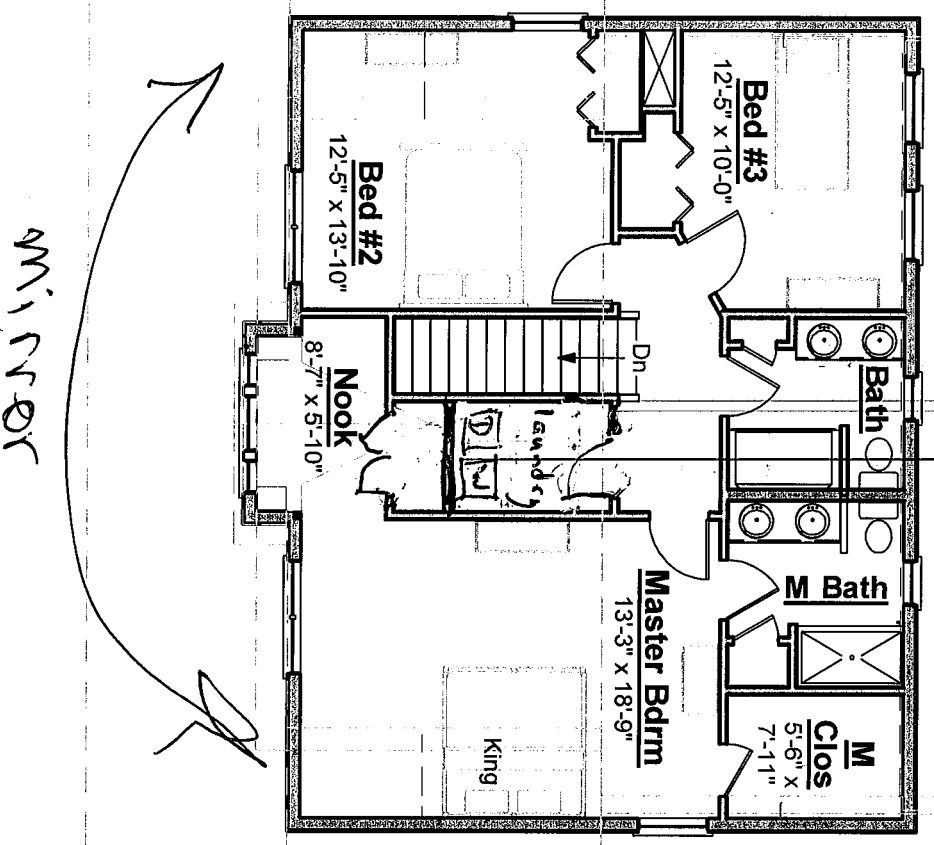

MINOR