



Artform Home Plans

603.431.9559

[Home](#) [Photos & Builder Galleries](#) [Service for Homeowners](#) [Service for Builders](#) [Prices & Details](#) [About Us](#)

Plans by Lifestyle

Aging in Place

For empty nesters, 1st floor masters, etc

Generations™

For 3 generation families

Home Works™

Include work spaces large and small

Entertainers™

Entertainment friendly, all sizes

Simple Family™

2 1/2 kids, with or without the dog!

by Size/Complexity

Small Wonders

Small Home Plans - LEED neutral or better

Good Manors

A better way to do the modern "Manor" house

Expandables

Include unfinished expansion space

Carpenter

Relatively simple framing and lines

Patron

More complex shape, framing or detailing

Special Pricing

Free & Honor

Free or discounted to veterans

Raspberry Biscotti

The Biscotti floor plan is a Ranch for a narrow lot. Notice that the master suite is well separated from the other two bedrooms.



Plan No. 564.144

Width: 46 Ft Depth: 57 Ft Height: 23.33 Ft

Main | Future | Apt | Main + Future | Main + Apt | All

Main House Living Area 1604 SF

Bedrooms 3

Baths 2.5

Construction Drawings

? Construction Plans \$1,100.00 ☐

? Reverse \$275.00 ☐

? Price Group: H2

Sub-Total: \$0.00

[Add to Cart](#)

See more plans in the [Berry Charming Ranches](#) Collection.

Reminder: This is a copyright protected design. Use of our designs or images without first obtaining a Copyright License from us is a violation of U.S. copyright laws, punishable with fines up to \$150,000, civil damages, and fines specified in our Terms of Use. Making changes, even significant ones, does not change this. "Copyright Infringement" is a polite phrase for Stealing. It hurts us, our staff and our legitimate clients. We pay for information leading to the successful recovery of fines or damages - 603-431-9559 - tips kept confidential

First Floor


The master bedroom wing in the rear can be expanded as much as your lot and budget allow. This plan also expands to the right if you have room on your lot.

Floor Plan

RE


✓
LB

1

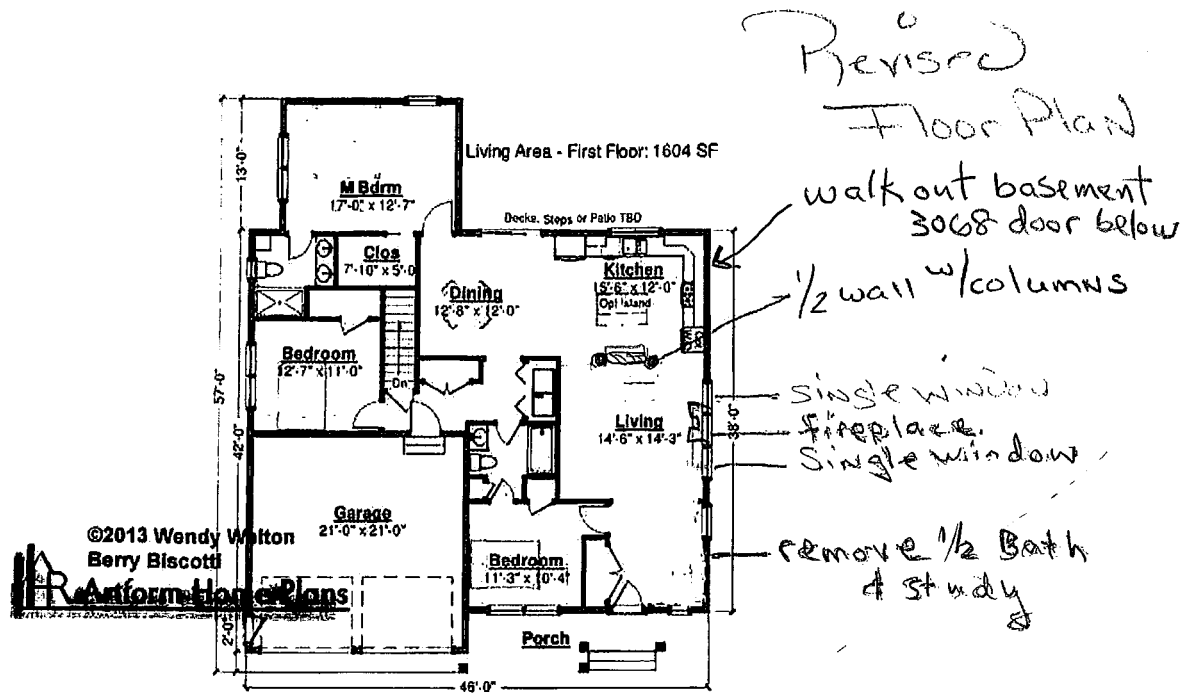

Basement


Floor Plan

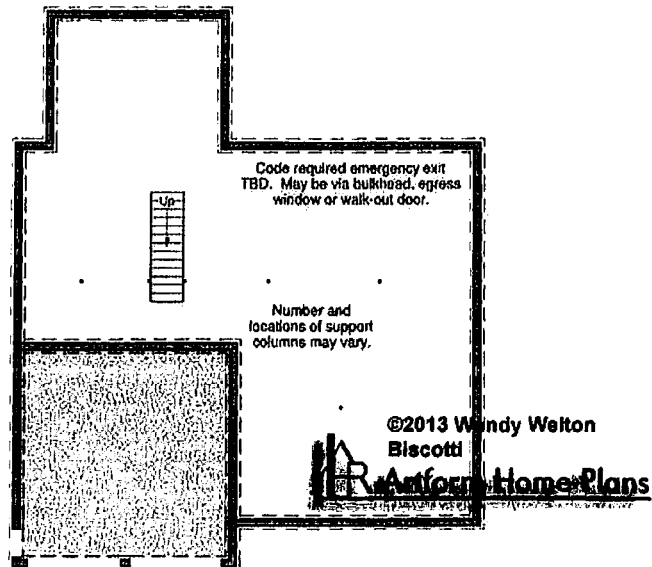

Heights


XCC
LB

Original
Floor
Plan

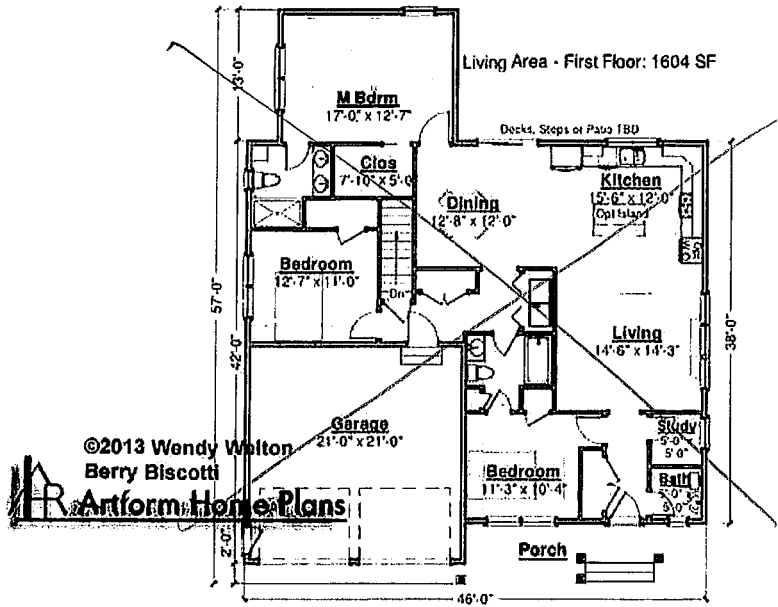

Basement

Floor Plan

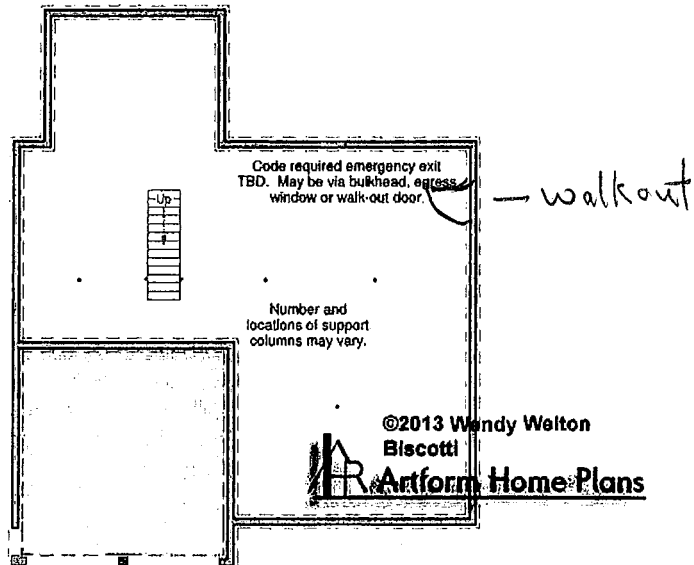

Heights

see
7
RB