

Raspberry Nugget Gold

417.123

© 2013 Art Form Architecture, Inc. All Rights Reserved . <http://www.artformhomeplans.com>

First Floor

Living Area: 987 SF

Bedrooms: 1

Bathrooms: 1.0

Ceiling Height Shown: 8'-0"


Ceiling Height Possible*: 8'-0"

* - Increasing ceiling height requires a Major Change.

- ① washer + dryer moved to hallway
- ② custom stove in place of w/d
- ③ wall + door to master suite
- ④ double vanity
- ⑤ mbr closet double poles each side shelf on top

- ⑥ island
- ⑦ dining
- ⑧ patio
- ⑨ screen porch
- ⑩ half wall
- ⑪ full wall

⑫ decision on +4 ft. design

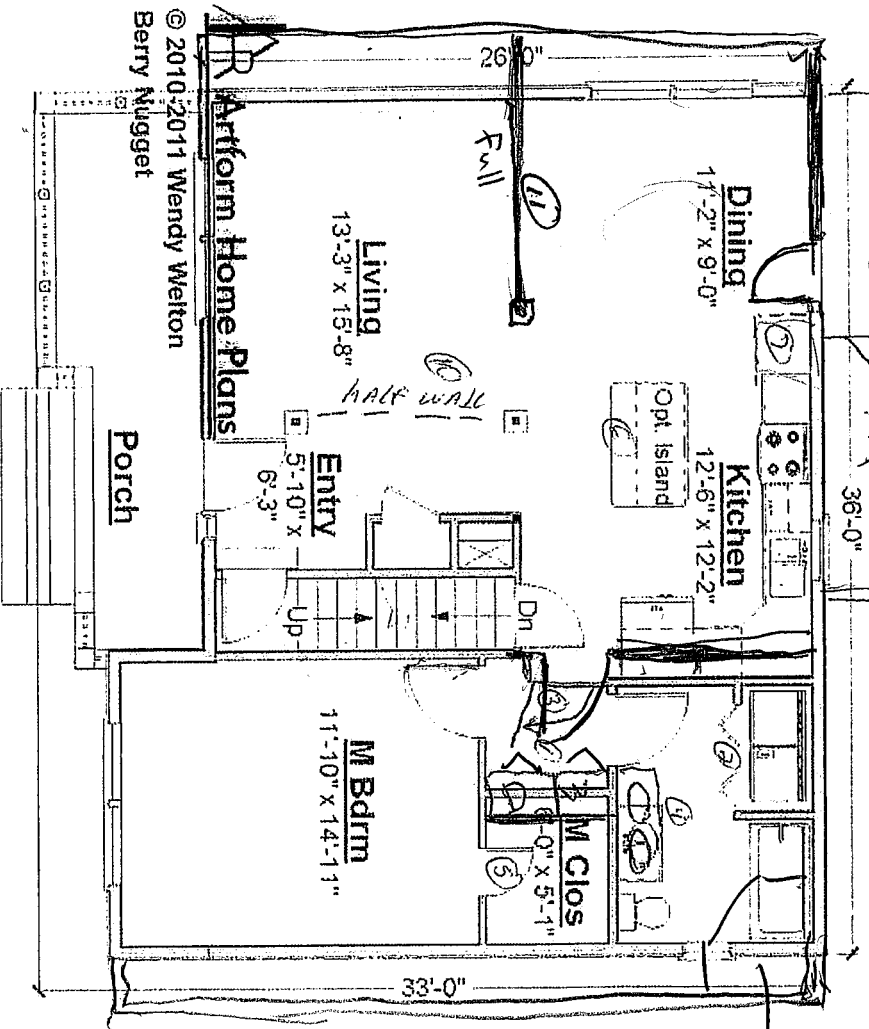

sliding window

12x10 deck

Artform Home Plans

corner soaking tub
- double sink
- linen

Raspberry Nugget Gold

417.123

© 2013 Art Form Architecture, Inc. All Rights Reserved . <http://www.artformhomeplans.com>

Second Floor

Living Area: 735 SF

Bedrooms: 2


Bathrooms: 1.0

Ceiling Height Shown: 8'-0"

Ceiling Height Possible*: 8'-0"

* - Increasing ceiling height requires a Major Change.

① Low rise tub
or shower instead

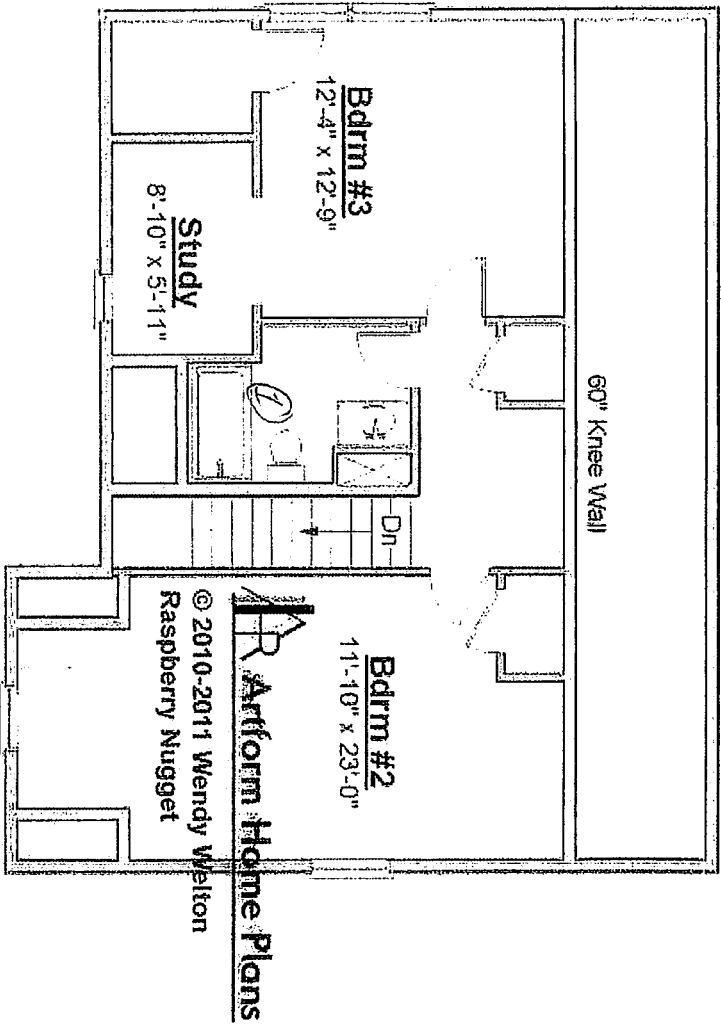

Artform Home Plans

KC

WJ

Raspberry Nugget Gold

417.123

© 2013 Art Form Architecture, Inc. All Rights Reserved . <http://www.artformhomeplans.com>

Basement Floor

Living Area: 0 SF

Bedrooms: 0

Bathrooms: 0.0


Ceiling Height Shown: 7'-8"

Ceiling Height Possible*: 9'-0"

* -- Increasing ceiling height requires a Major Change.

① ADD round door
up stairs

* CAST of rough plumbing
for future bath


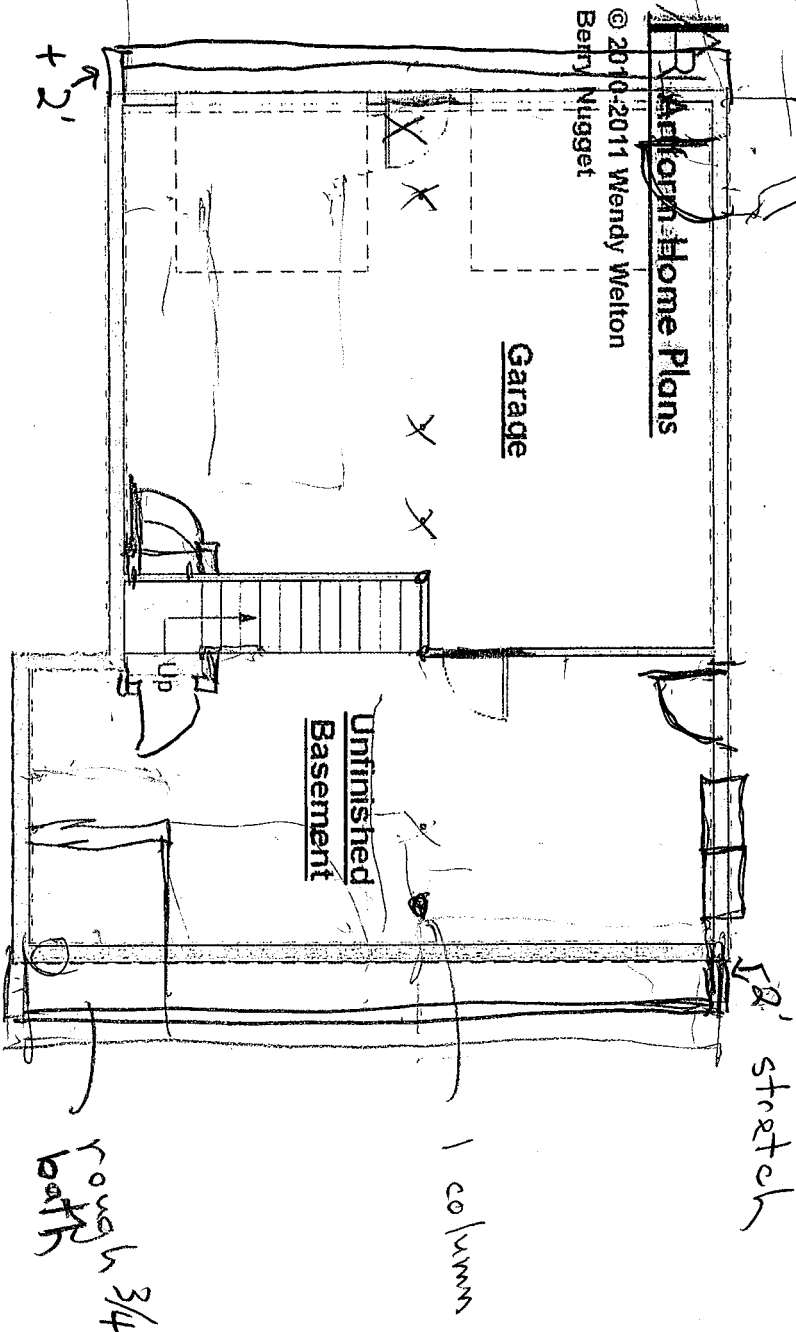


Raspberry Nugget Gold

417.123


© 2013 Art Form Architecture, Inc. All Rights Reserved · <http://www.artformhomeplans.com>

Elevations

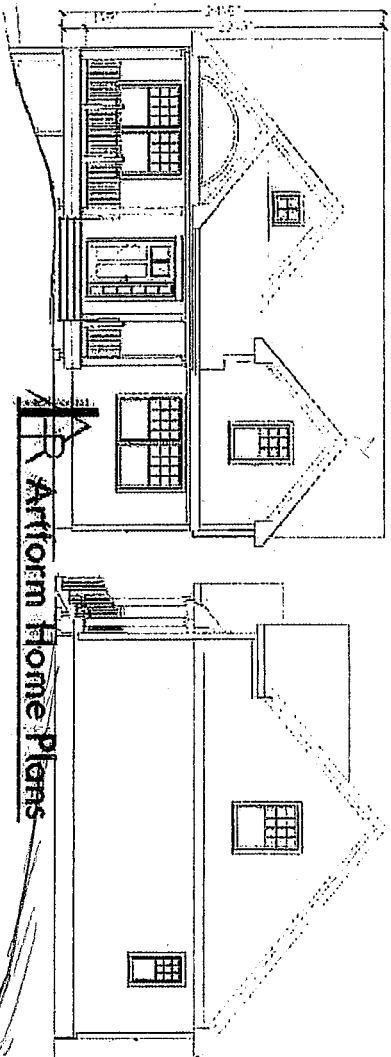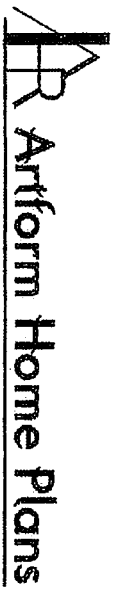

 Artform Home Plans

© 2010-2011 Wendy Welton
Raspberry Nugget

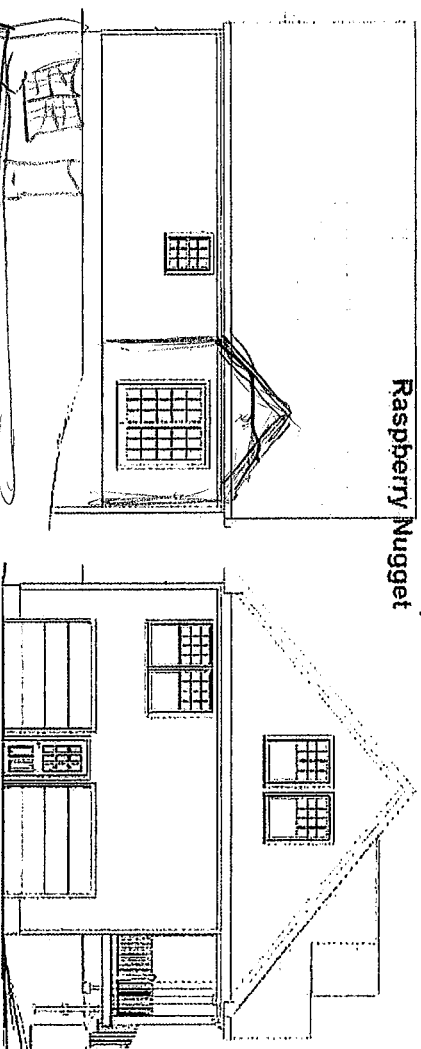

walkout

KE

JP