


Lot 5 Lorden

## FIRST FLOOR

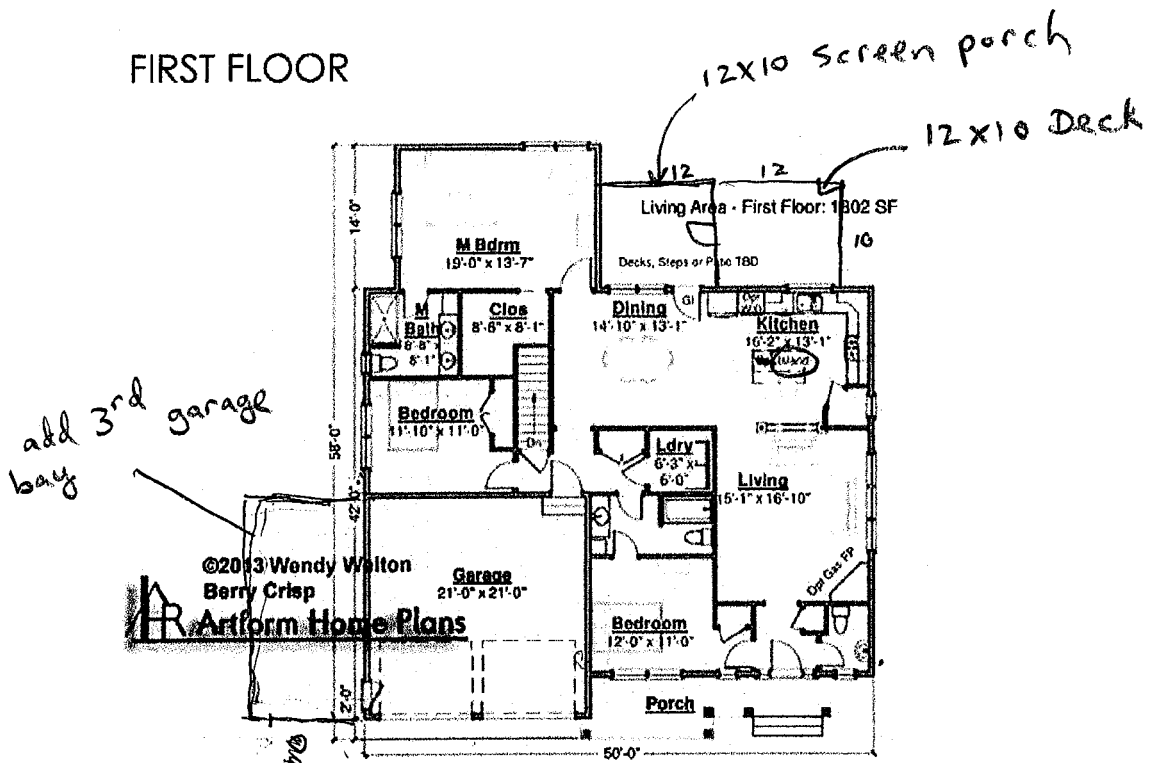

## BASEMENT

