


Vanilla Torte

tbd


© 2013 Wendy Welton, all rights reserved. You may not build this design without purchasing a license, even if you make changes. This design may have geographic restrictions.

Artform Home Plans

603-431-9559

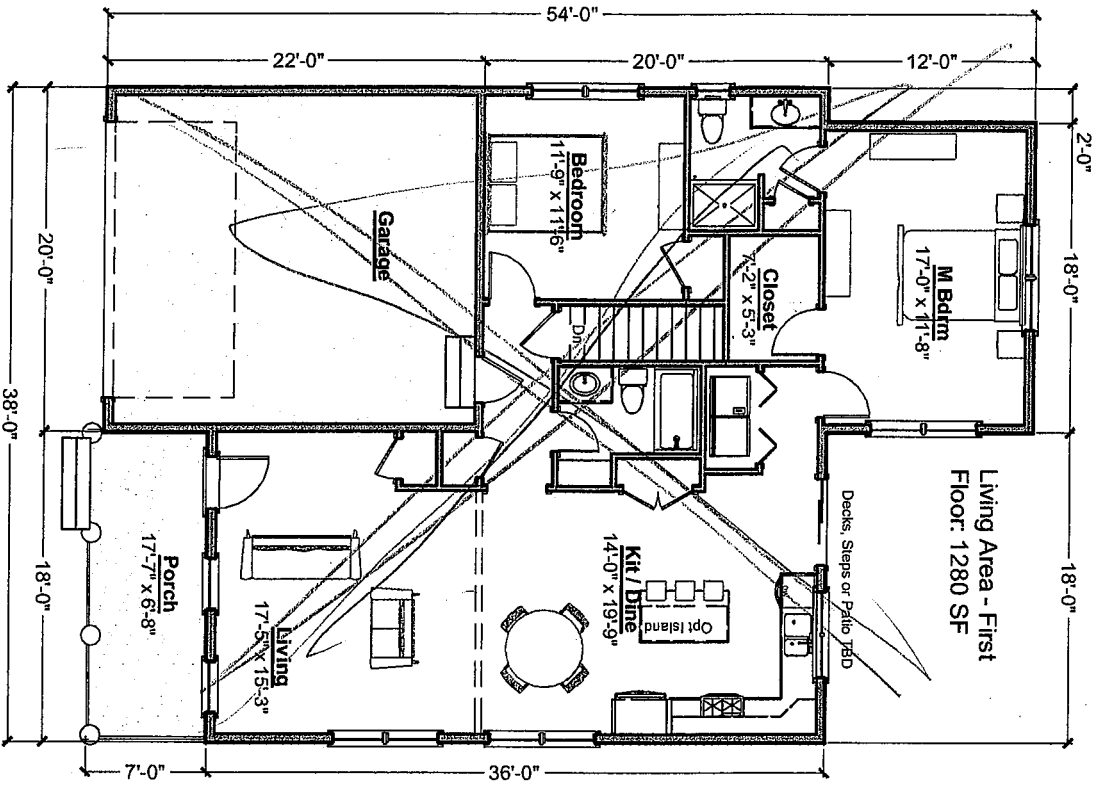

Narrower Lot

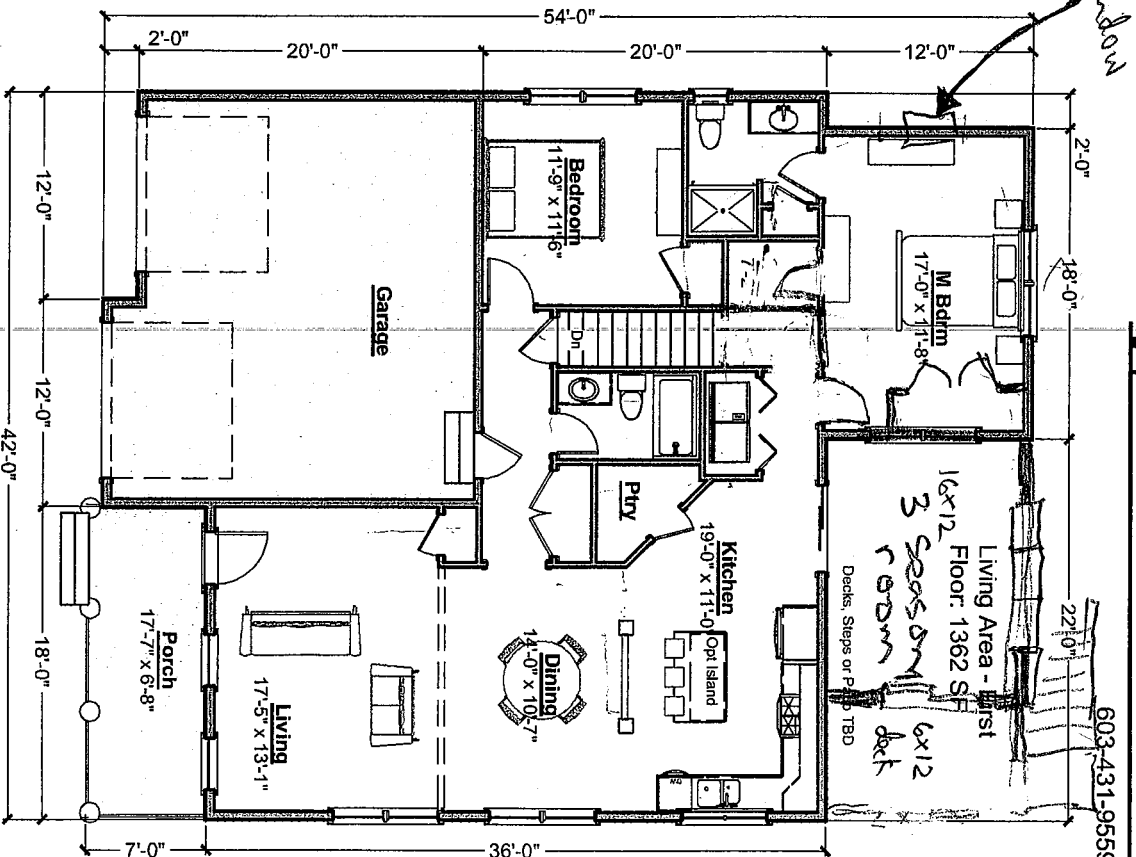

Wider Lot