



builder governs.

Verify Size and location of Deck

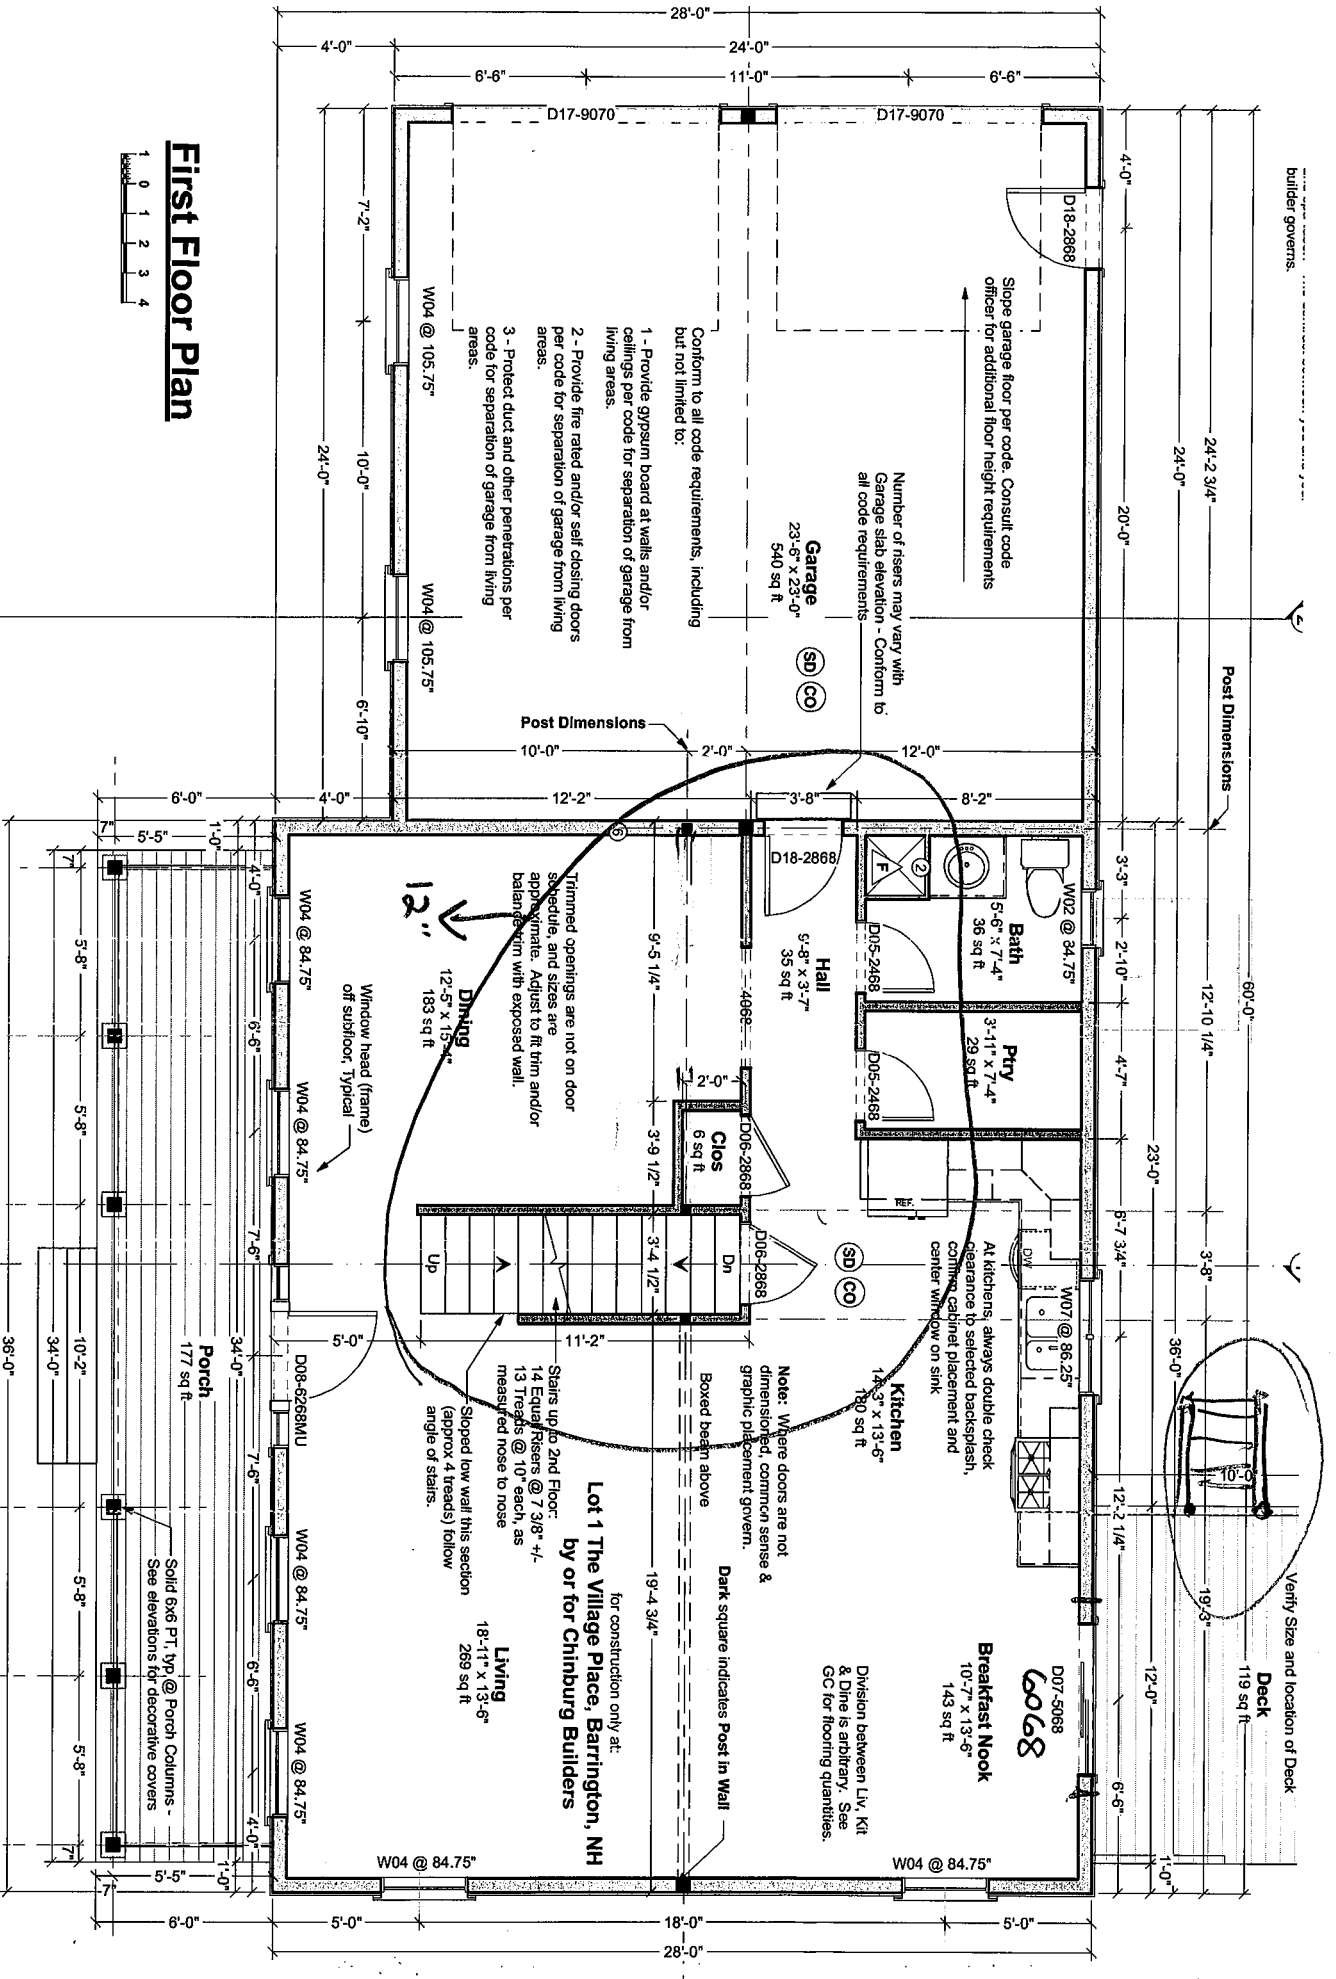

First Floor Plan

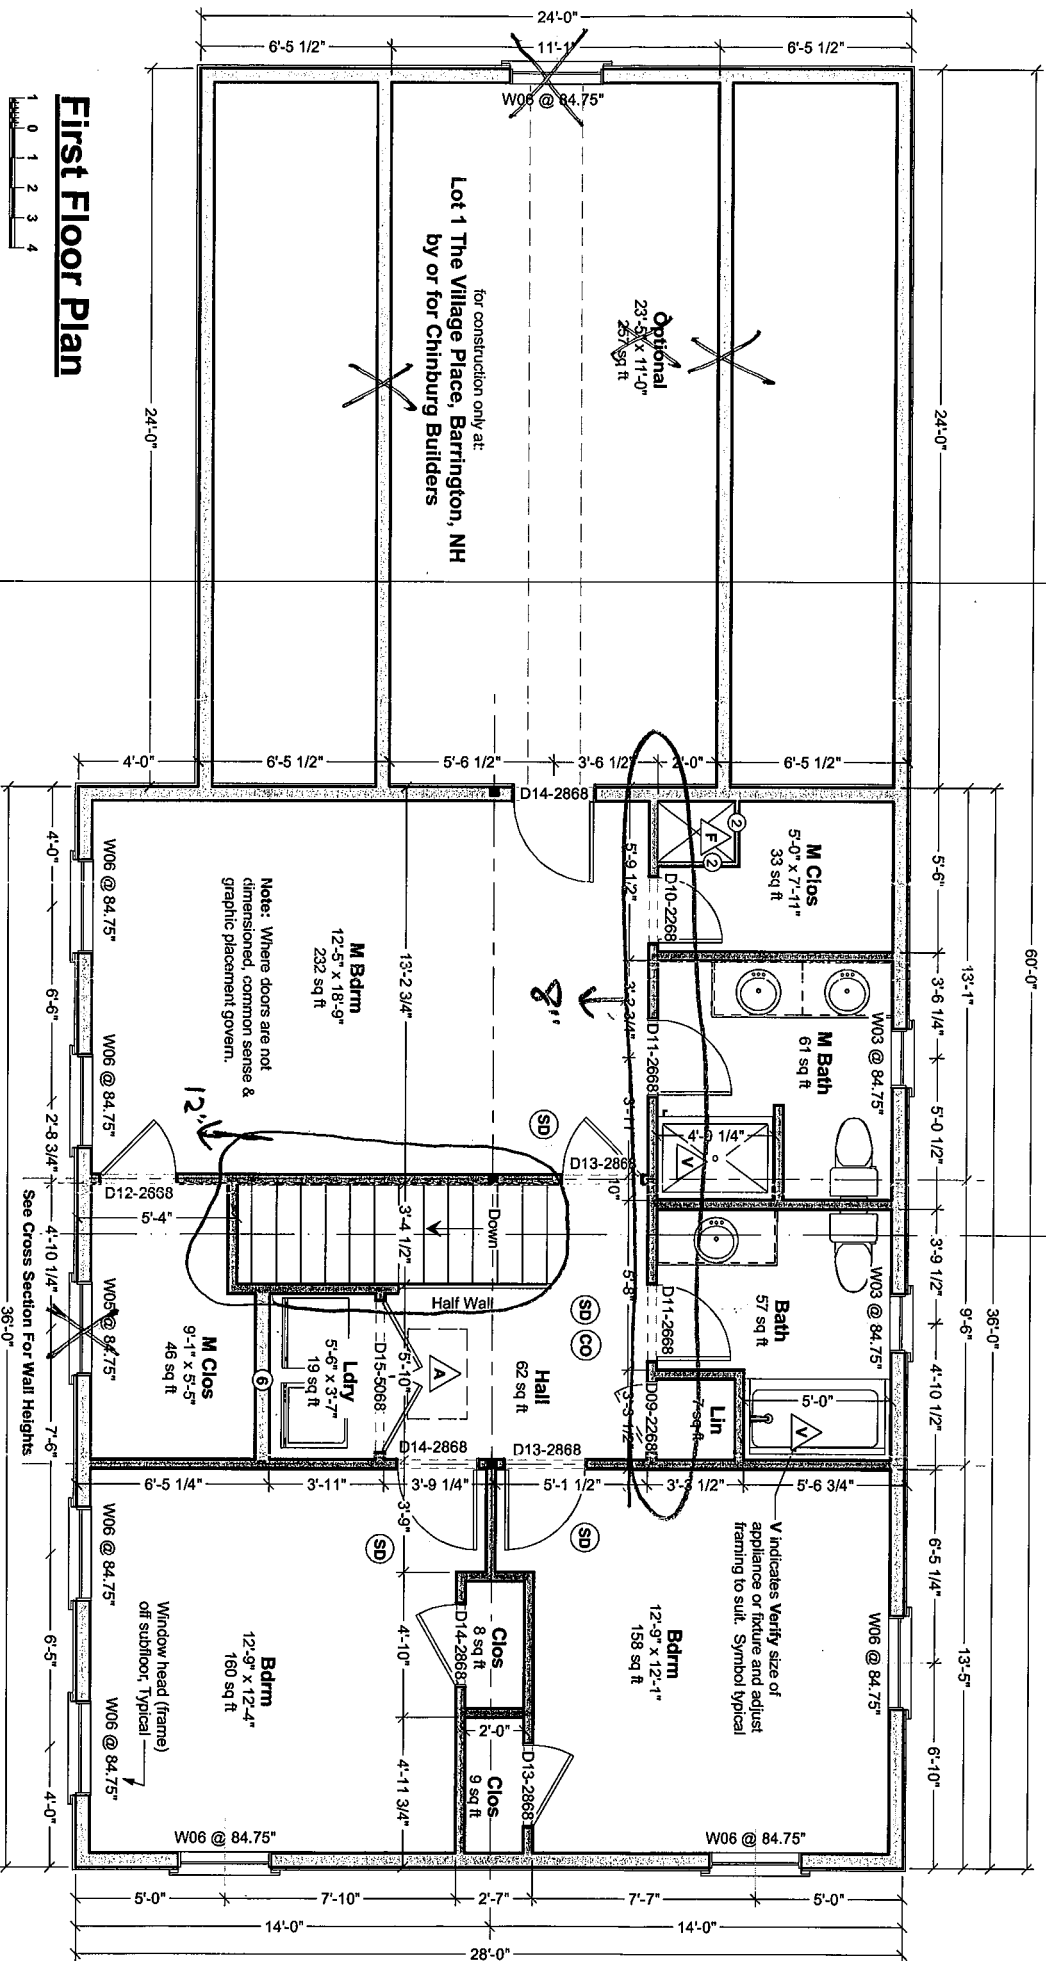


First Floor Plan



2

1

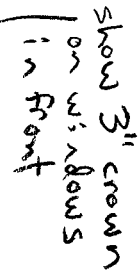

Right Elevation

