


Great Skye

635.124

© 2013 Wendy Welton, all rights reserved. You may not build this design without purchasing a license, even if you make changes. This design may have geographic restrictions.

Artform Home Plans

603-431-9559

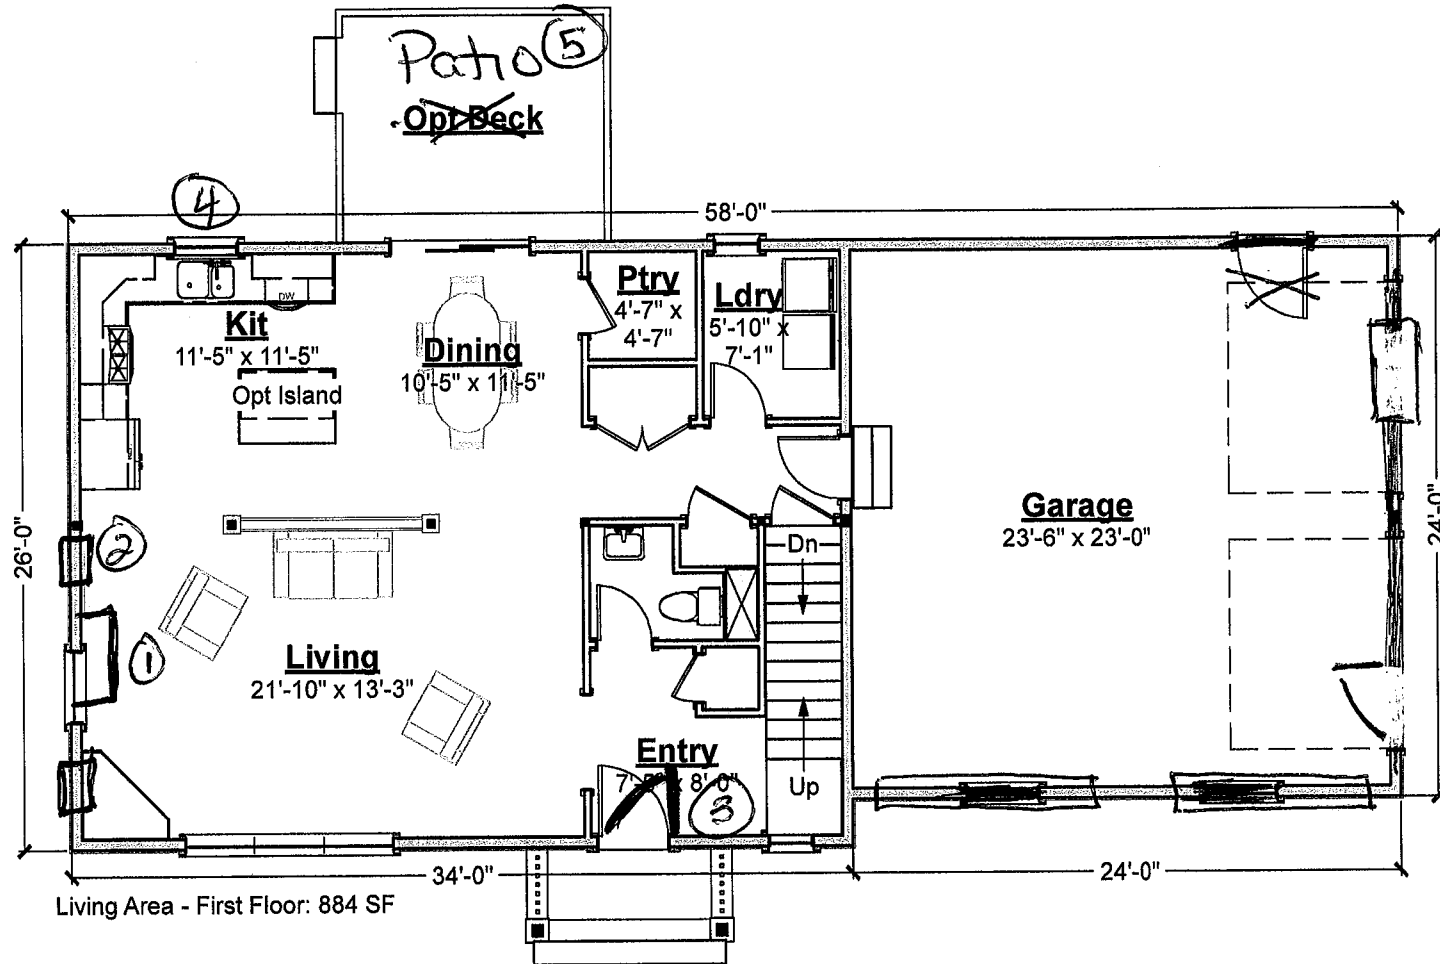

- ① move Fireplace to center
- ② add 2 Awning windows
- ③ change front door swing
- ④ casement window 34" wide


- ⑤ Patio
- ⑥ FRONT Load Garage w/door and 1 window on side

Great Skye

635.124

© 2013 Wendy Welton, all rights reserved . You may not build this design without purchasing a license, even if you make changes. This design may have geographic restrictions.

 **Artform Home Plans**
603-431-9559

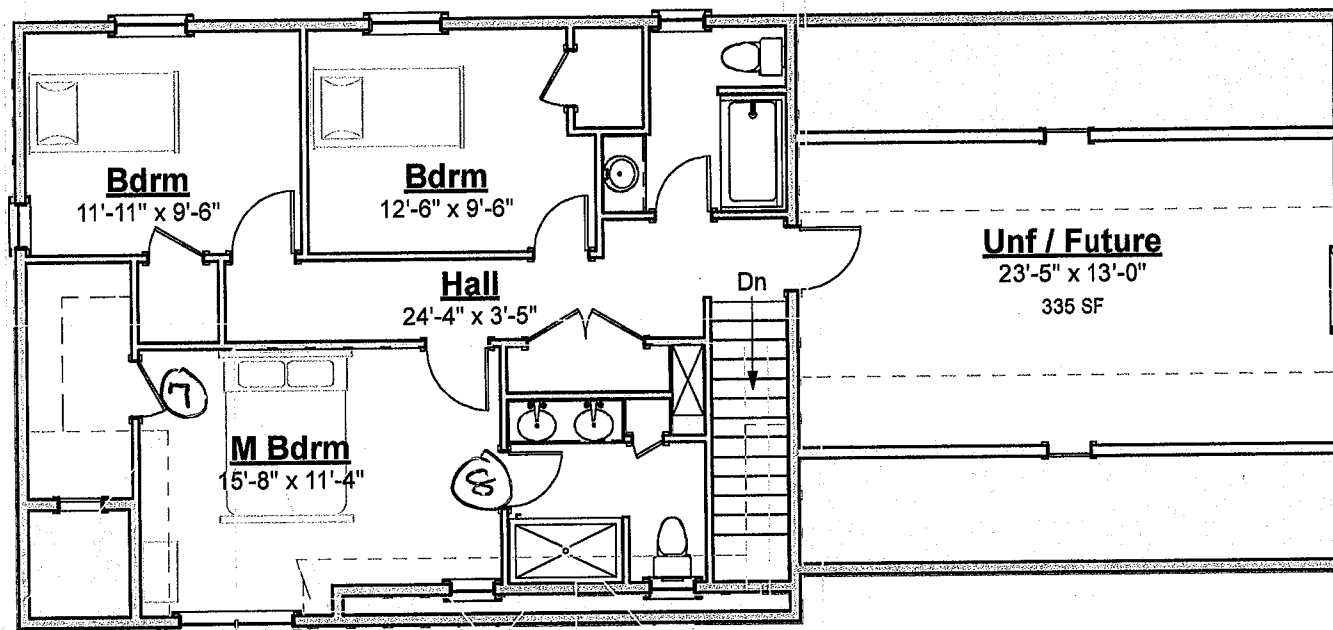

Living Area Second Floor: 834 SF

⑦ Pocket door
⑧ Pocket door

Great Skye

635.124

© 2013 Wendy Welton, all rights reserved. You may not build this design without purchasing a license, even if you make changes. This design may have geographic restrictions.

 **Artform Home Plans**
603-431-9559




Great Skye

635.124

© 2013 Wendy Welton, all rights reserved. You may not build this design without purchasing a license, even if you make changes. This design may have geographic restrictions.

 **Artform Home Plans**
603-431-9559

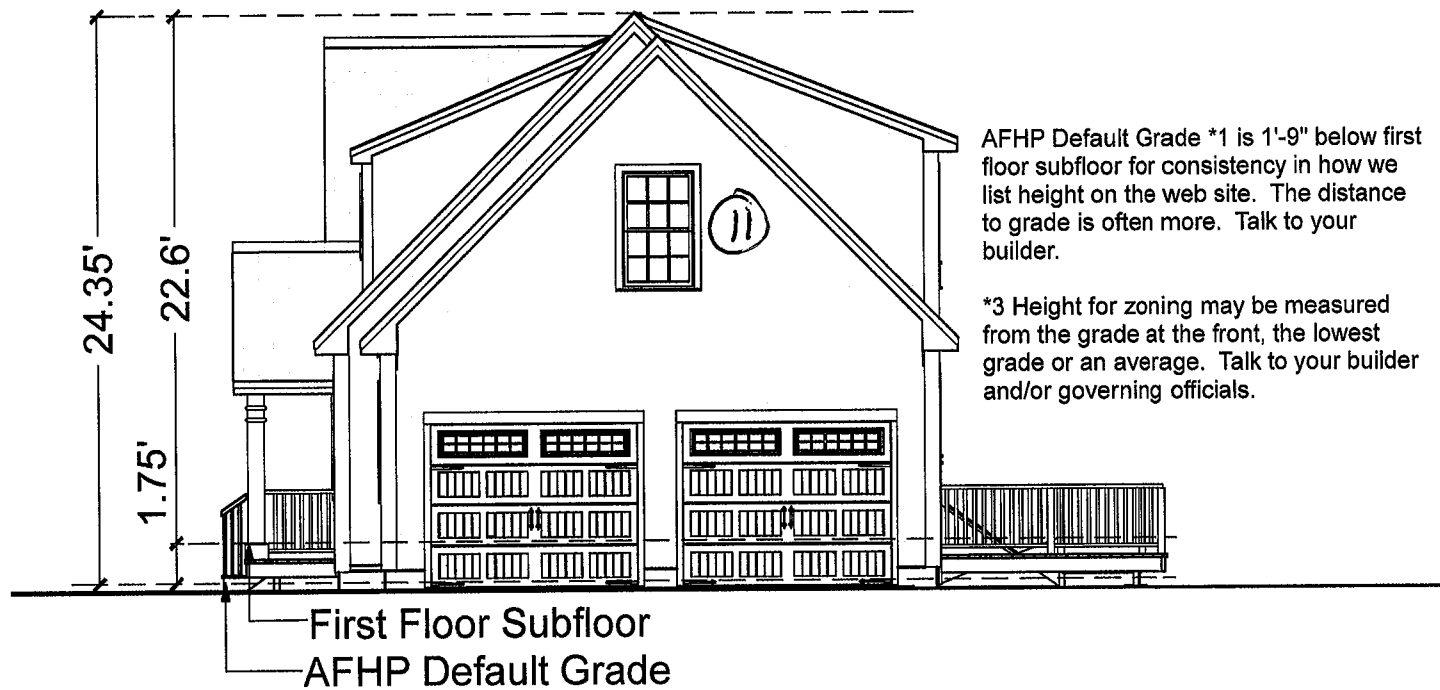

Great Skye

635.124

© 2013 Wendy Welton, all rights reserved . You may not build this design without purchasing a license, even if you make changes. This design may have geographic restrictions.

 **Artform Home Plans**
603-431-9559



- ⑨ ADD shakes
- ⑩ no shutters
- ⑪ Large Double Hungs 9 over 1 GRID