


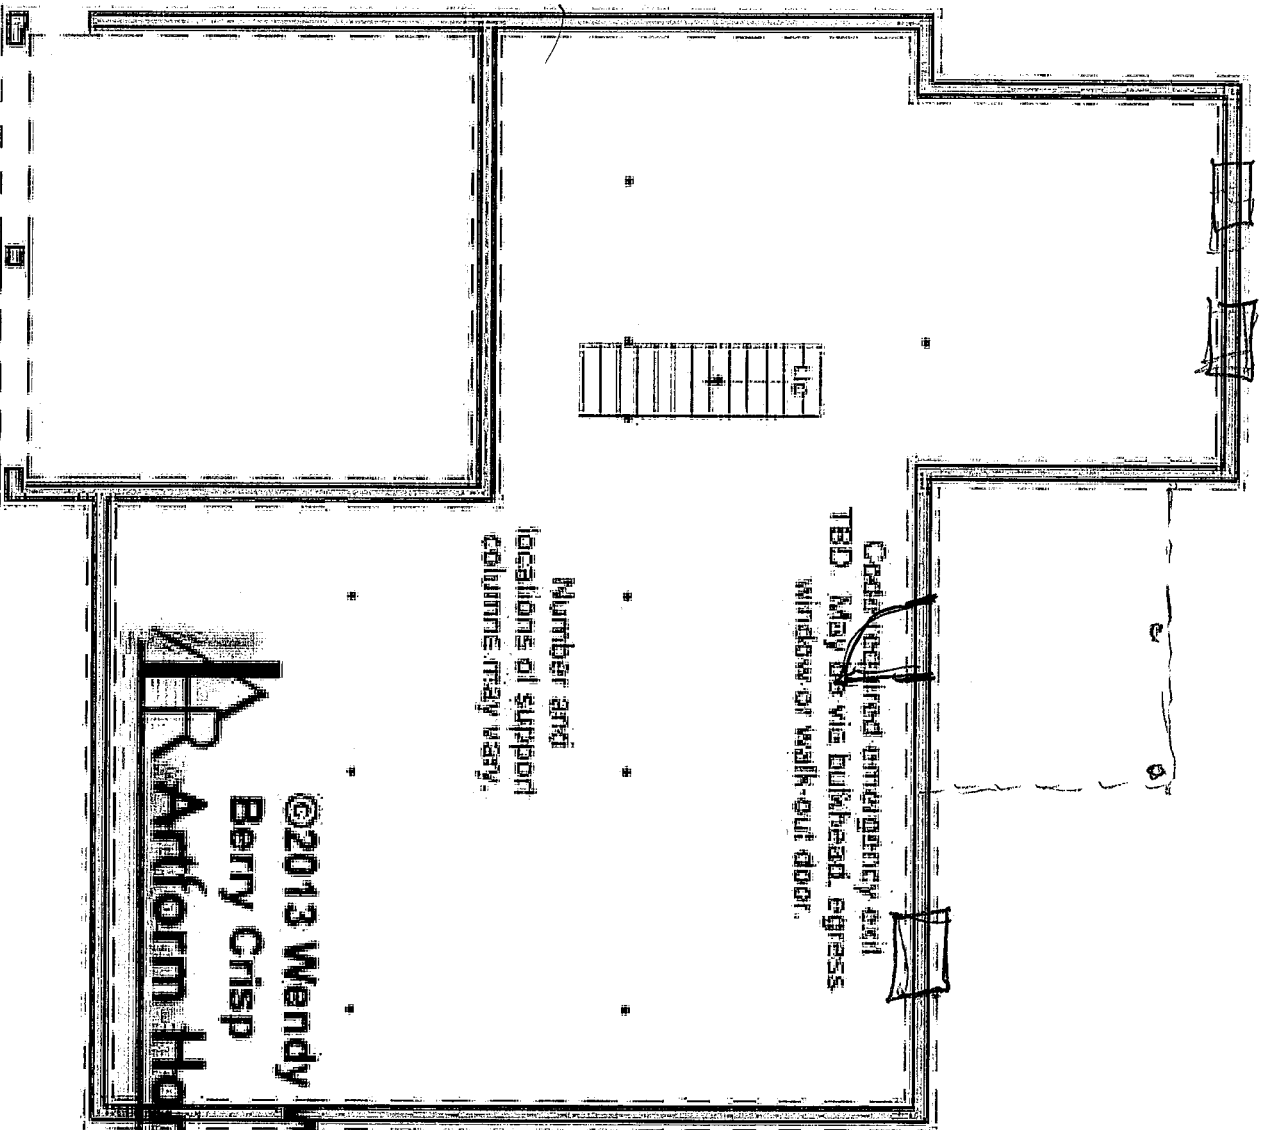

Number and
locations of support
columns may vary.

©2013 Wendy Melton
Berry Crisp
Artform Home Plans