




Rear Elevation

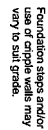

—Posts under deck can be solid 4x4 up to 48" in height, solid 6x6 PT for higher decks. Consult Airtorn for decks higher than 8 ft off grade.

Your use of these drawings constitutes an acceptance of responsibility as outlined in "Dear Code Officer" on the first page of these drawings, and on our web site: <http://www.actionmembers.com/Transcodeindex.aspx>


If you have any concerns or questions, please feel free to contact us. We are happy to clarify matters that fall within our scope, as listed on the first page. We can also often provide affordable support for issues that are your responsibility, such as energy design/tactics, or additional detailing.

Artform Home Plans

AFHP Design # 560.121 RL
 308-2010 Wendy Welton 603.431.9556
Laughing Daffodil Sun
 1 of 8 Rockingham Green

Lot 1: 6.2.2014 - Lot Change

slider door + windows
~ 6" x 12" to right

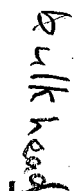


NOTE TO HOMEOWNER: These construction plans ARE NOT a part of your construction contract with your builder. Unless your P&S agreement specifies that they are, your P&S and these attachments (like the builder's specifications or a review set of this design) describe what you and your builder agreed this builder would build for you. We here at AtHome Firm Plans builder would like to see you and your builder to provide you with amenities like fireplaces and spa tubs. The contract between you and your builder governs.

١٥٢٧

ۛ
f

Mirror Image Plan

First Floor Plan

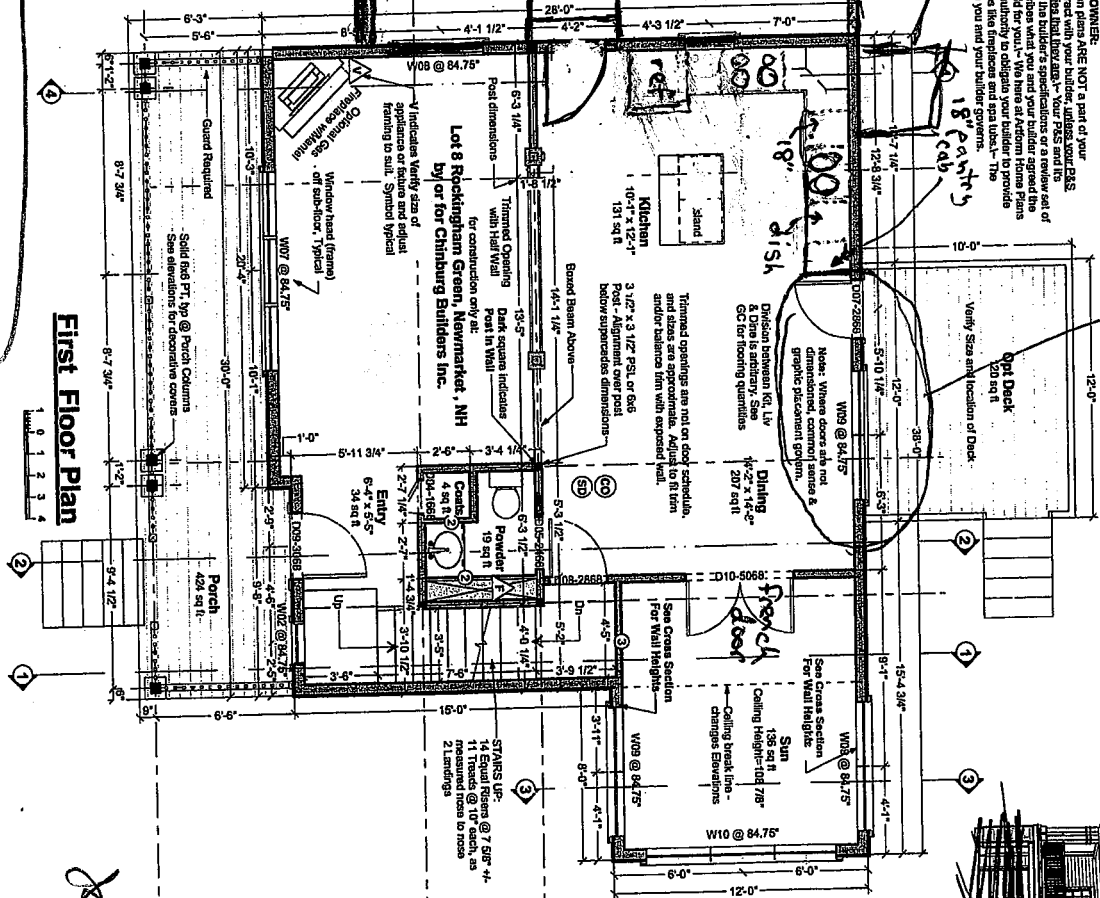

1. Room sizes (Section R304)
2. Ceiling Height (Section R305)

[illegible]

The bulletin can and should avoid information to this sort of effect: "In the history of our genetic thermal and metabolic data, we have found that the following information, additional information about doors and window sealing, temperature, etc., foundation data relative to fire rating, tempering, etc., foundation data relative to grading, and sometimes their chosen rating of basement grading, are not intended to be used without their information."

Please to feel free to call us with any questions. We can update our drawings and standard notes to address specific concerns, especially in jurisdictions where our clients building again.

DEAR EVERYBODY,

Now there comes a Copyright License is granted for a site construction use at Le Corbusier's Geneva, Switzerland for Children Builders Inc.. This is a License to Build, and requires a License to Modify, except as required to conform to code or third builder's owner responsibilities.

Permissible uses of these drawings:
 - All activities associated with construction at the listed
 - Pricing or preliminary discussions with zoning or code
 - Construction at other addresses, with prior notification
 Home Plans - just use the Contact form on the web site
www.africahomeplans.com/contact-256x

- **Not Permitted:**
 - Application for any permits or other approvals for construction other than the listed address, including but not limited to, zoning, conservation, or design review.
 - Modification of the basic design.

We can provide drawings suitable for use in obtaining zoning approvals without incurring the expense of a construction drawings. Contact us for more information. We want to allow reasonable use at reasonable costs. Just work, sit down, think, and we'll do it.


ALAN - CHICAGO

If you have any concerns or questions, please feel free to contact us. We are happy to clarify matters that appear, as listed on the first page, we can also provide the support for issues that are your responsibility as a company, or additional detailing as necessary.

HR Artform Home Plans

AFHP Design # 580.121 KL
© 2008-2010 Wendy Wolton 603.431
Laughing Daffodil Sun

Lot 8 Rockingham Green Newmarket, NH	14-21-07 unless noted otherwise / P/ton @ 1:1 PDF created on: 6/22/2014, drawn by ACI	Revised Cans
R1: 6.2.2014 - Lot Change		

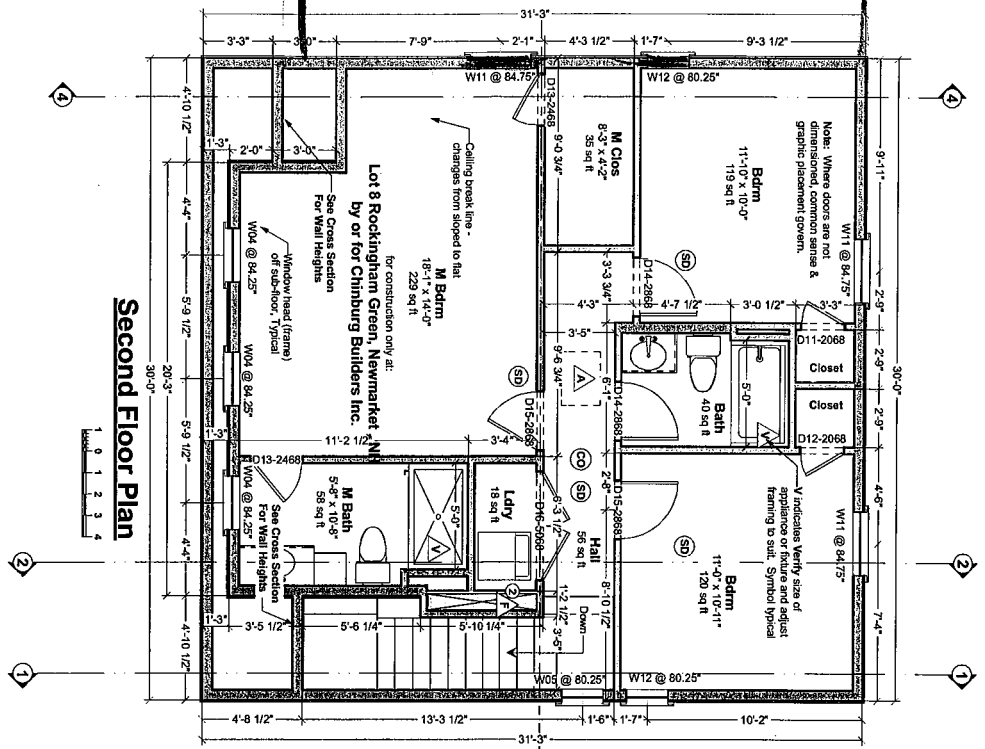

Second Floor Plan

NUMBER	QTY	FLOOR	SIZE	DOOR SCHEDULE	TYPE	COMMENTS
D01	1	0	180.0	180.0	84.0	GARAGE
D02	1	0	28.66	R EX 32"	80"	HINGED
D03	1	0	28.66	L IN 32"	80"	HINGED
D04	1	1	10.68	R IN 32"	80"	HINGED
D05	1	1	24.68	R IN 28"	80"	HINGED
D06	1	1	24.68	R EX 32"	80"	HINGED
D07	1	1	28.66	L IN 32"	80"	HINGED
D08	1	1	28.66	L IN 32"	80"	HINGED
D09	1	1	50.68	L IN 60"	80"	DOUBLE HINGED
D10	1	1	20.68	R IN 24"	80"	HINGED
D11	1	1	20.68	R IN 24"	80"	HINGED
D12	1	1	20.68	R IN 24"	80"	HINGED
D13	1	1	28.66	L IN 32"	80"	HINGED
D14	1	1	28.66	L IN 32"	80"	HINGED
D15	1	1	50.68	L IN 60"	80"	DOUBLE HINGED
D16	1	1	50.68	L IN 60"	80"	DOUBLE HINGED

NUMBER	QTY	HEIGHT	WIDTH	EGRESS	TYPE	COMMENTS
W01	1	27.12	41.12	YES	AWNING	PARADISE
W02	1	27.12	41.12	YES	AWNING	PARADISE
W03	1	27.12	41.12	YES	AWNING	PARADISE
W04	1	27.12	41.12	YES	AWNING	PARADISE
W05	1	27.12	41.12	YES	AWNING	PARADISE
W06	1	27.12	41.12	YES	AWNING	PARADISE
W07	1	27.12	41.12	YES	AWNING	PARADISE
W08	1	27.12	41.12	YES	AWNING	PARADISE
W09	1	27.12	41.12	YES	AWNING	PARADISE
W10	1	27.12	41.12	YES	AWNING	PARADISE
W11	1	27.12	41.12	YES	AWNING	PARADISE
W12	1	27.12	41.12	YES	AWNING	PARADISE


Door & Window Notes

1. Rated Doors: Provide fire rated and/or self-closing doors where required by local codes or local authorities.
2. Trimmed Openings: Trimmed openings not shown on schedule. See Plan.
3. Window Tempering: Provide tempered windows where required by local codes or local authorities. Tempering column provided here for convenience. Windows have not been reviewed for tempering requirements.
4. Window RO's: 1/4" or 1/2" on each of 4 sides allowed for window RO's, typical. Review framing size vs RO size. Adjust per manufacturer's requirements and/or builder preference.
5. Egress Windows: Provide minimum egress door or window meeting egress requirements in basement in each sleeping room. In each potential sleeping room, and other local code required by local code. In stairs required by local code. Note that egress windows are required by manufacturer as meeting IRC 2006 egress requirements typically need to be ordered with specific hardware. Emergency Escape Window Sizes (Section R310.1.1, R310.1.2, R310.1.3 and R310.1.4). WM also comply with NFPA 101.
6. Basement Windows: Add basement windows as required to meet state or local code requirements, including but not limited to egress and light/ventilation.
7. Skylights: Skylights are not shown on this schedule, but may be required. Consult builder and/or see floor plan.
8. Minimum window sill height: IRC 2006 and later requires that upper floor window sills be 24" from floor.

Handwritten initials 'HC'.

Dimensions measured to face of framing, typ.

Roof Plan

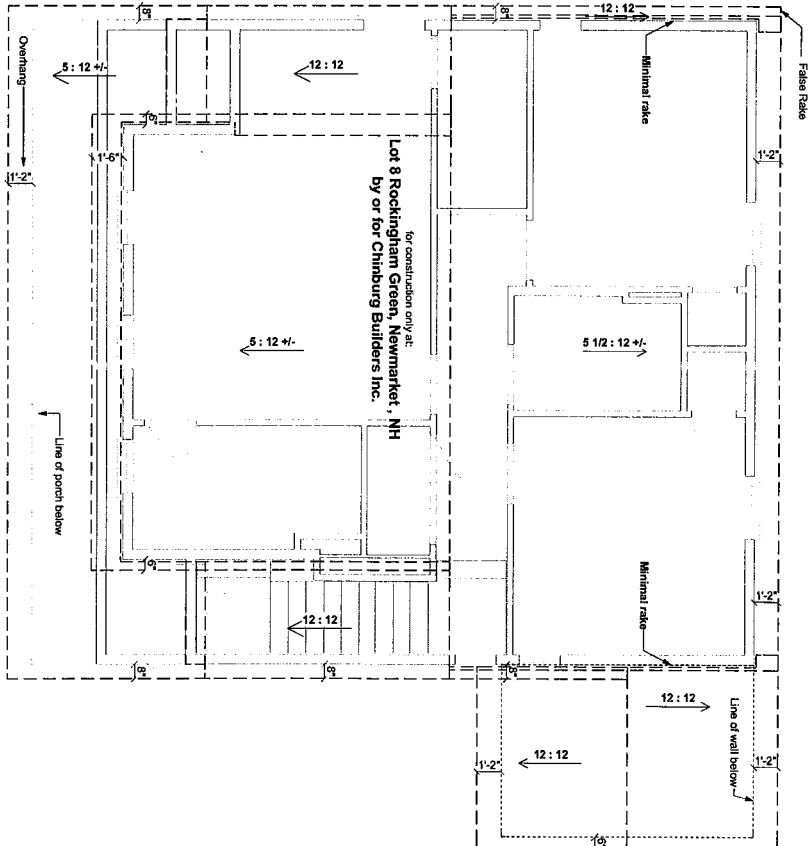

Form for Arform Home Plans, including contact information and a section for the user to provide feedback or comments.