


427.124.v10 EL Cotton Ranch

First Floor

	Large casement windows		Baths	
			2.5	
Future	0 SF	1	0	
Apt	0 SF	0		
Total	2159 SF	3	2	
Ceiling Height				
Shown	8'-0"			
Possible*	8'-0"			

* See Major Change information on plan page for cost

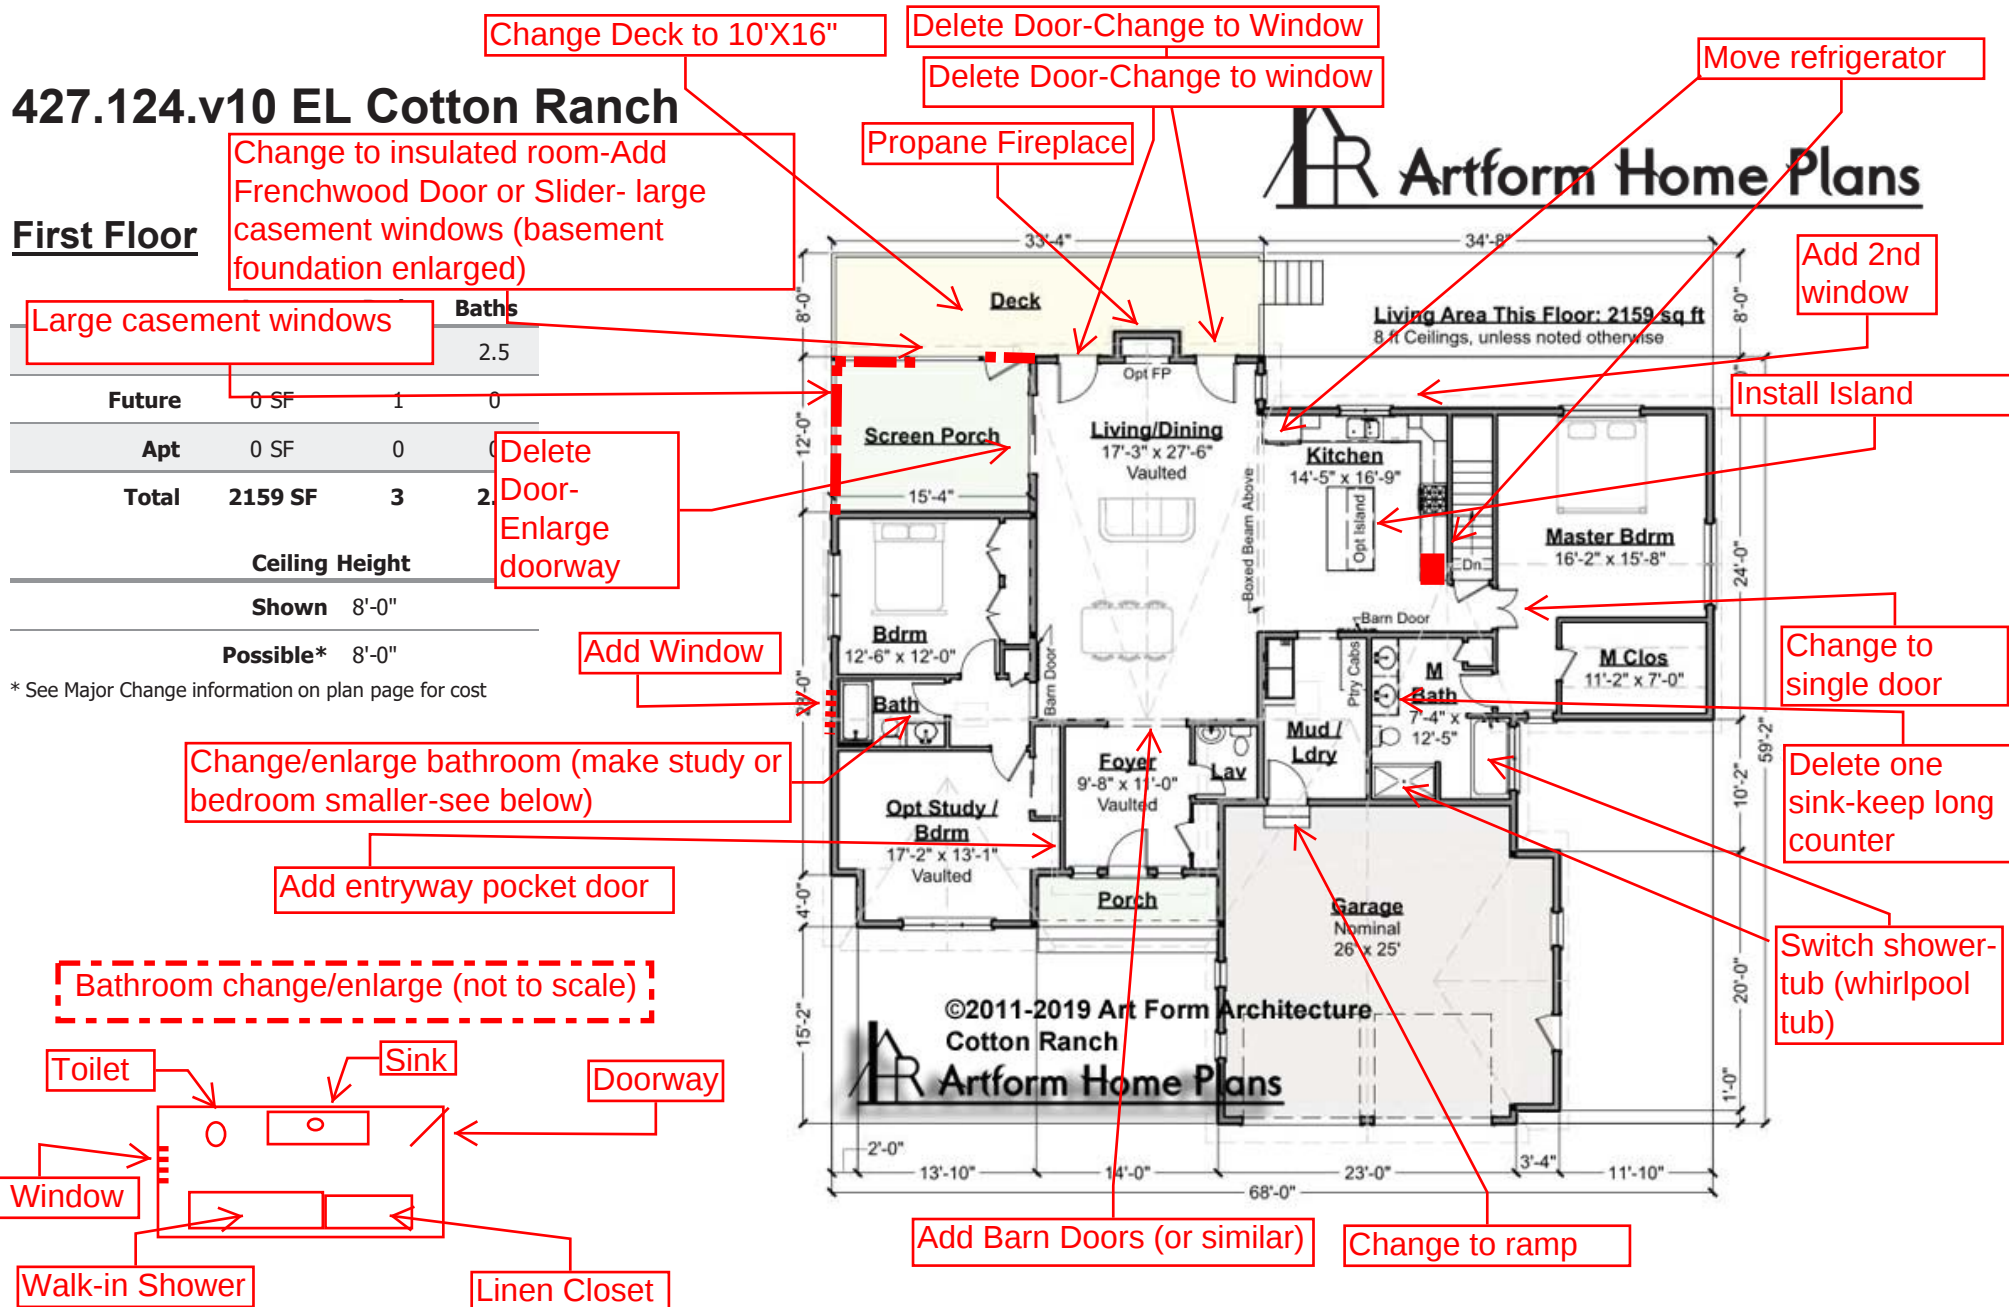

Use of this document is governed by our **Terms and Conditions**, found on our website:
<http://www.artformhomeplans.com/TermsConditions.a5w>

© 2011 Art Form Architecture, Inc. ALL RIGHTS RESERVED.
You may not build this Design without purchasing a License to Build (as defined in our Terms). Unauthorized changes are not permitted and violate copyright laws, which provide substantial penalties for infringement.

Some features show are optional. Your Purchase & Sale Agreement governs, whether items are labeled "optional" in this document or not.

We are not responsible for typographical errors.