

Raspberry Crisp  
Re-use


LOT 122 Baden Hill Estates  
W1/4 Ford

6" Fixed Transom Window  
Centered in room Approx 16" TALL  
20

14 X 20 PT Deck

Living Area - First Floor: 1802 SI

Decks, Steps or Patio TBD

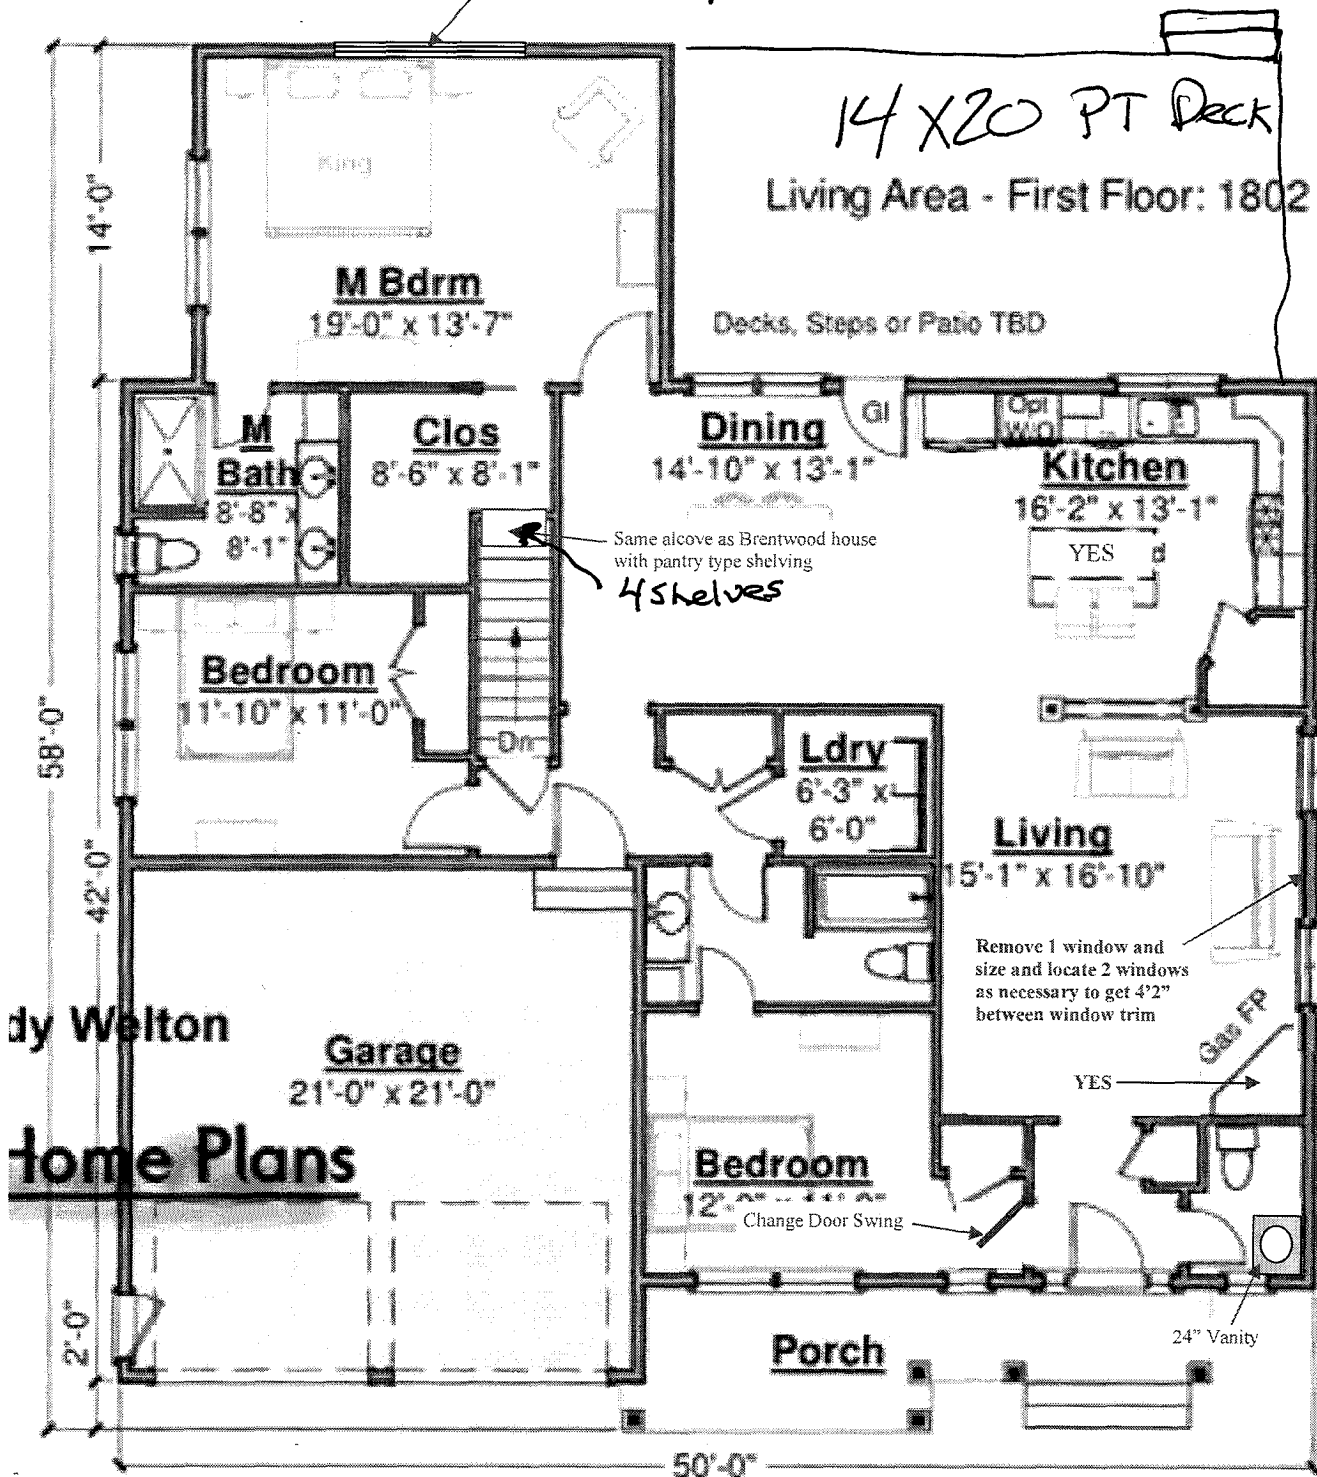

dy Welton

Home Plans