




PLAN 194.001 COCO RANCH Petite
Reverse PLAN GARAGE LEFT / Kneewall BACK

- ① NO WALKUP ATTIC -
- ② WINDOW GRILL PATTERN Prairie Style top SASH only
- ③ FRONT GABLE WINDOW to be GABLE Vent.
- ④ Vault Ceiling over Living + Kitchen
- ⑤ ADD Fireplace Logged into Bed 3 closet
- ⑥ ~~B~~ Create Trash Bin Storage in Garage over Staircase
- ⑦ Double Swingout Door in Place of Slideby closet
- ⑧ Add Hallway Linen outside Bed 3 AS SHOWN
- ⑨ Awning Windows in Place of DH BACK MBR + MBATH.
- ⑩ Relocate Stove to Rear wall, Appliances AS MARKED
- ⑪ Trash Compactor in Island AS SHOWN


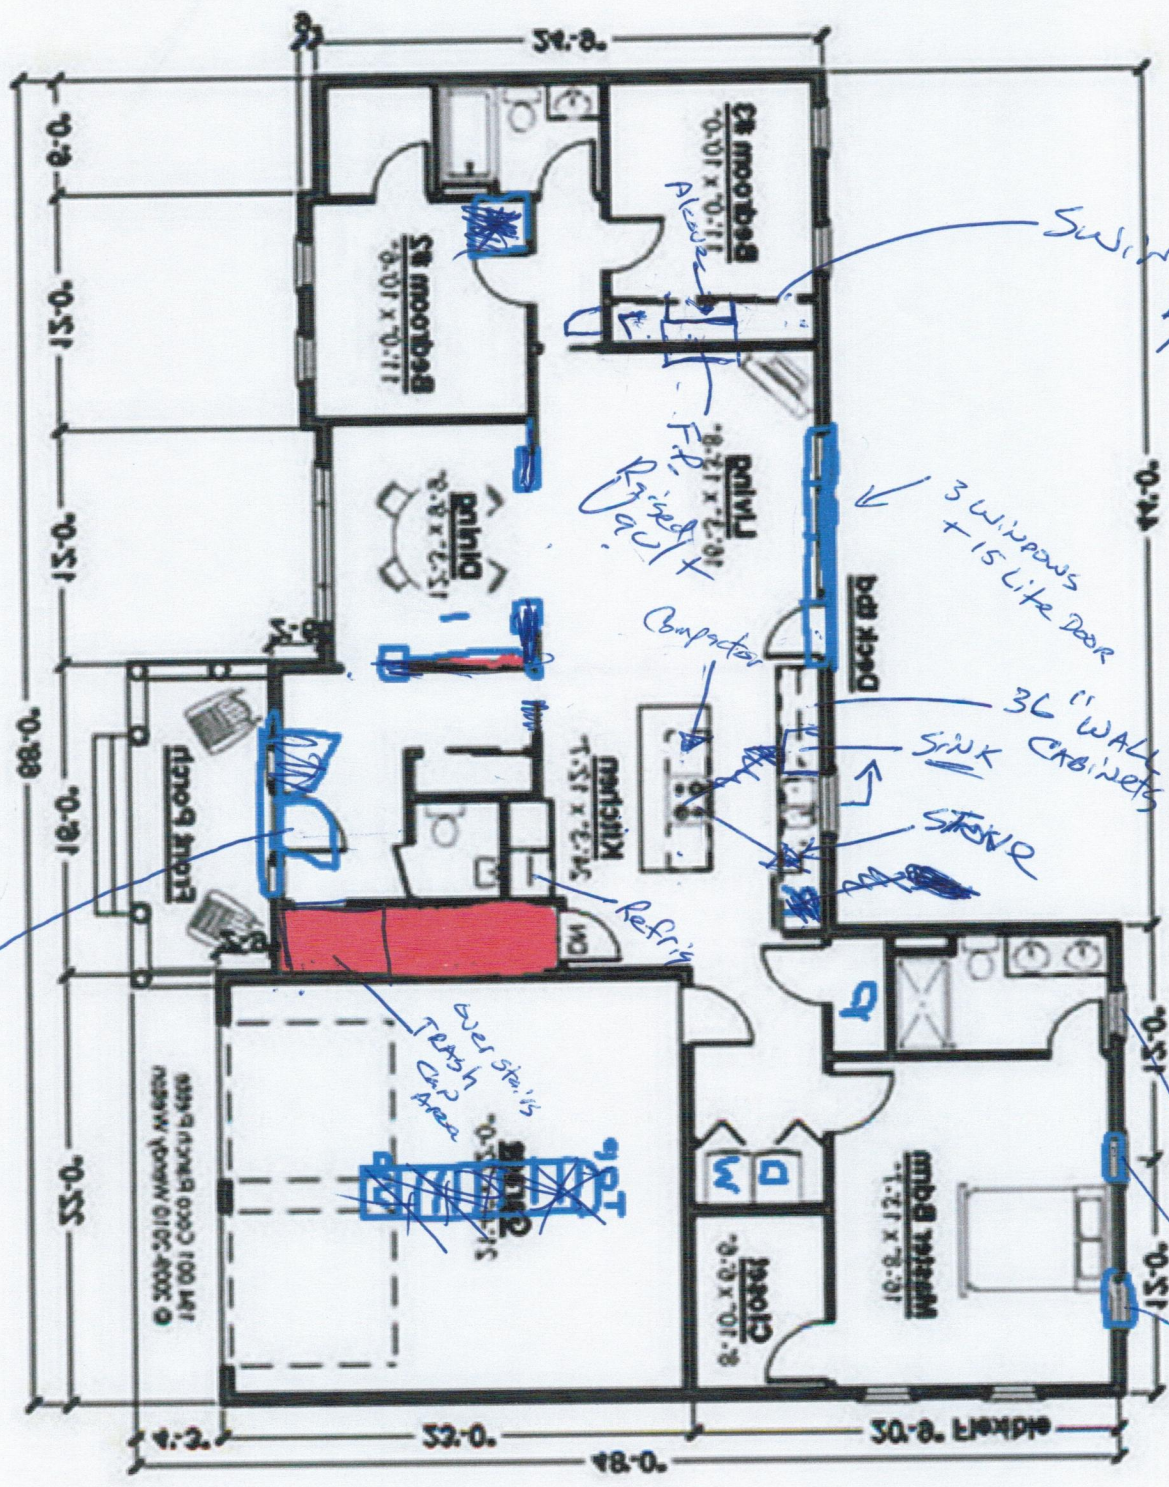


* Mirror Image *

2

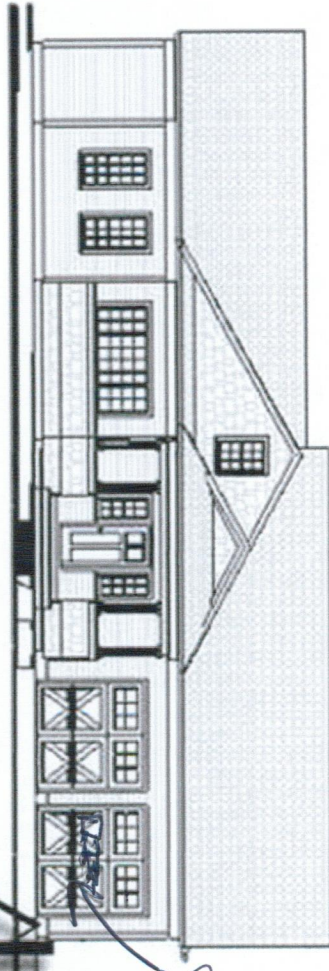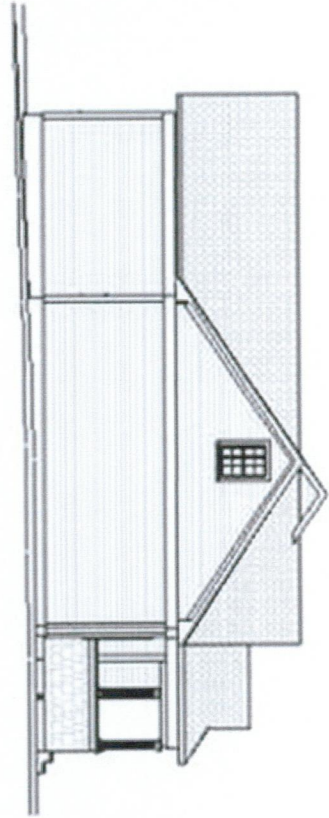

paneled
door

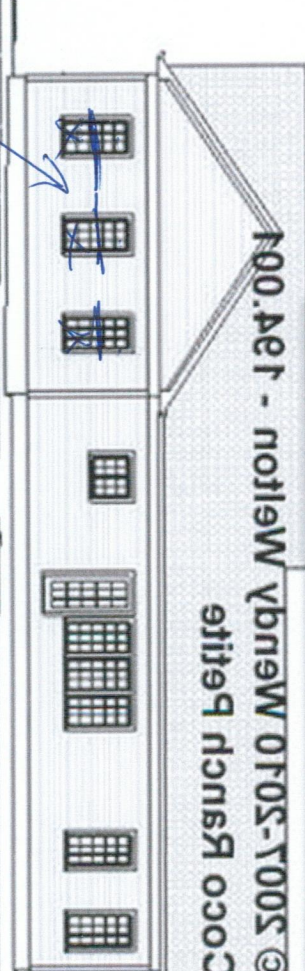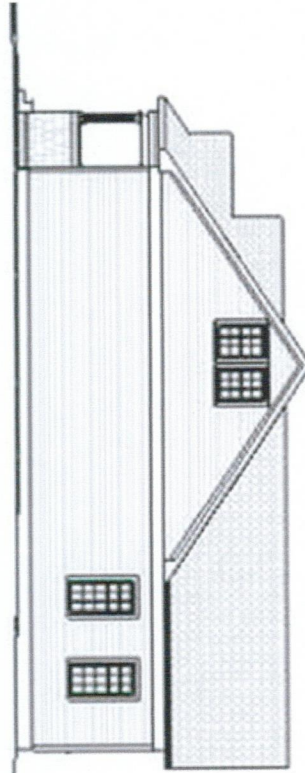

small front porch

© 2005-2010 Wendy Wilson

Coco Ranch Petite

Awning
windows

Pair of
Mississippis
top

