
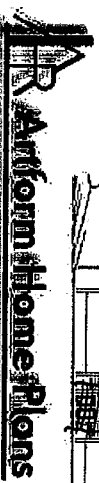
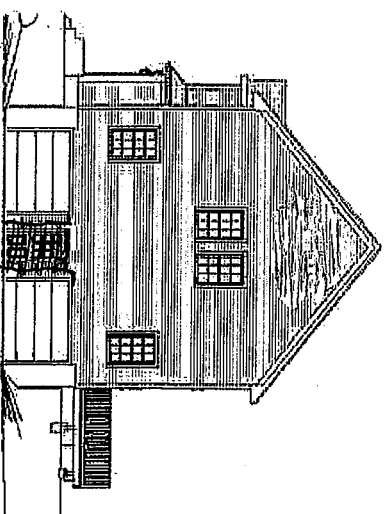
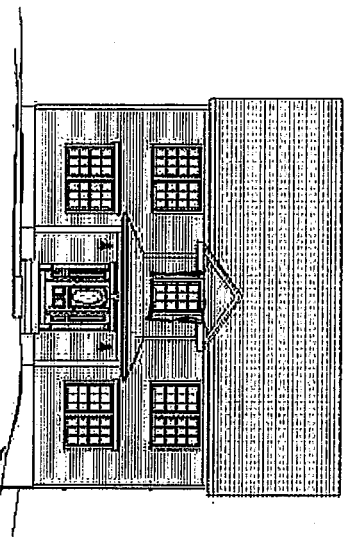


Duke Solo

287.001



© 2013 Art Form Architecture, Inc. All Rights Reserved . <http://www.artformhomeplans.com>

Elevations

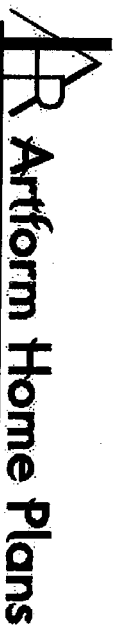

© 2010 Wendy Welton
287.001-R Duke

XC
X SD
X S.H

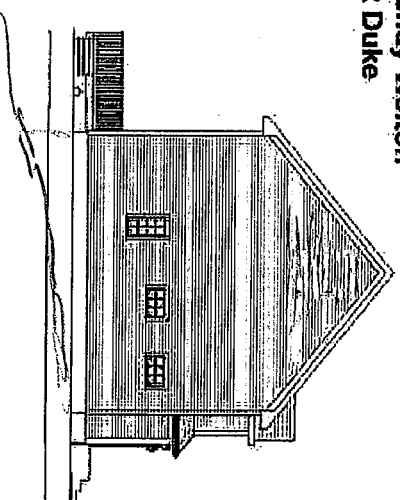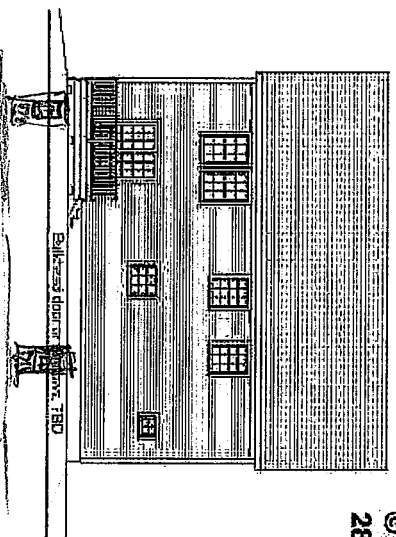

Duke Solo

287.001

© 2013 Art Form Architecture, Inc. All Rights Reserved . <http://www.artformhomeplans.com>

First Floor

Living Area: 1123 SF

Bedrooms: 1

Bathrooms: 1.0


Ceiling Height Shown: 8'-0"

Ceiling Height Possible*:

* -- Increasing ceiling height requires a Major Change.



© 2010 Wendy Welton
287.001-R Duke

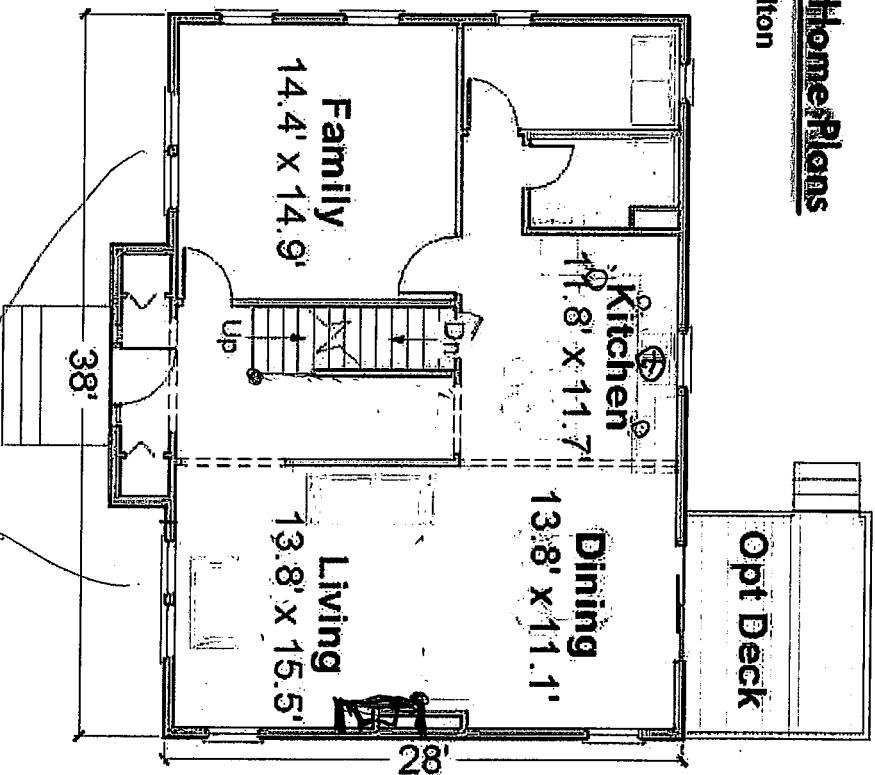

x KC
x S.D
x S.H

Duke Solo

287.001

© 2013 Art Form Architecture, Inc. All Rights Reserved . <http://www.artformhomeplans.com>

Second Floor

Living Area: 1080 SF

Bedrooms: 3

Bathrooms: 2.0

Ceiling Height Shown: 8'-0"


Ceiling Height Possible*: 8'-0"

* -- Increasing ceiling height requires a Major Change.

Artform Home Plans

© 2010 Wendy Welton
287.001-R Duke

8'-0"
5'-0"
5'-0"
S-H

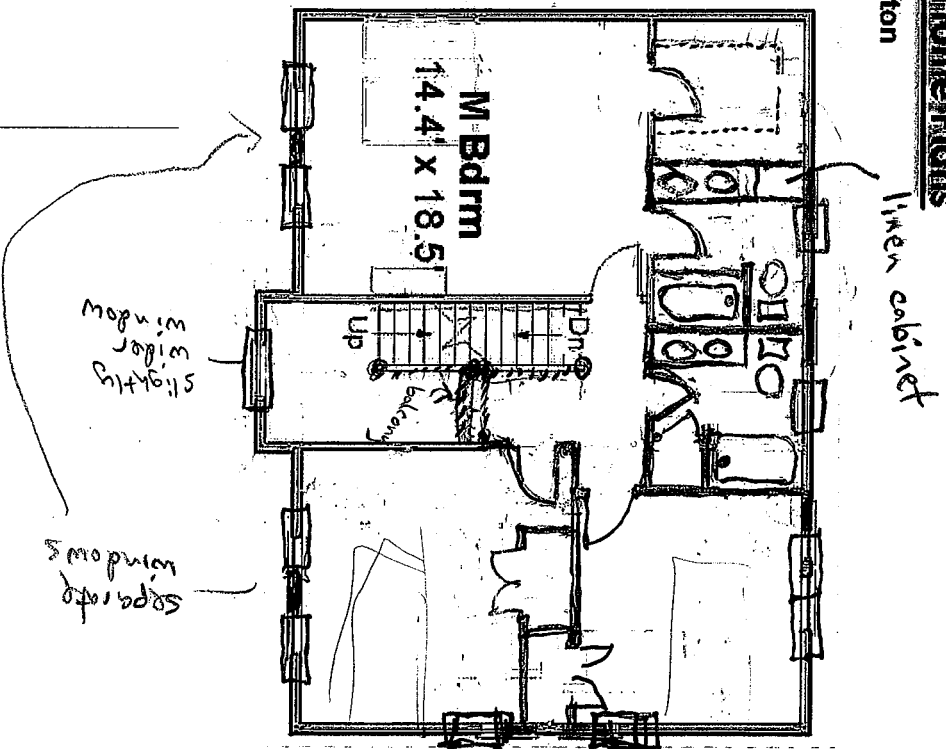

Artform Home Plans

Duke Solo

287.001

© 2013 Art Form Architecture, Inc. All Rights Reserved . <http://www.artformhomeplans.com>

Basement Floor

Living Area: 0 SF

Bedrooms: 0

Bathrooms: 0.0

Ceiling Height Shown: 7'-8"

Ceiling Height Possible*: 7'-8"


* -- Increasing ceiling height requires a Major Change.



© 2010 Wendy Welton
287.001-R Duke



x KC
x S.O
x SH

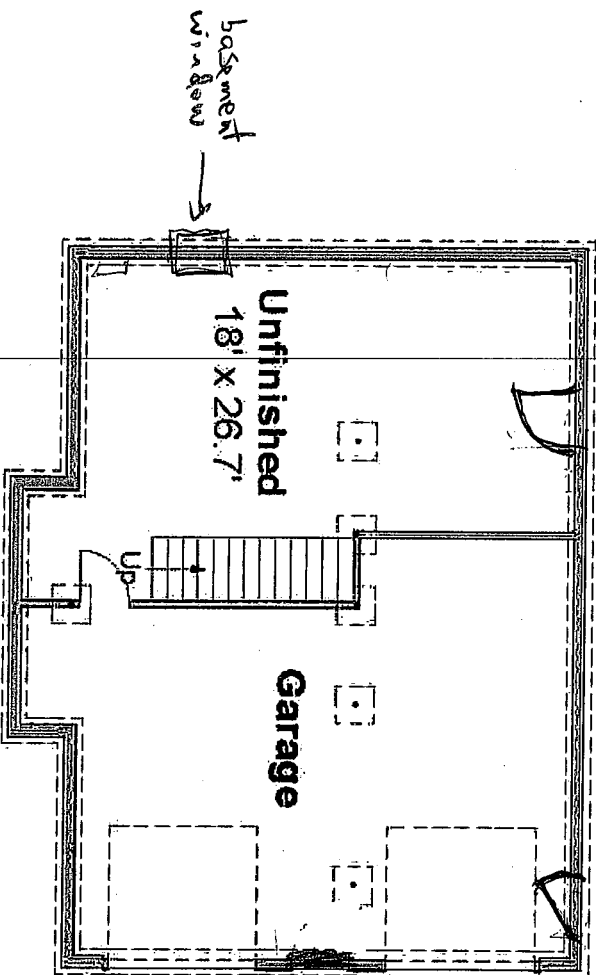

Duke Solo

287.001

© 2013 Art Form Architecture, Inc. All Rights Reserved . <http://www.artformhomeplans.com>

Third Floor

Living Area: 643 SF

Bedrooms: 2

Bathrooms: 0.0

Ceiling Height Shown: 8'-0"

Ceiling Height Possible*: 8'-0"


* -- Increasing ceiling height requires a Major Change.



© 2010 Wendy Welton
287.001-R Duke



X $\frac{K}{S.D.}$
X
X 8.4

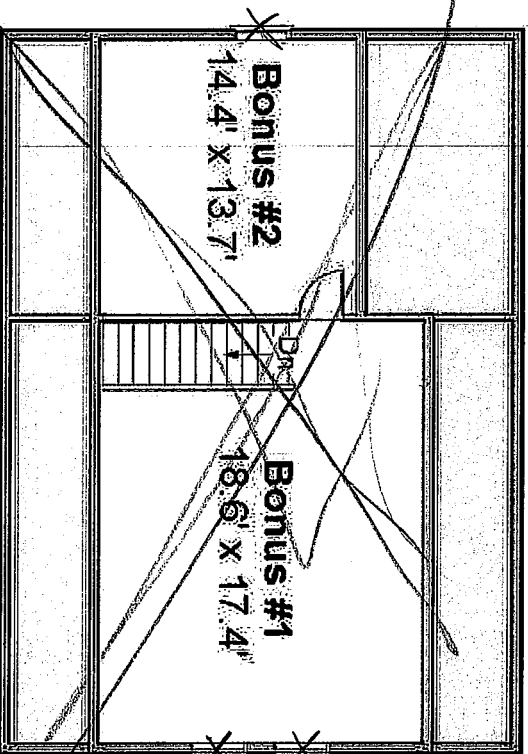

No attic stairway.
Typical access panel in second
Floor ceiling to meet fire code.