





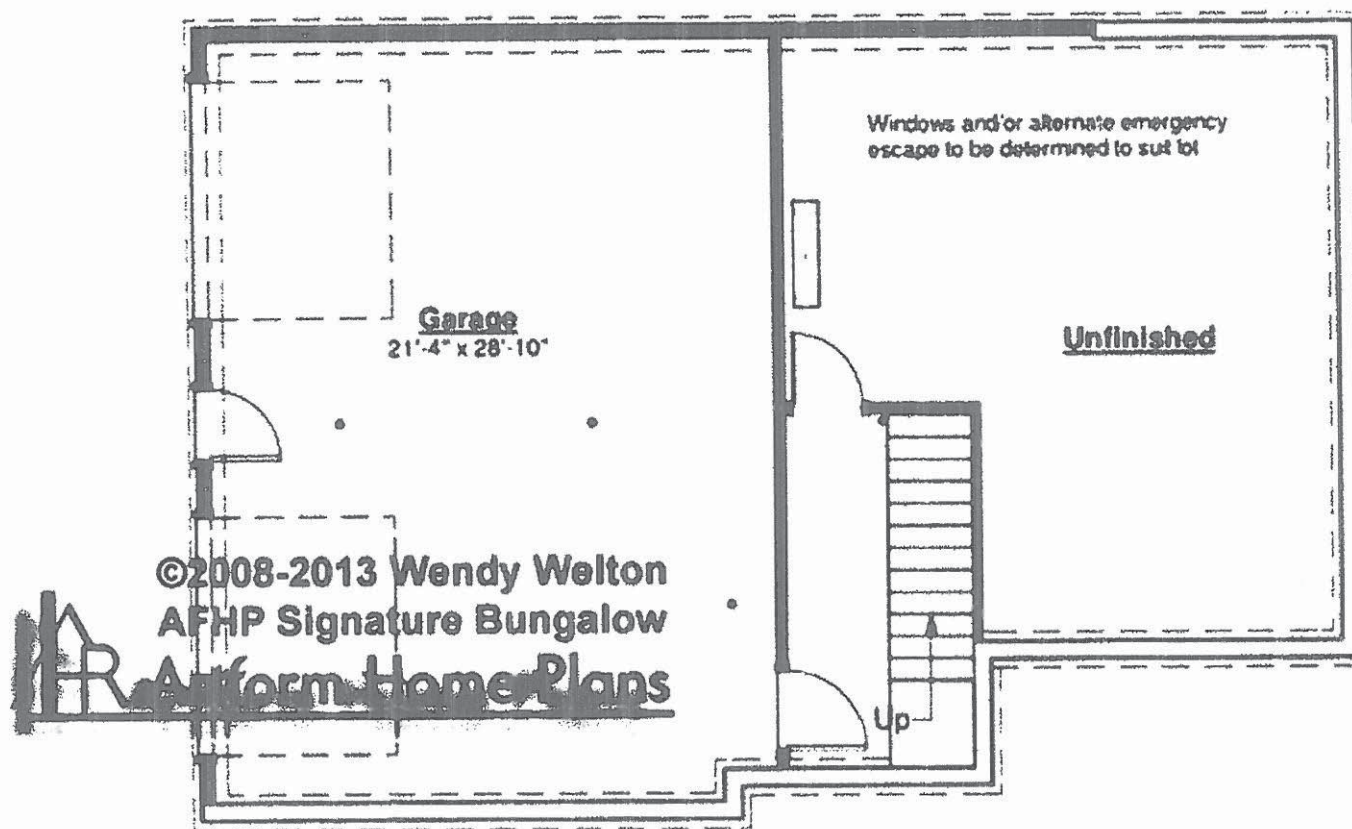

©2008-2013 Wendy Welton  
AFHP Signature Bungalow

 **Affirm Home Plans**

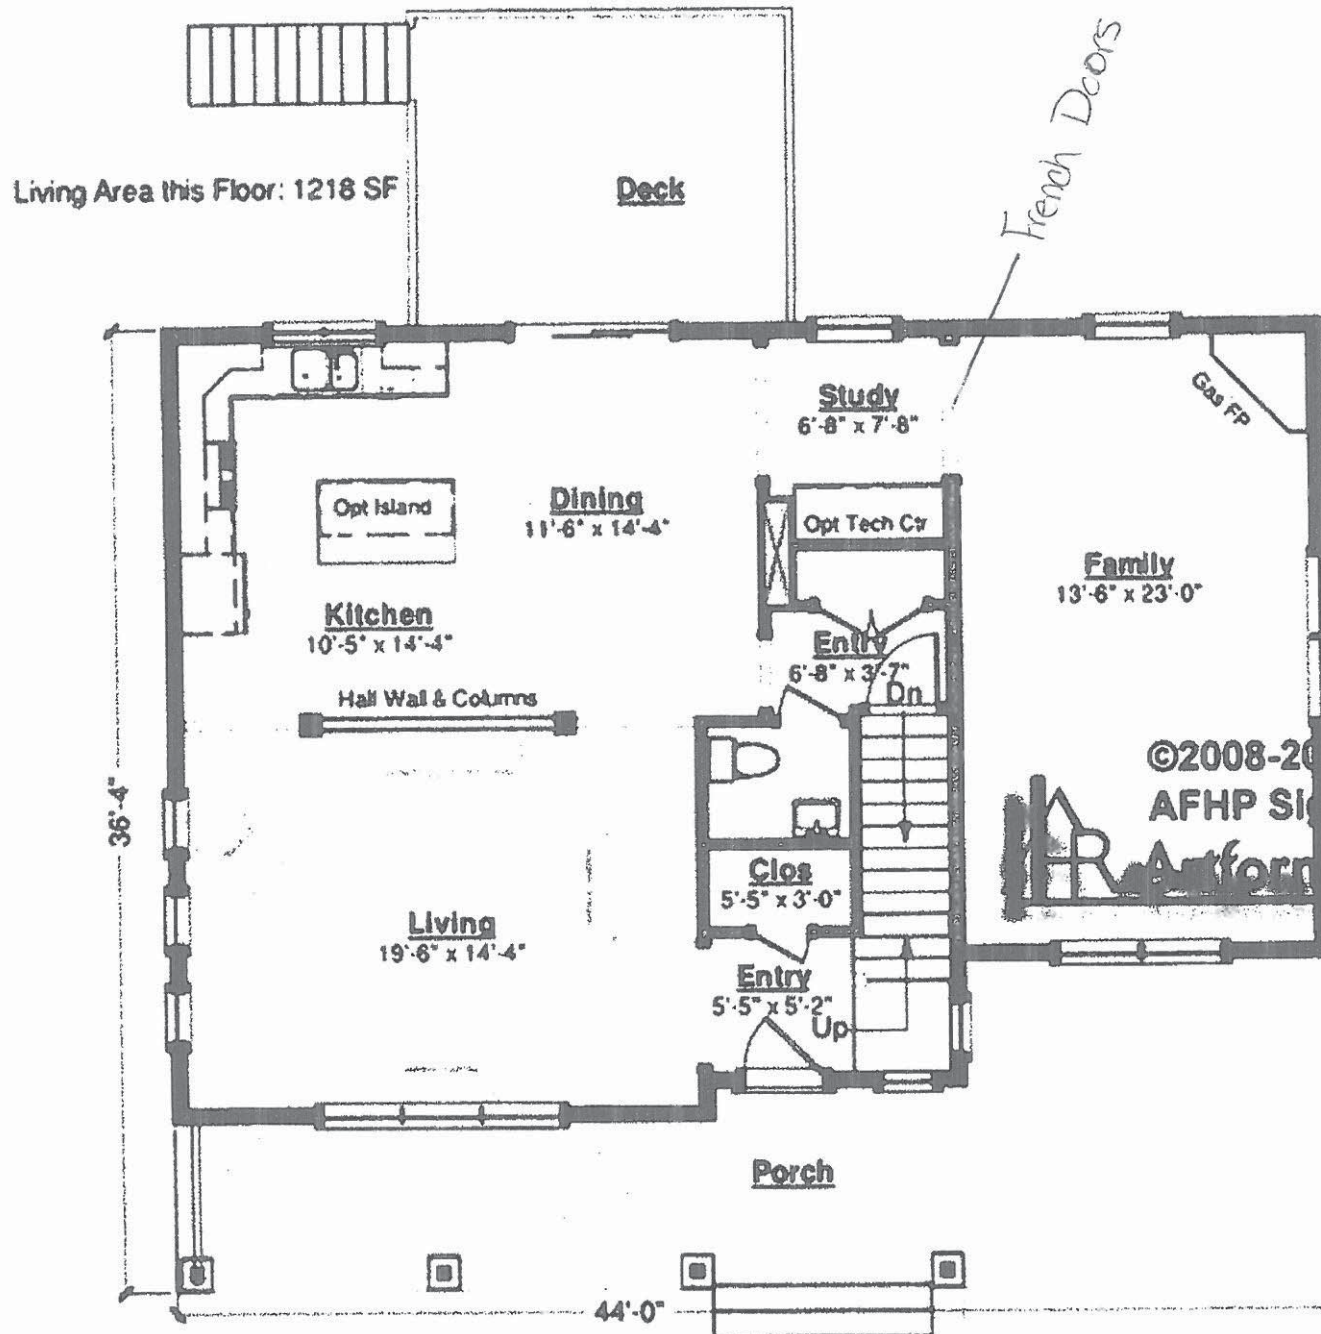

©2008-2013 Wendy Welton  
AFHP Signature Bungalow  
 Antiform Home Plans



