



WP CLARK & SONS
HOMEBUILDERS, INC.
Contact us at
(P) 207.650.0766
(F) 207.655.3754

Fax

To: <i>Holley</i>	From: <i>Bill Clark</i>
Fax: <i>1-866-441-4959</i>	Pages:
Phone:	Date:
Re:	cc:

Urgent For Review Please Comment Please Reply Please
Recycle

• **Comments:**

Please see me to see STEVE
WITH ANY QUESTIONS. 207 939 0353
MASTER BED PLAN SKETCHED ON FOUNDATION
PLAN.

Thanks Bill

May Tulip

318.005

© 2013 Art Form Architecture, Inc. All Rights Reserved . <http://www.artformhomeplans.com>**First Floor**

Living Area: 1014 SF

Bedrooms: 0

Bathrooms: 0.5

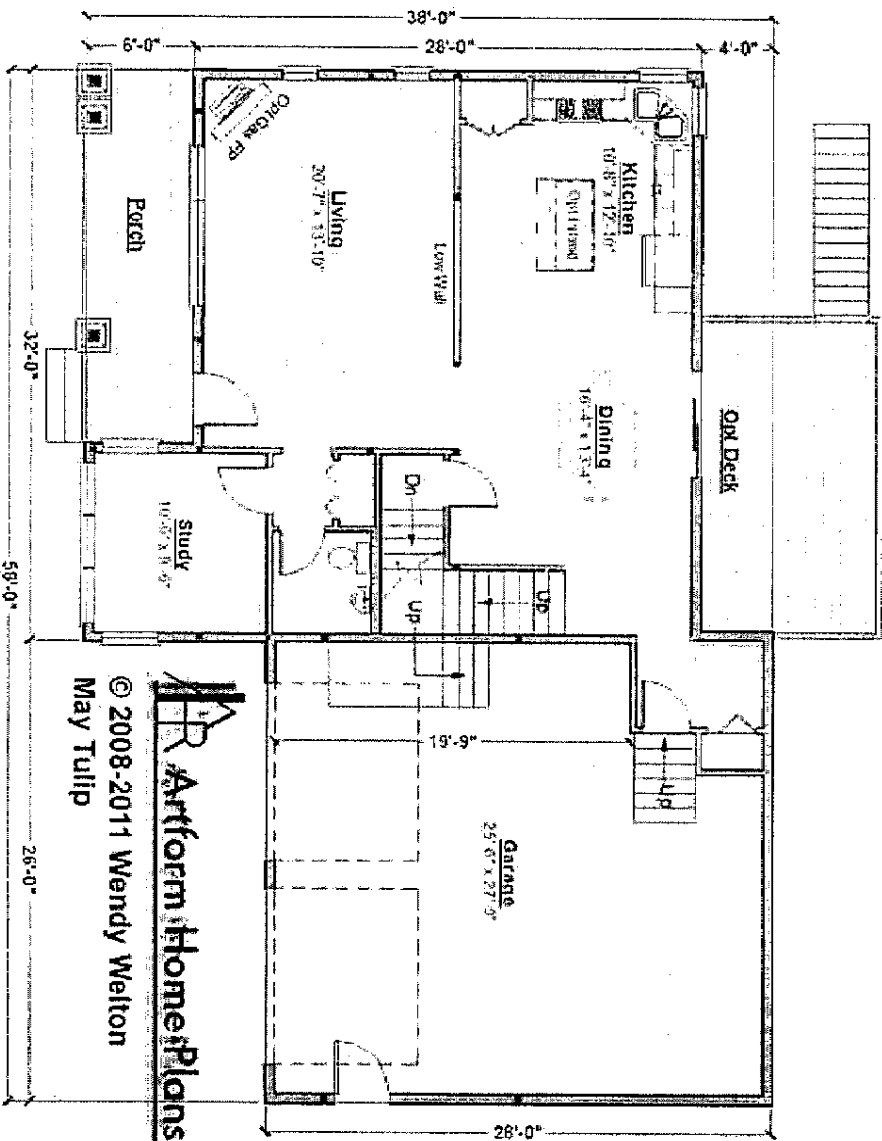
Ceiling Height Shown:

~~8'-0"~~

9'-0"

Ceiling Height Possible*:

* -- Increasing ceiling height requires a Major Change.

Change ceiling height to 9'-0" 9' FT**Artform Home Plans**

© 2013 Art Form Architecture, Inc. All Rights Reserved . <http://www.artformhomeplans.com>

* -- Increasing ceiling height requires a Major Change.

