


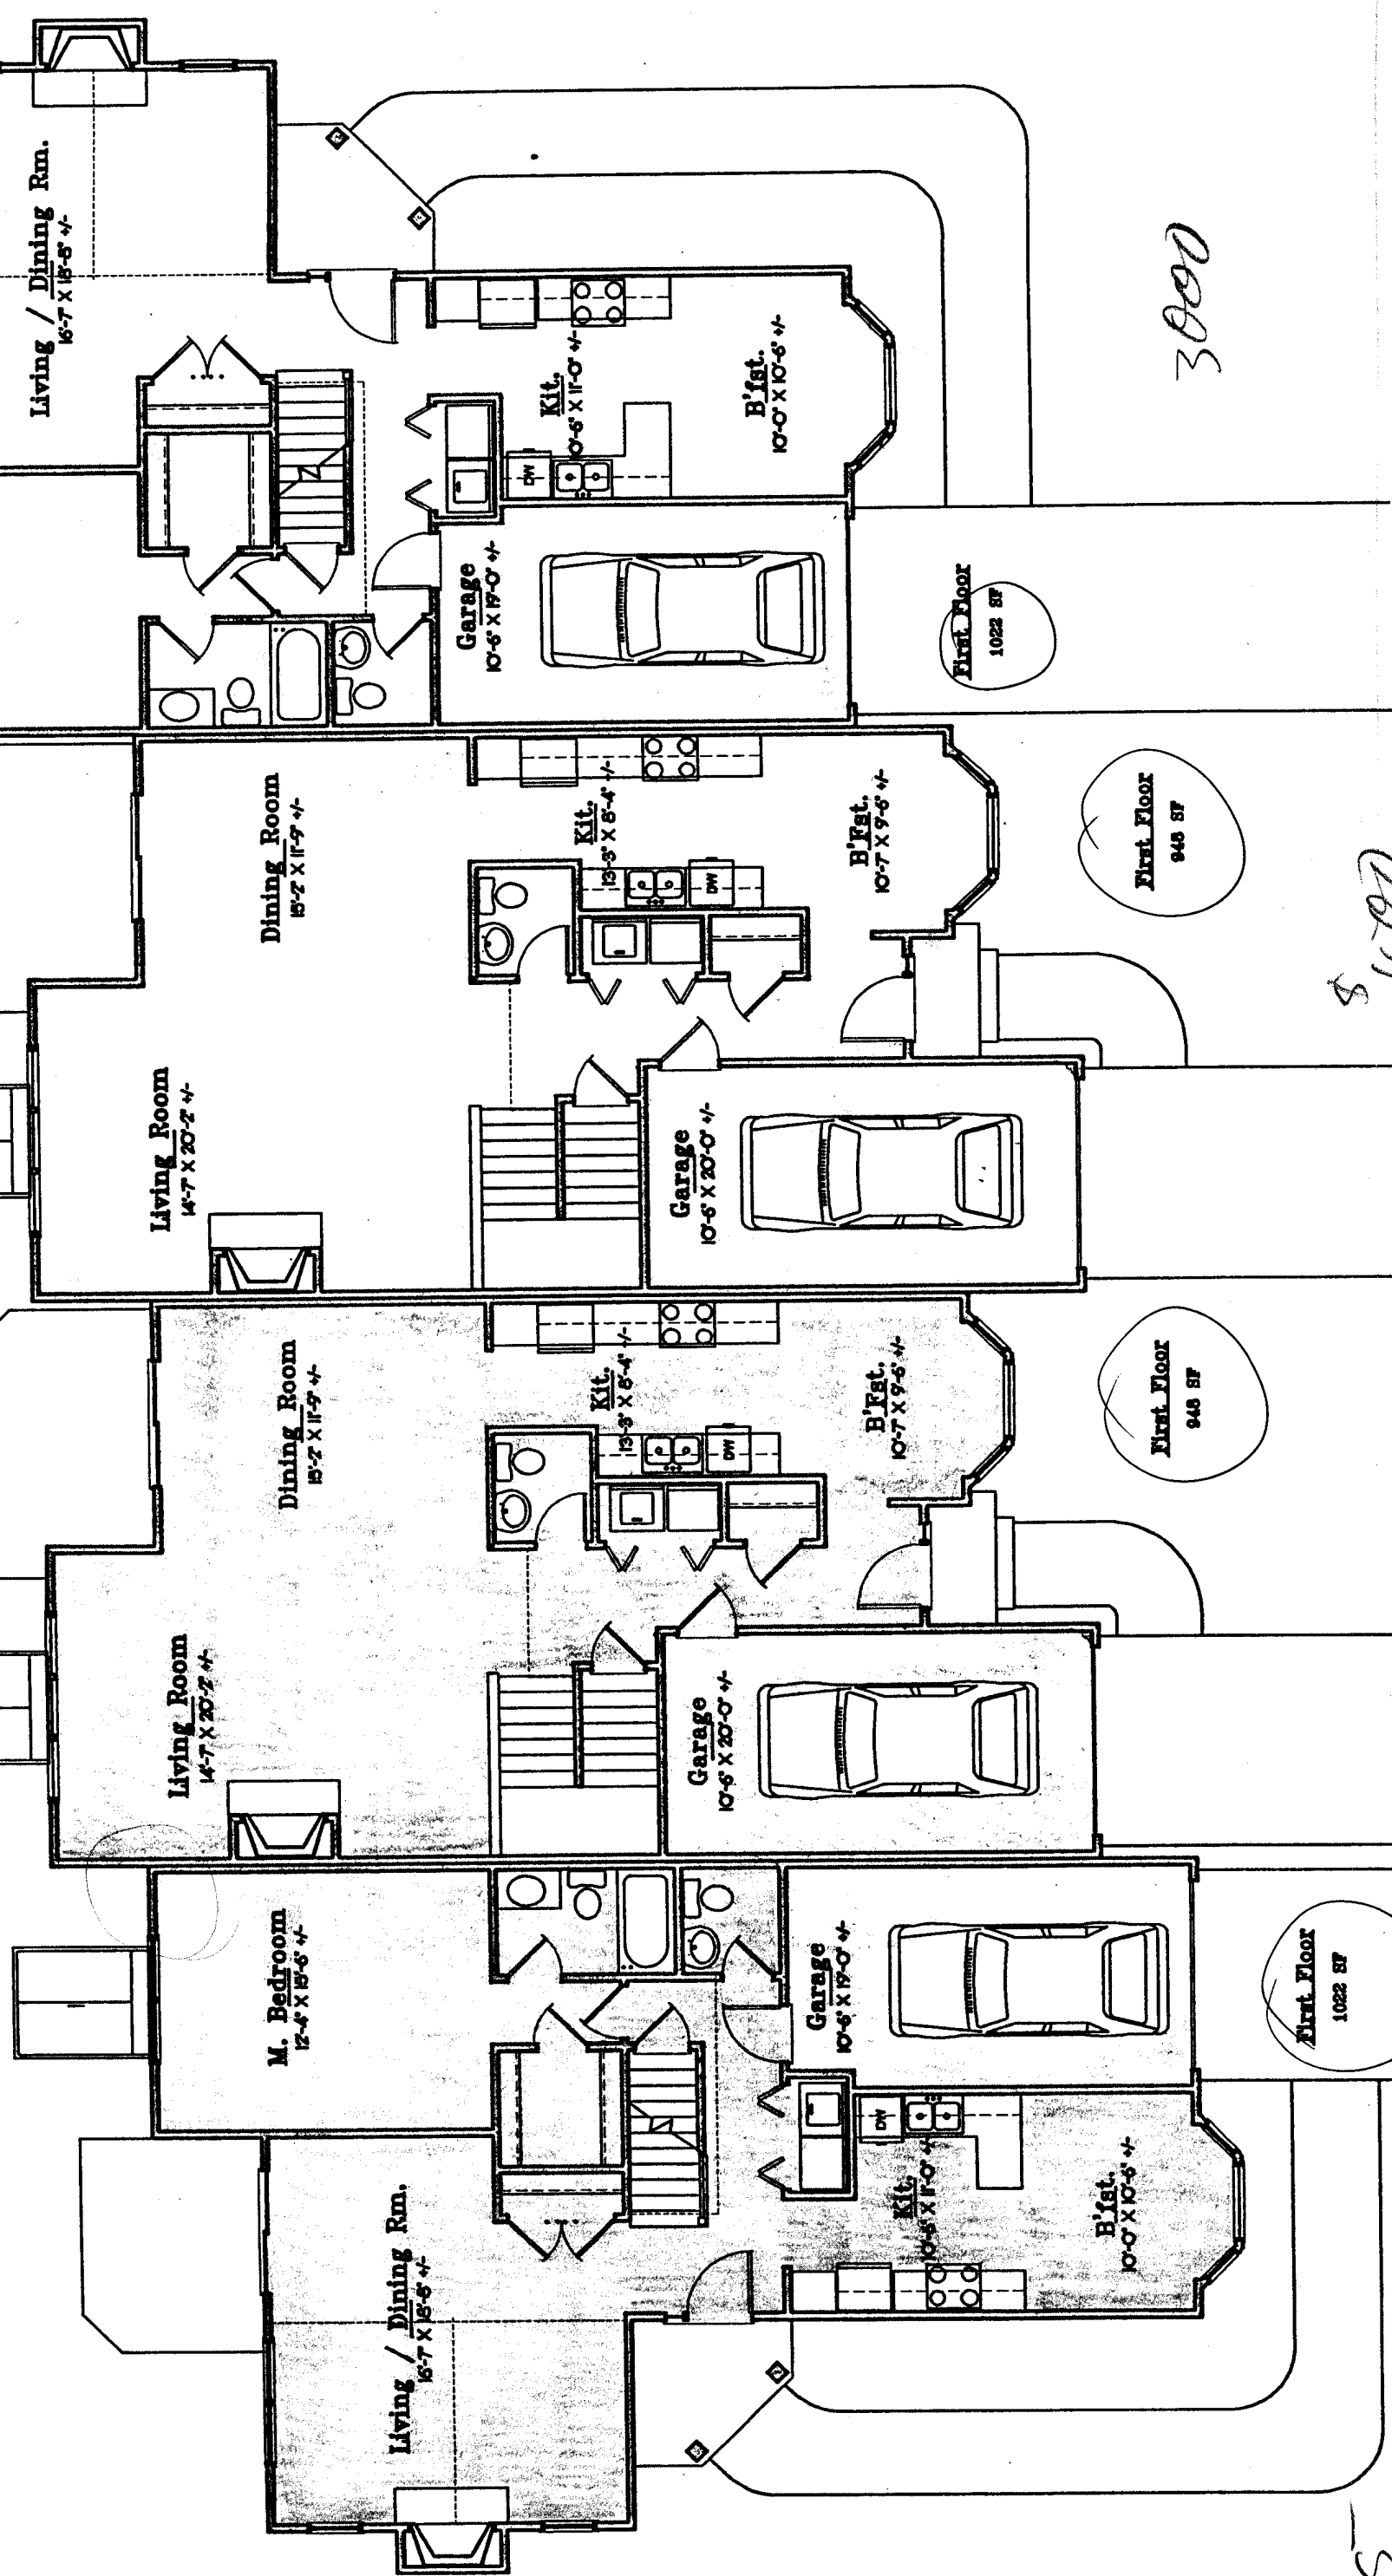

9400 C'S
 2500 DES
 7/11/19
 \$12K

\$1500

9400R F1251
 2006
 \$1200

F-125
 12-15K QUA
 15-18K QUA
 1875
 DE-USE
 12-21K DEN BLDG

3000

First Floor
1022 SF

First Floor
948 SF

First Floor
948 SF

First Floor
1022 SF