





for construction only at  
**19 Linden, Exeter, NH**  
 by or for Chinburg

**Opt Deck**

attachments (like the builder's specifications or a review set of this design) describes what you and your builder agreed the builder would build for you. We here at Ariform Home Plans do not have the authority to obligate your builder to provide you with amenities like fireplaces and spa tubs. The contract between you and your builder governs.

Verify Size and location of Deck

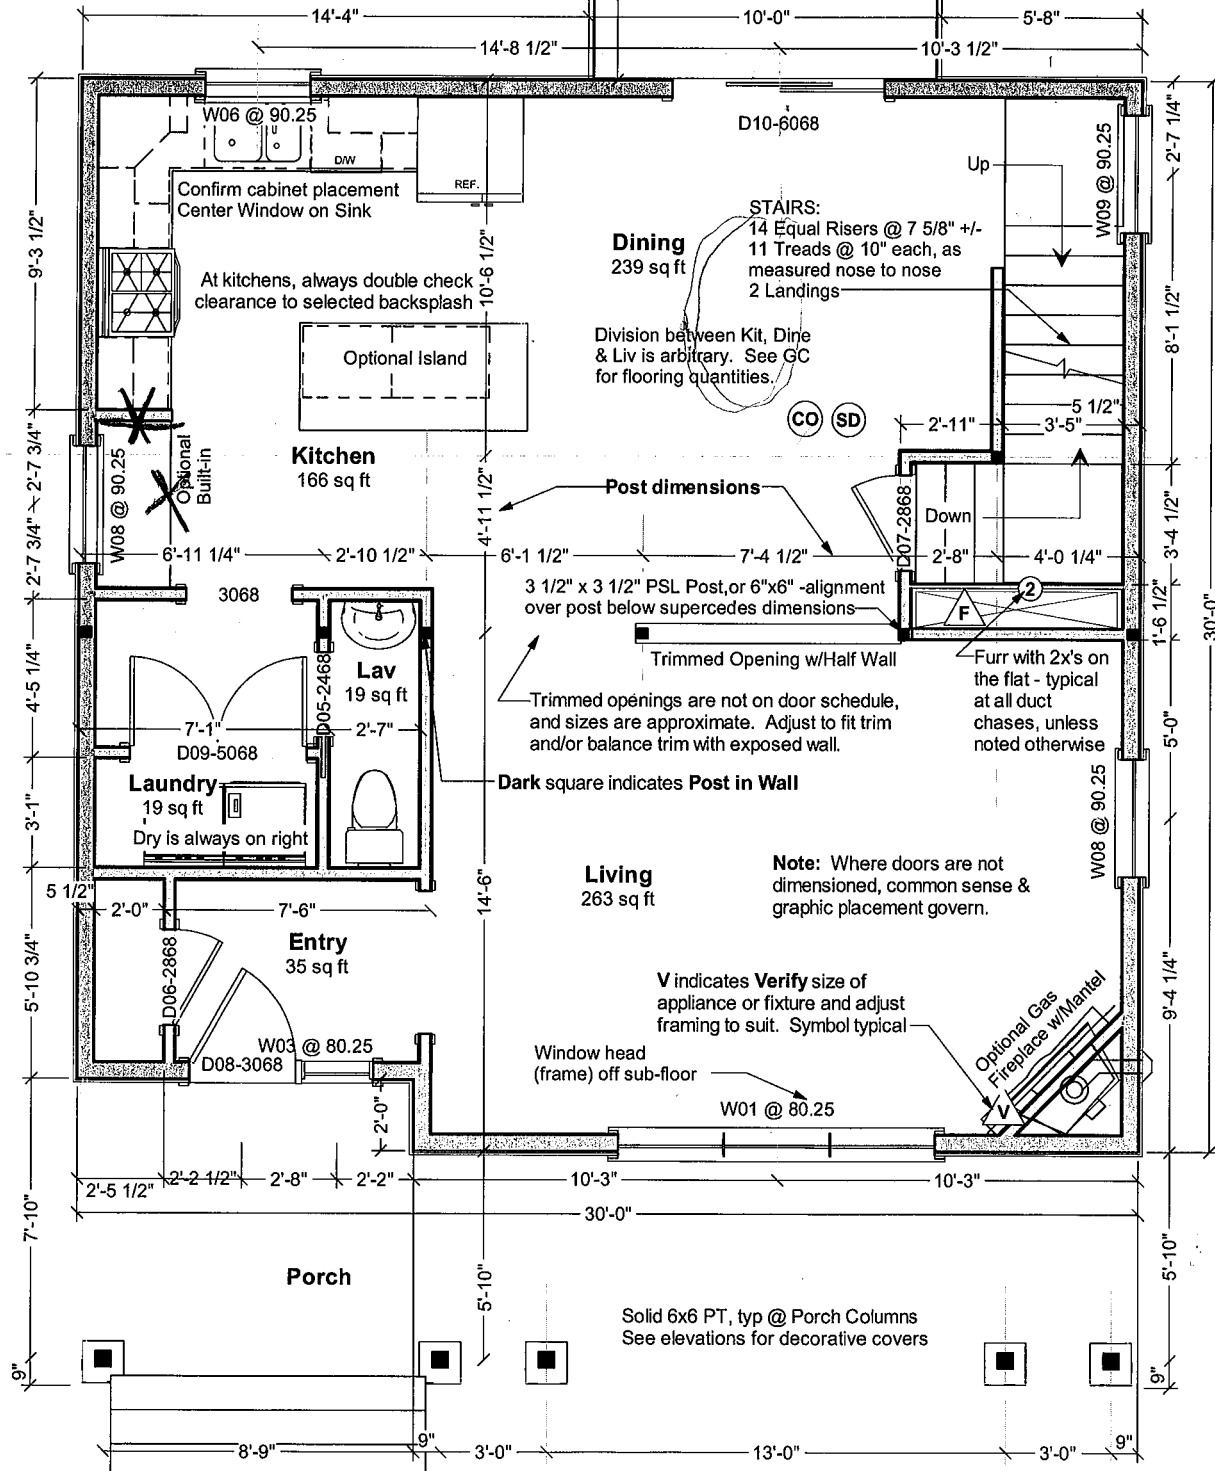

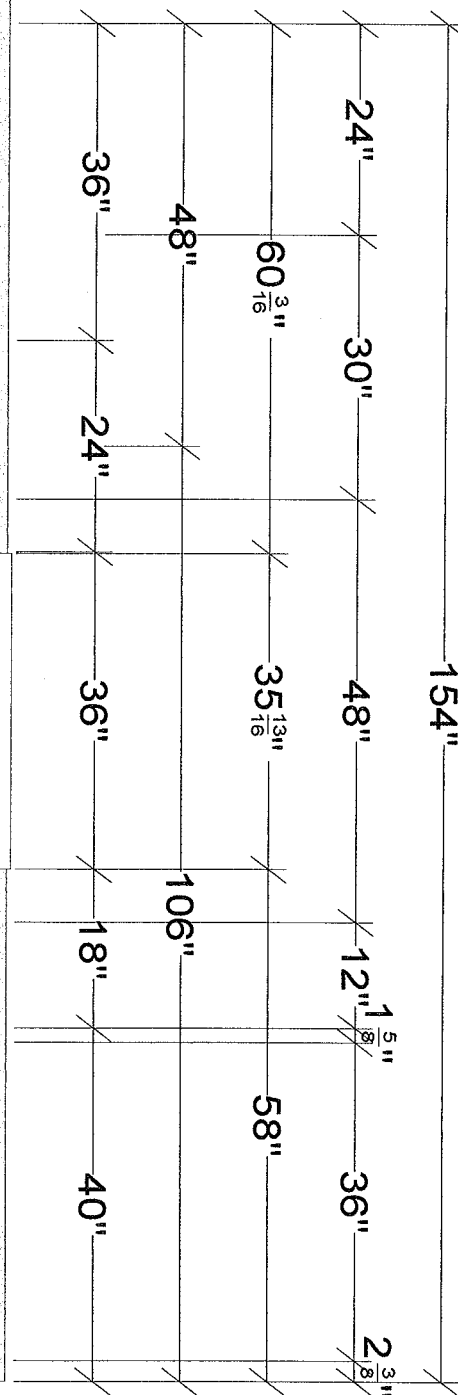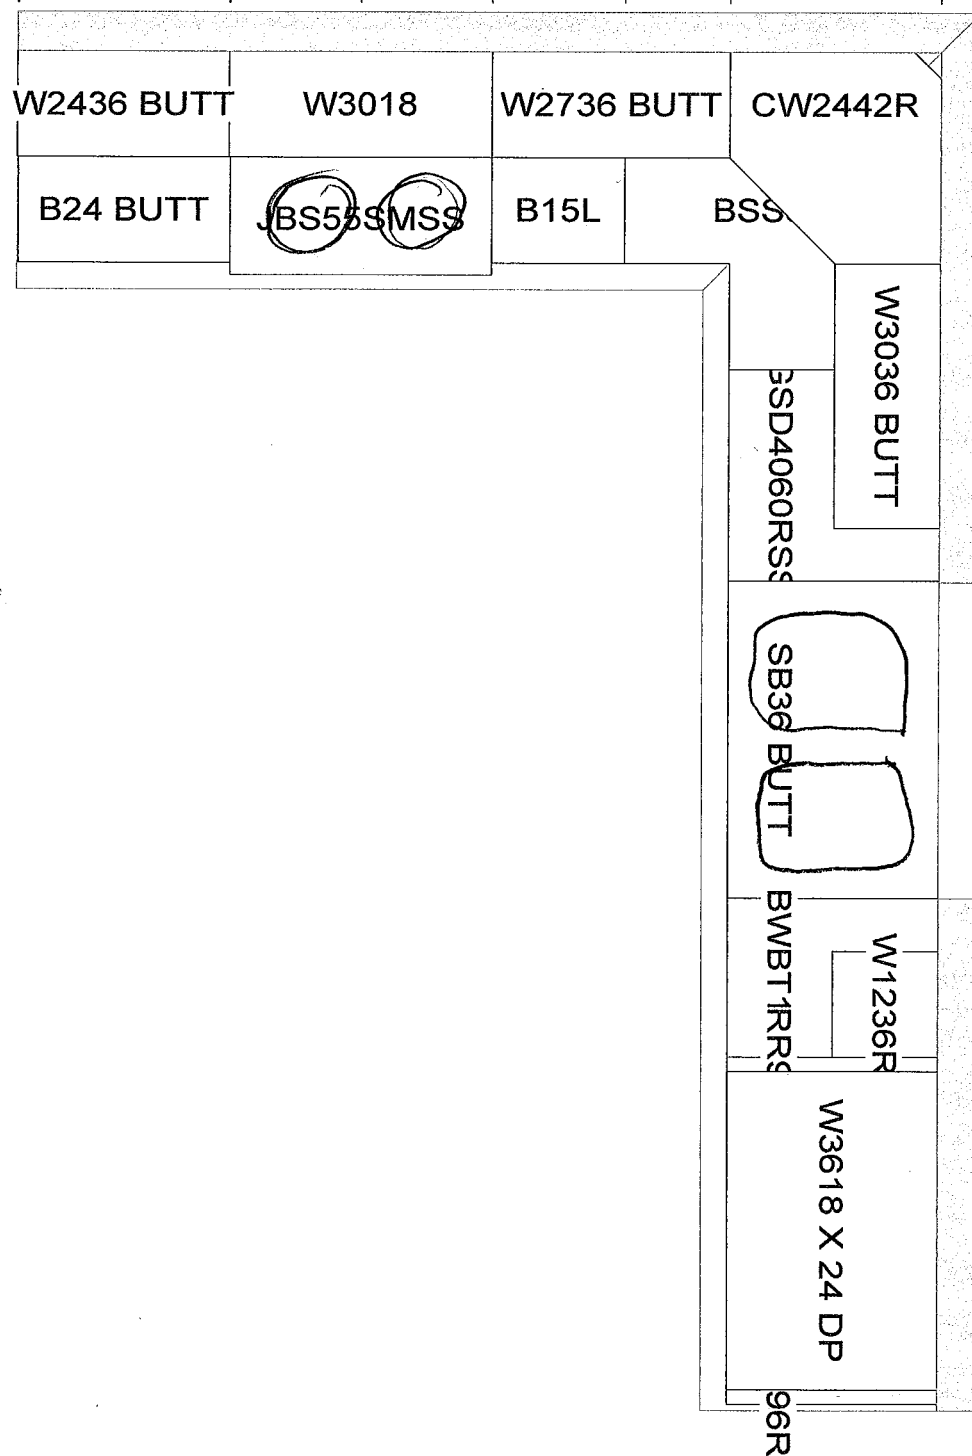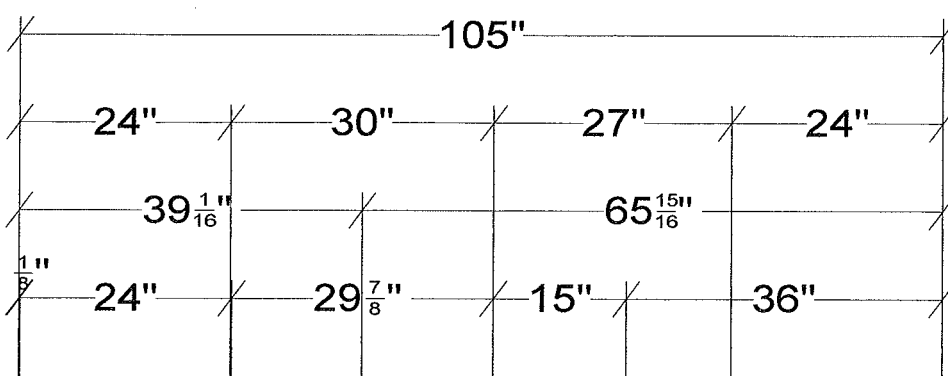

All dimensions, size designations given are subject to verification on job site and adjustment to fit job conditions.



This is an original design and must not be released or copied unless applicable fee has been paid or job order placed.

Designed: 9/18/2012  
Printed: 9/25/2013