

all morning glory
July 10th 6:15pm

Seal Harbor
CUSTOM HOMES & COASTAL COMMUNITIES
170 AND ROAD
LITTLETON, MA 01460

Foxglove

050.124

Unit 6 & 19


© 2008-2014 Wendy Welton, all rights reserved . You may not build this design without purchasing a license, even if you make changes. This design may have geographic restrictions.

Artform Home Plans

603-431-9559

06/16/14
6:13PM EDT

2 car
attached
garage

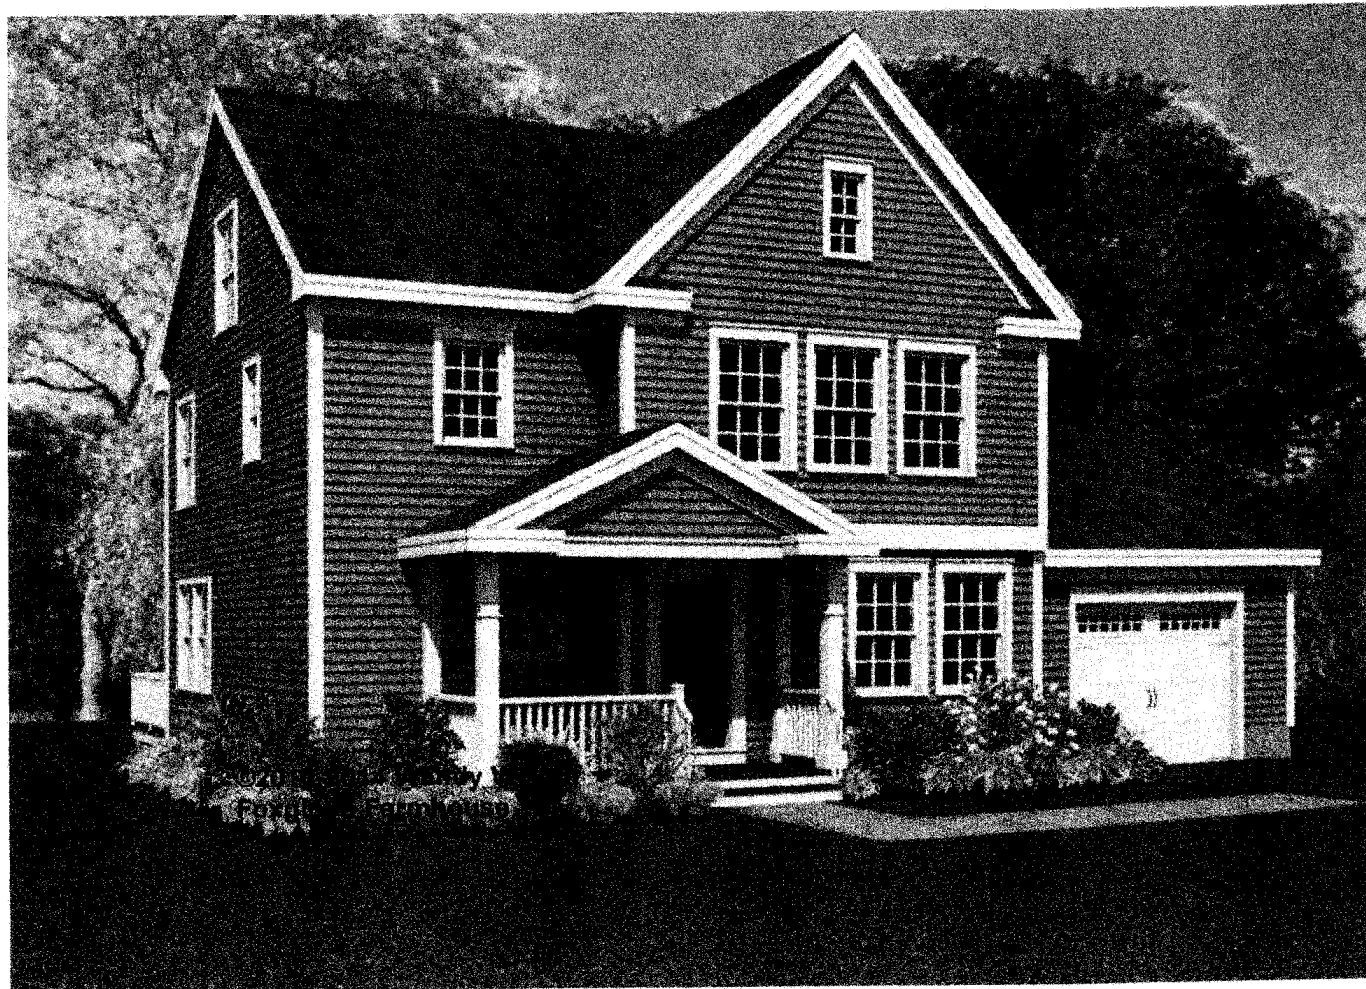

Some items shown are optional and/or may vary. Builder's written specifications always govern.

1. Gas fireplace and it's surround or mantel
2. Kitchen - island, cabinet style & trim, countertop material, etc.
3. Door styles and trim
4. Window grilles and trim, window treatments
5. Stair balusters or low walls at stairs
6. Lighting
7. Material selections (flooring, siding, roofing, paint colors, etc.)
8. Other furnishings
9. Landscaping, paving and walkways
10. Gutters, shutters and other exterior trim components
11. Deck size, railing style, stair location, etc.
12. Amount of exposed basement and/or wood framed walls at basement.

These images are not of any specific building site. Sun and view through windows will vary, as will the site around the house on the exterior and the slope of the land.


59

Foxglove

050.124

Unit 6 & 19

Living Area - Second Floor: 862 SF

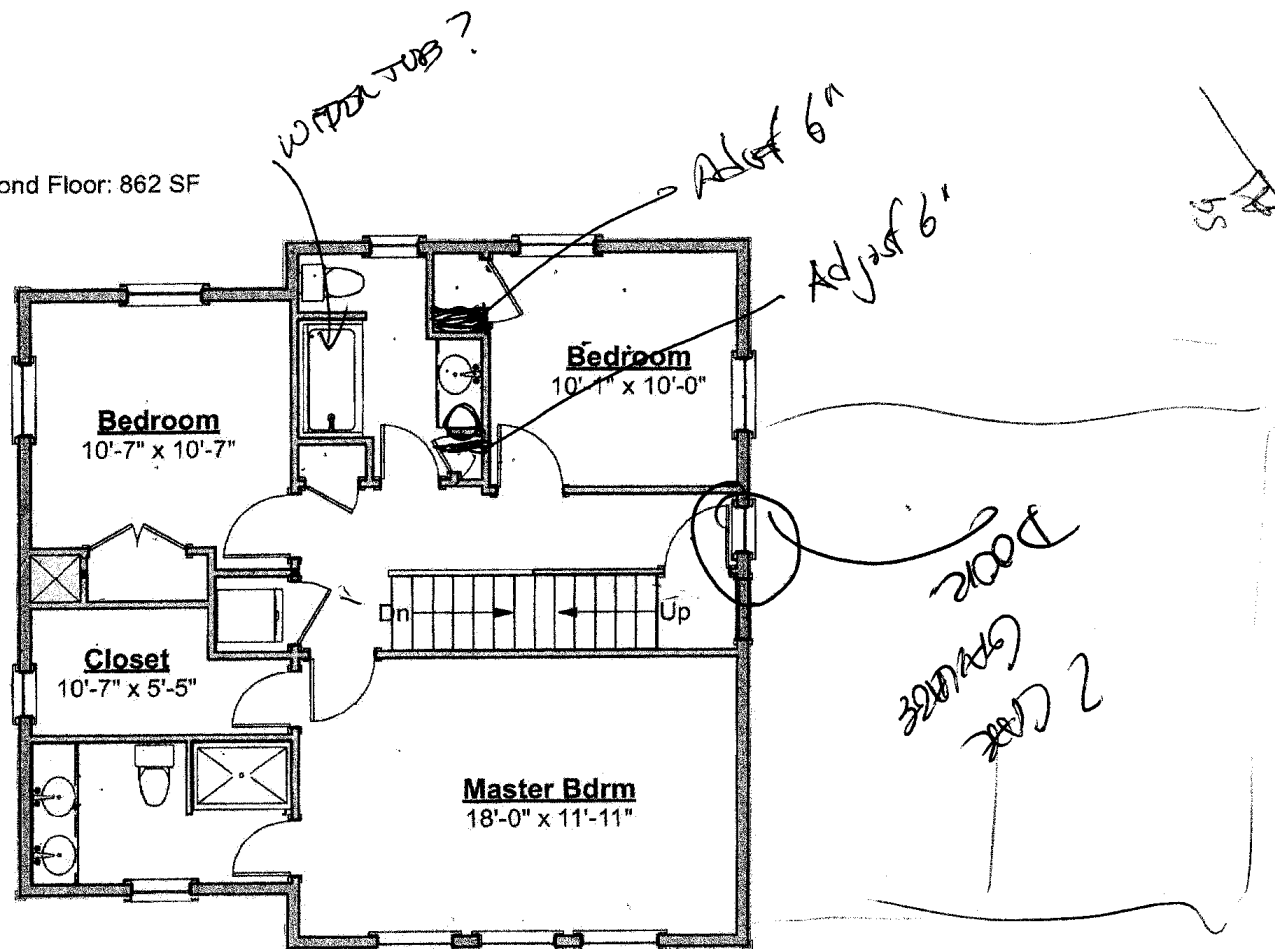

Second Floor Plan


Foxglove

050.124

Unit 6 & 19

790\$

SG

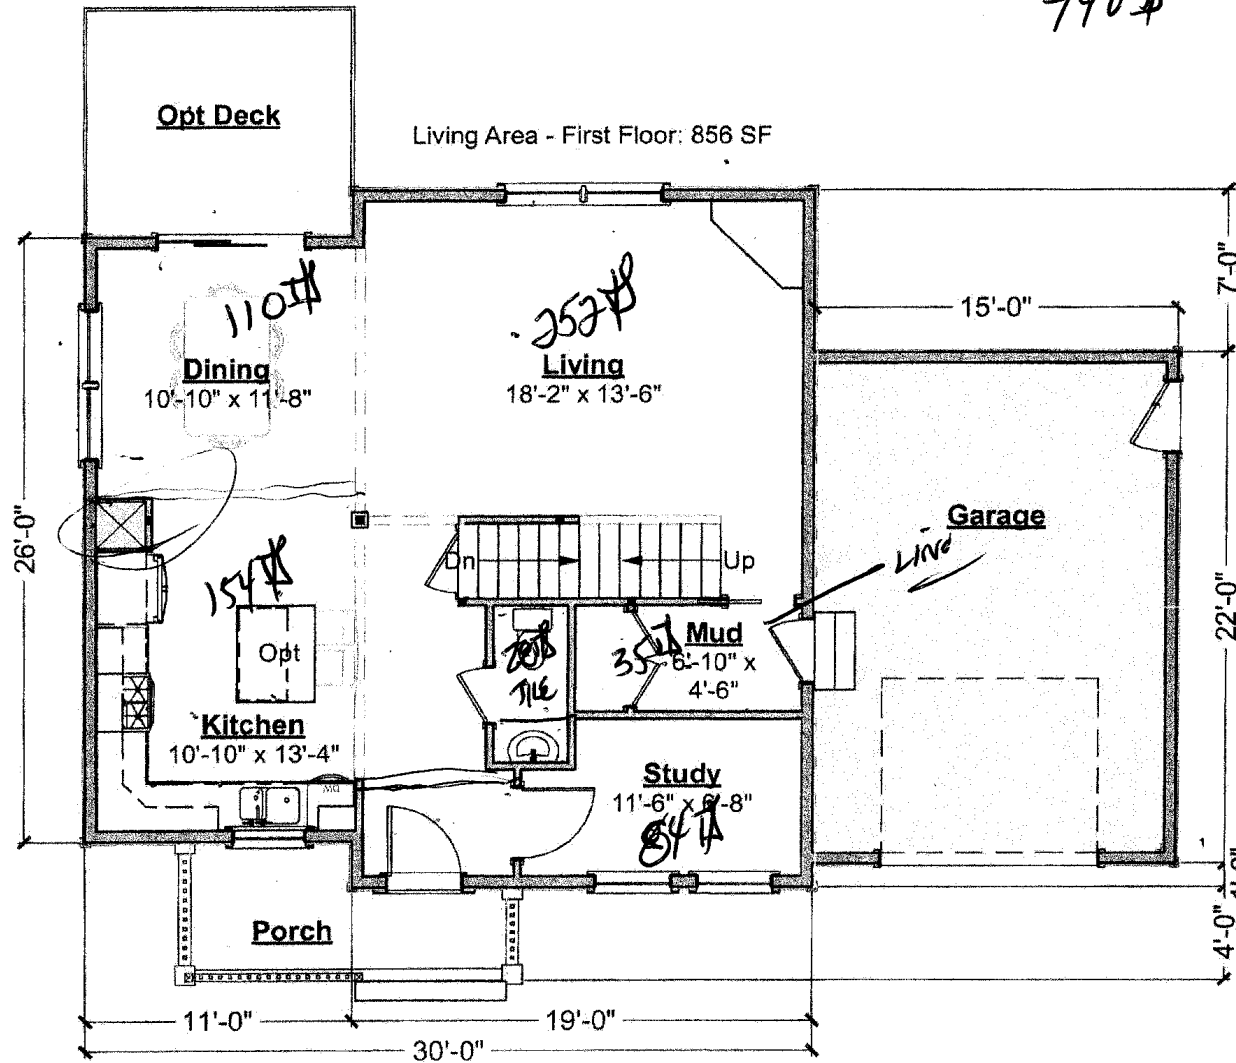


284
252
110
154
600
2 cars attached garage

310
14
18
2
332
11
14
44
11
154

First Floor Plan

Foxglove
 050.124
 Unit 6 & 19

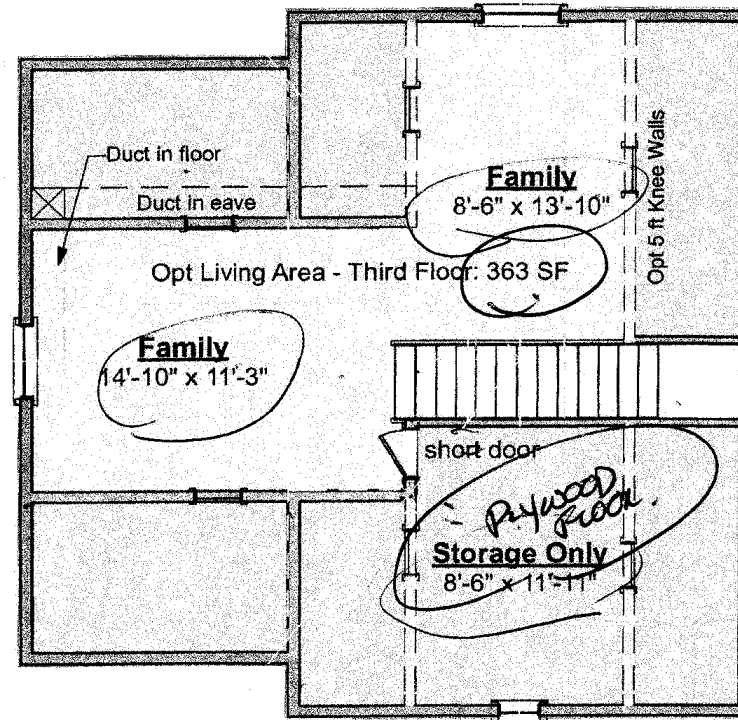

06/16/14
 6:13PM EDT

18
 12
 30
 18
 210
 34
 9
 126

12
 9
 108

Third Floor Plan


Foxglove

050.124

Unit 6 & 19



59

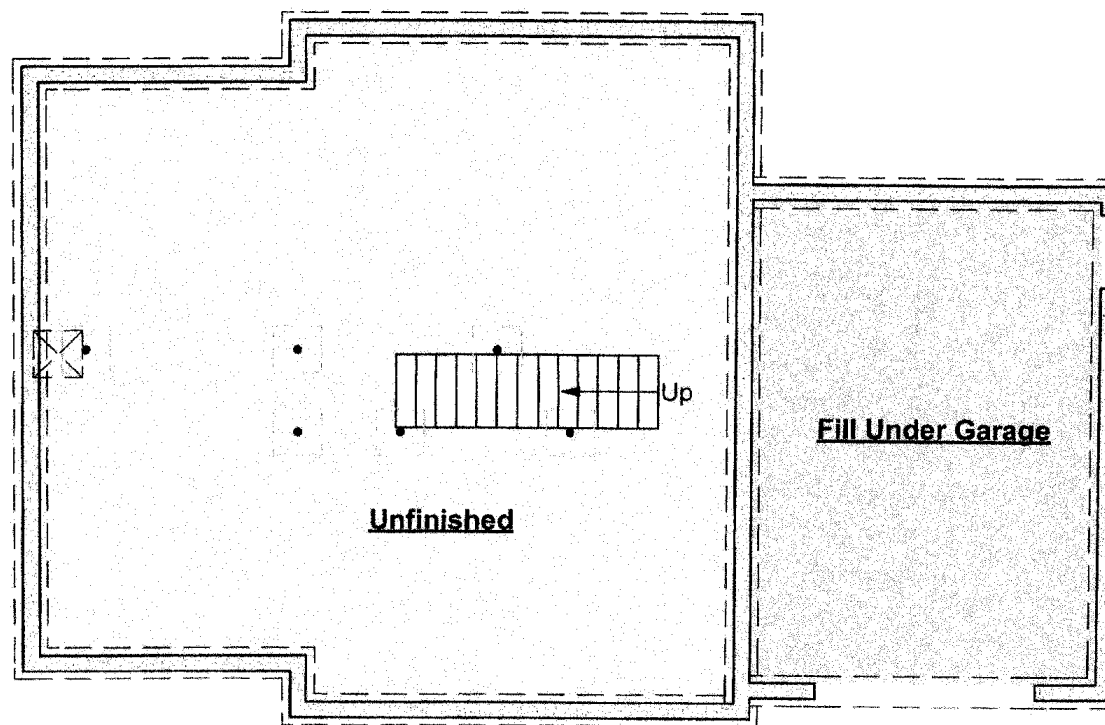

Basement Plan
(Full)