


Garnet Premier

348.129.v4 SR

© 2015-2016 Art Form Architecture, all rights reserved. You may not build this design without purchasing a license, even if you make changes. This design may have geographic restrictions.



603-431-9559

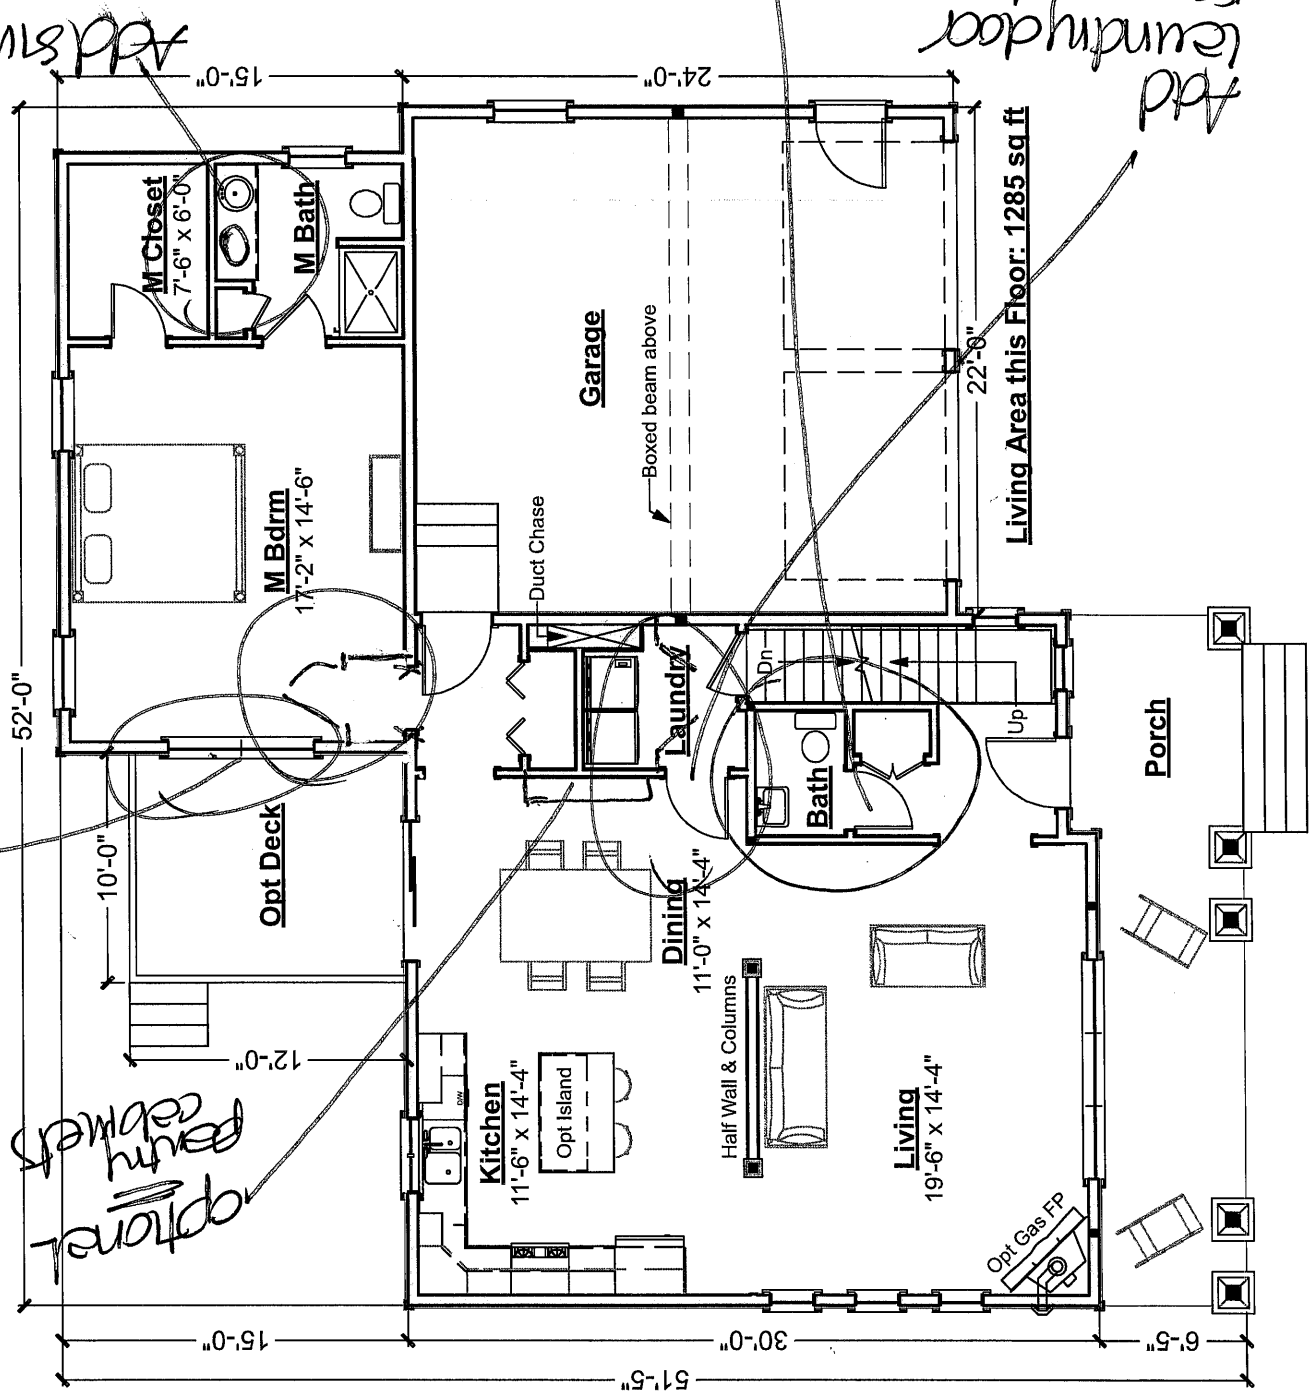

First Floor Plan

Can this swing in by making bathroom a tad bigger + closet smaller?


Garnet Premier

348.129.v4 SR

© 2015-2016 Art Form Architecture, all rights reserved. You may not build this design without purchasing a license, even if you make changes. This design may have geographic restrictions.



603-431-9559

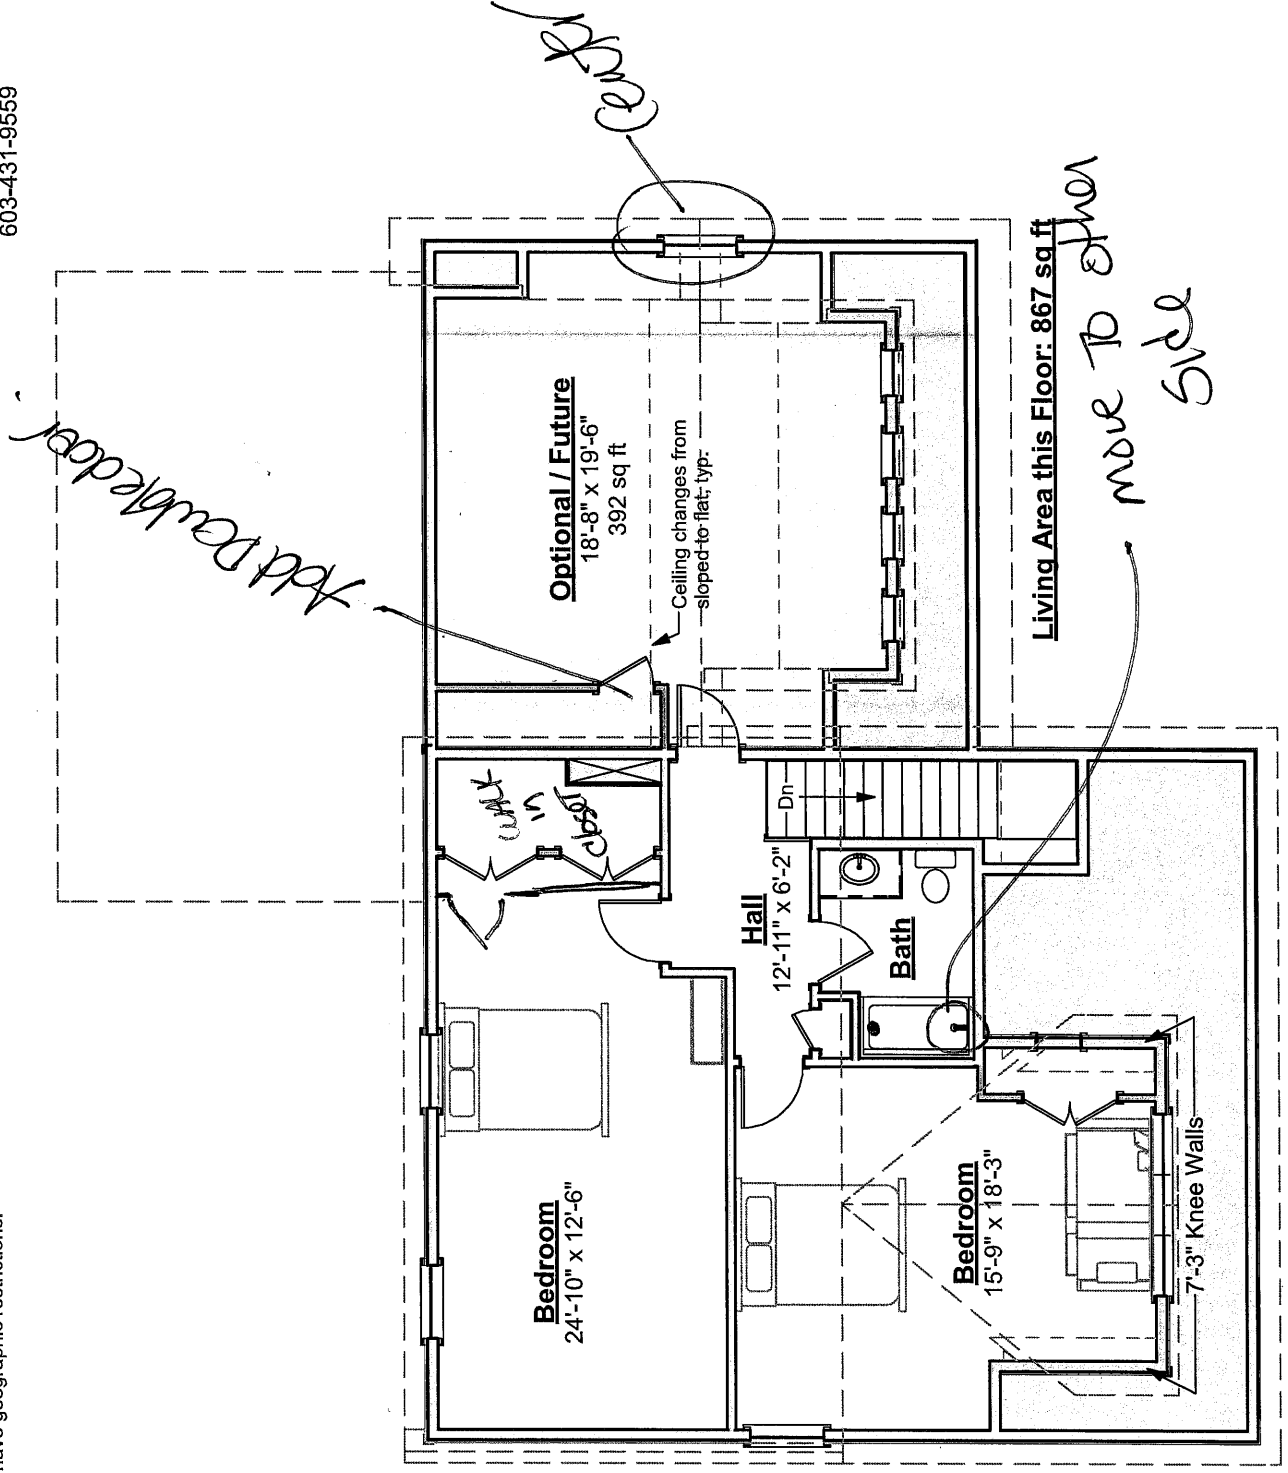

Second Floor Plan