

3/20/2020

Gooseberry Ranch

416.144.v9 GR

© 2011-2020 Art Form Architecture, Inc., all rights reserved.
You may not build this design without purchasing a license,
even if you make changes. This design may have geographic
restrictions.




803-431-9559

Twelve Month, LLC

dotloop verified
03/06/20 3:25 PM EST
NSDT-JGPB-RESX-EROL

Living Area this Floor: 1579 sq ft
8 ft Ceilings

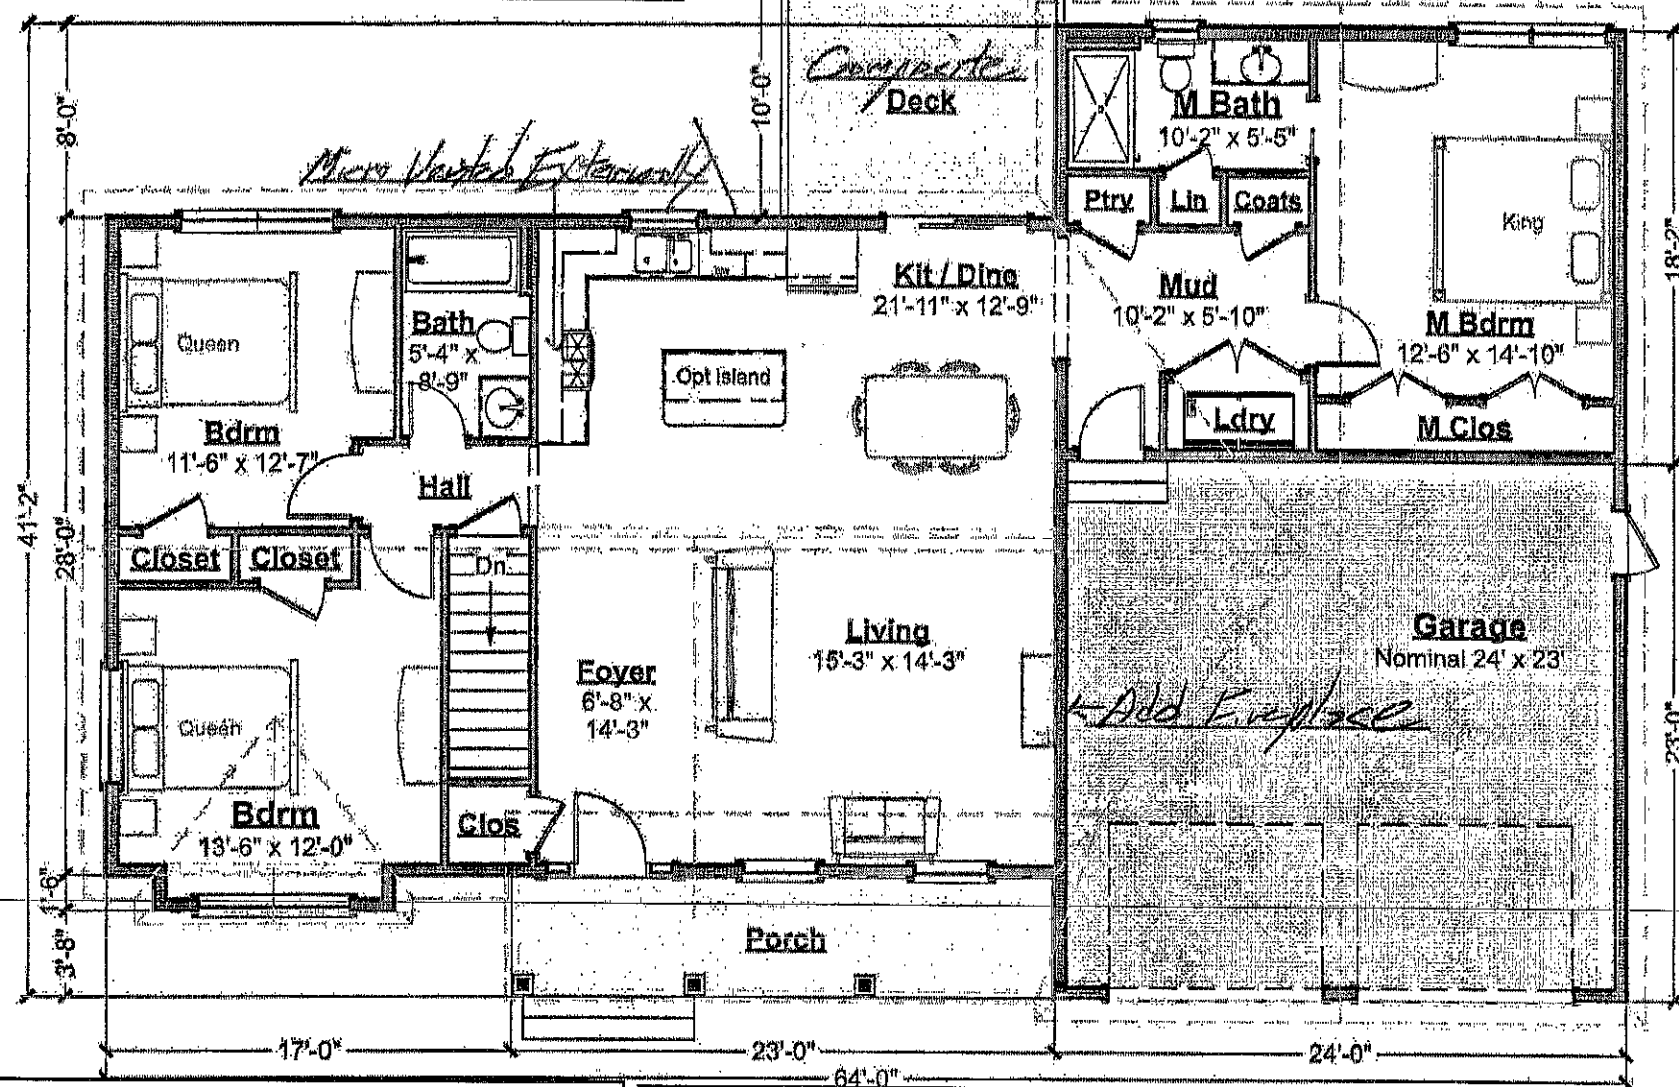

Alan Volpe

dotloop verified
03/04/20 9:33 PM EST
P20P-AM5Q-BMD7-G3GE

Karen Volpe

dotloop verified
03/04/20 9:29 PM EST
ONH1-MKTF-RFTH-QMIP

First Floor Plan
Scale: 1/8" = 1'-0"