


WHITE VINYL

4

DECKING
MATCH EXTS.

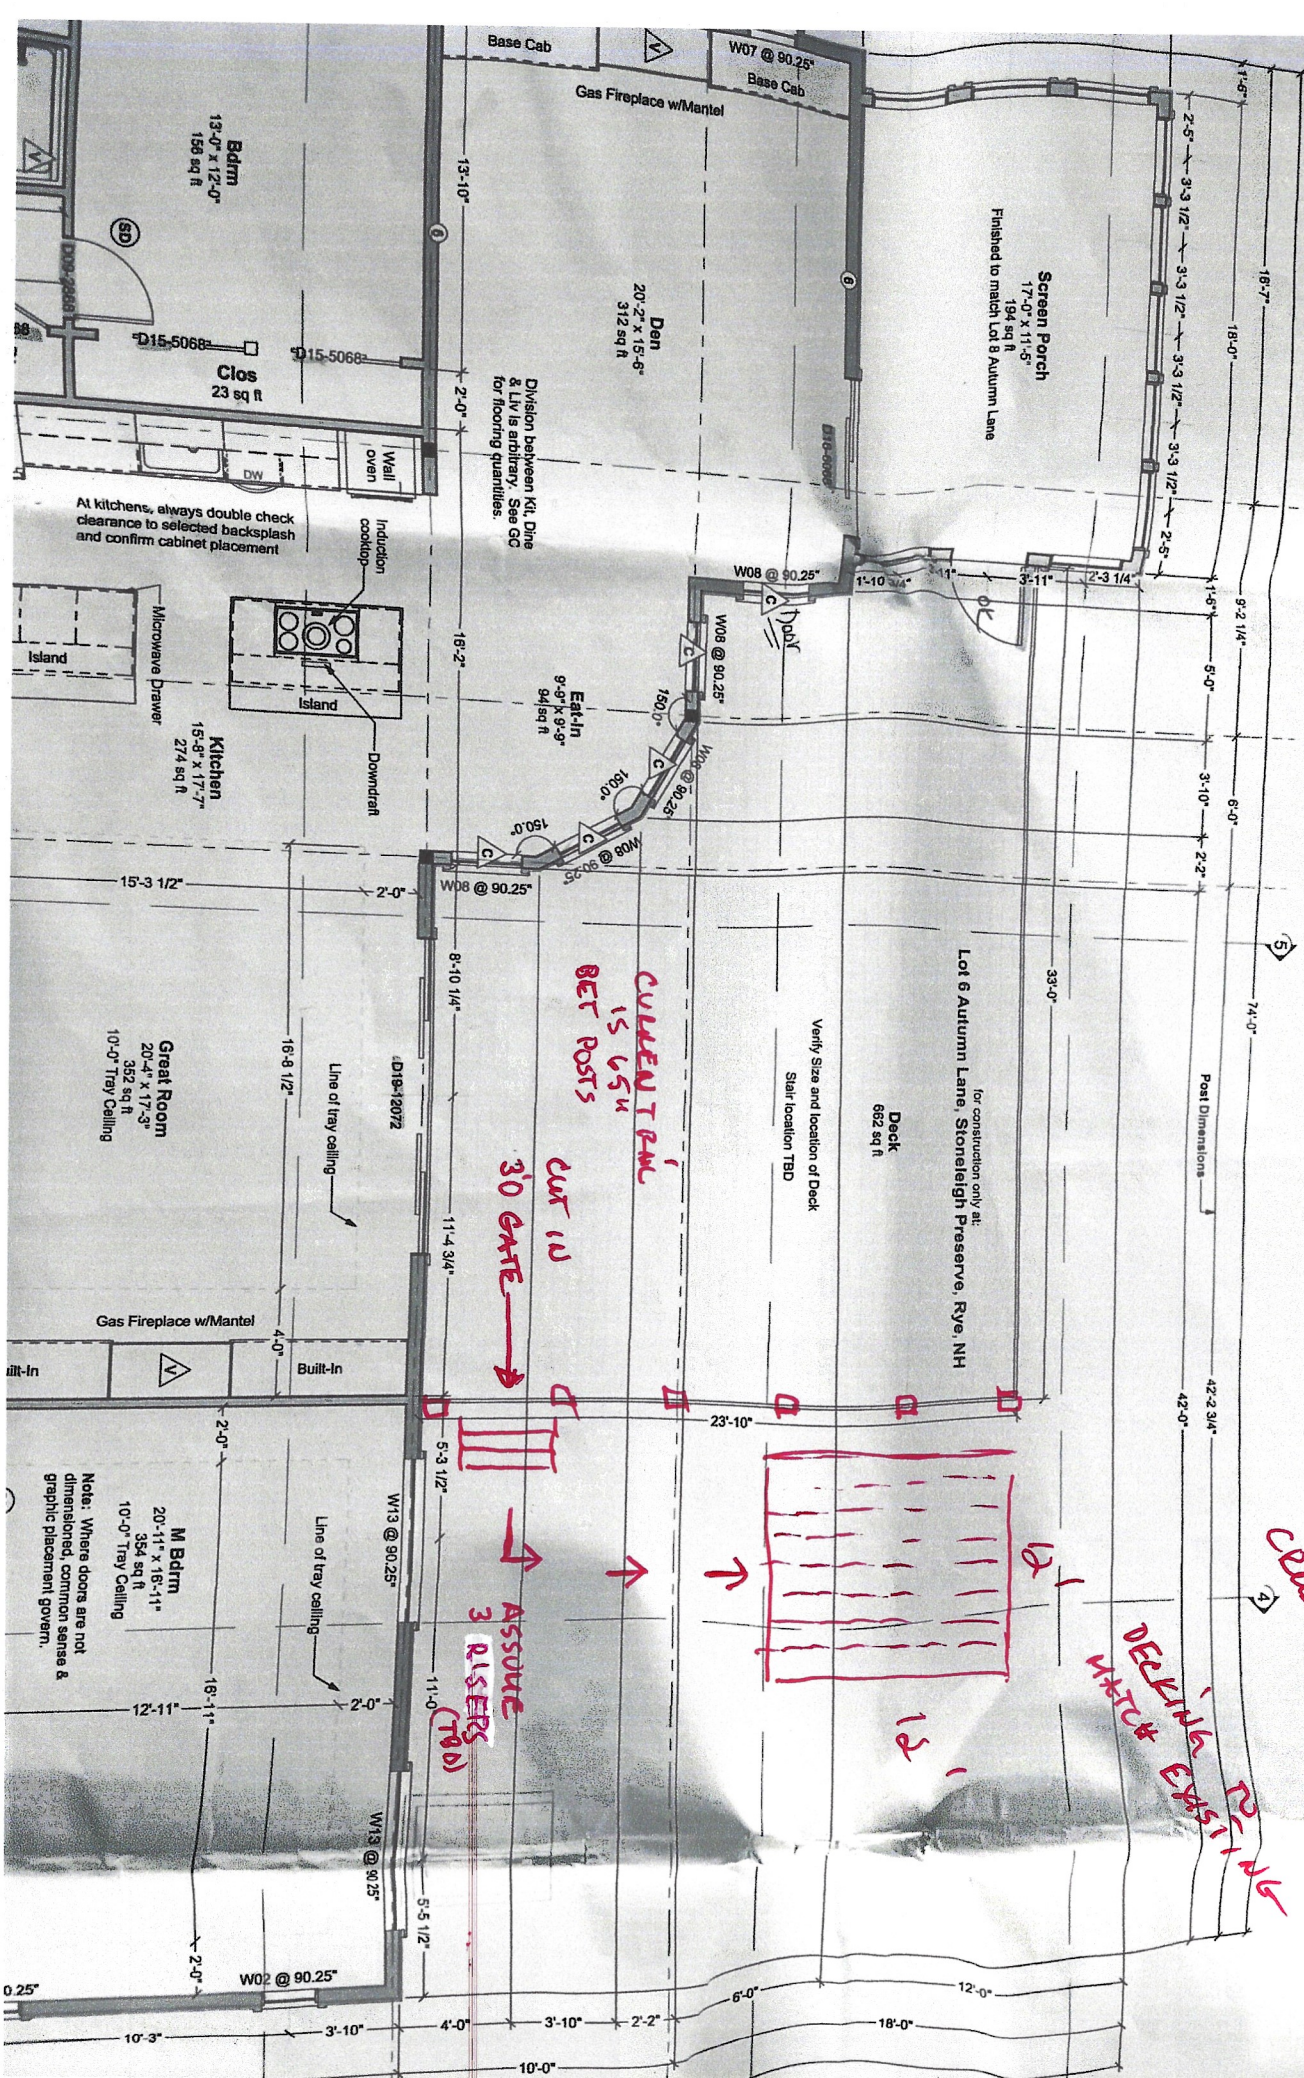

4'-6" x 4'-6" x 1'-0" Footing
with (7) #4 E.W. Bott.

for construction only at:
Lot 6 Autumn Lane, Stoneleigh Preserve, I

3'-0" x 3'-0" x 1'-0" Footing
with (5) #4 E.W. Bott., typical,
unless noted otherwise

2'-0" x 2'-0" x 1'-0" Footing
with (4) #4 E.W. Bott.

Unfinished Basement
1848 sq ft

3'-0" x 3'-0" x 1'-0" Footing
with (5) #4 E.W. Bott., typical,
unless noted otherwise

2'-6" x 2'-6"
with (4) #4
unless not

- ELEC REPT'S
- INSULATION
- SHEET ROCK
- ELEC REC LOTS

R311.7.1 - Stairways shall not be less than 36" in clear width at all points, show the permitted handrail height and location. The required clear width shall be the minimum clear width of 4.5' either side of the handrail, the handrail height shall not be less than 31 1/2" where a handrail is installed on one side and 27" where handrails are provided on both sides.

2'-0" x 2'-0" x 1'-0" Footing
with (4) #4 E.W. Bott.

Basement egress is required, egress window option shown. Builder may relocate window to suit building site and may substitute other code conforming egress, such as walk-out door or bulkhead.

Exercise Room
17'-9" x 13'-10"
245 sq ft

STAIRS UP TO 1st FLOOR:
14 Equal Risers @ 7 7/16" +/-
12 Treads @ 10" each, as measured nose to nose
1 Landing

3 1/2" OD concrete filled pipe post typical for interior Basement posts, unless noted otherwise

Size, quantity, and location of basement windows may vary to suit grade.

Footing type 36 ft - See Chart

Align face of stud with face of foundation at garage side

Align face of stud with face

by be
gle
ult GC