



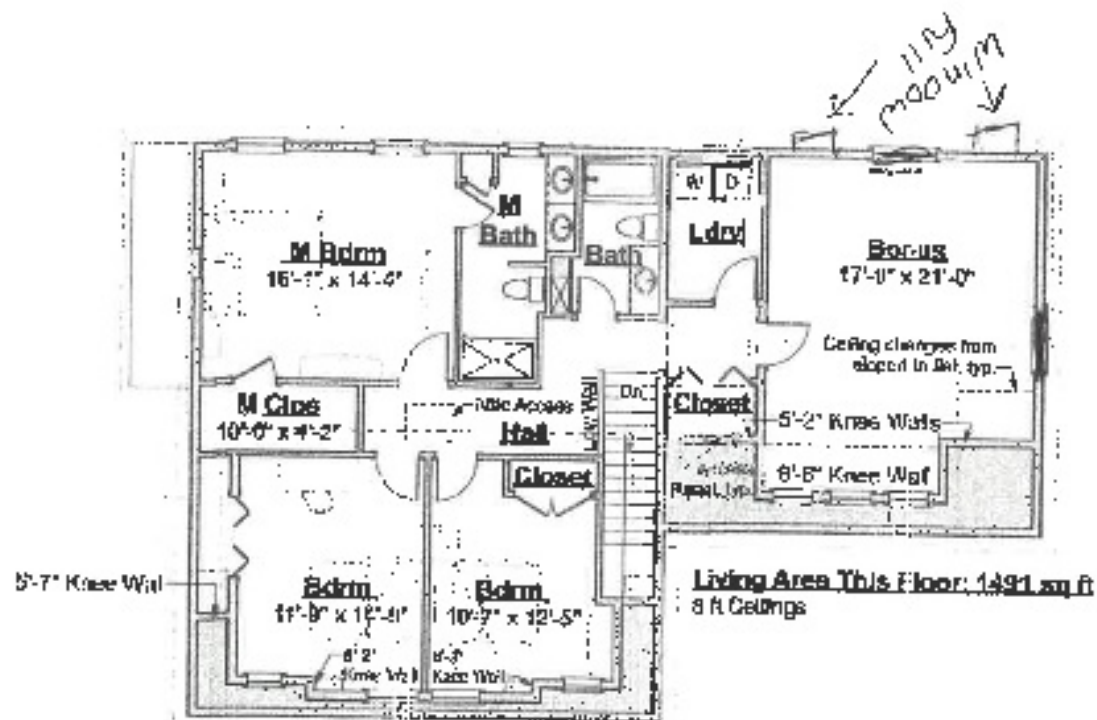

Second Floor Plan

Scale: $3/32" = 1'-0"$


Ch

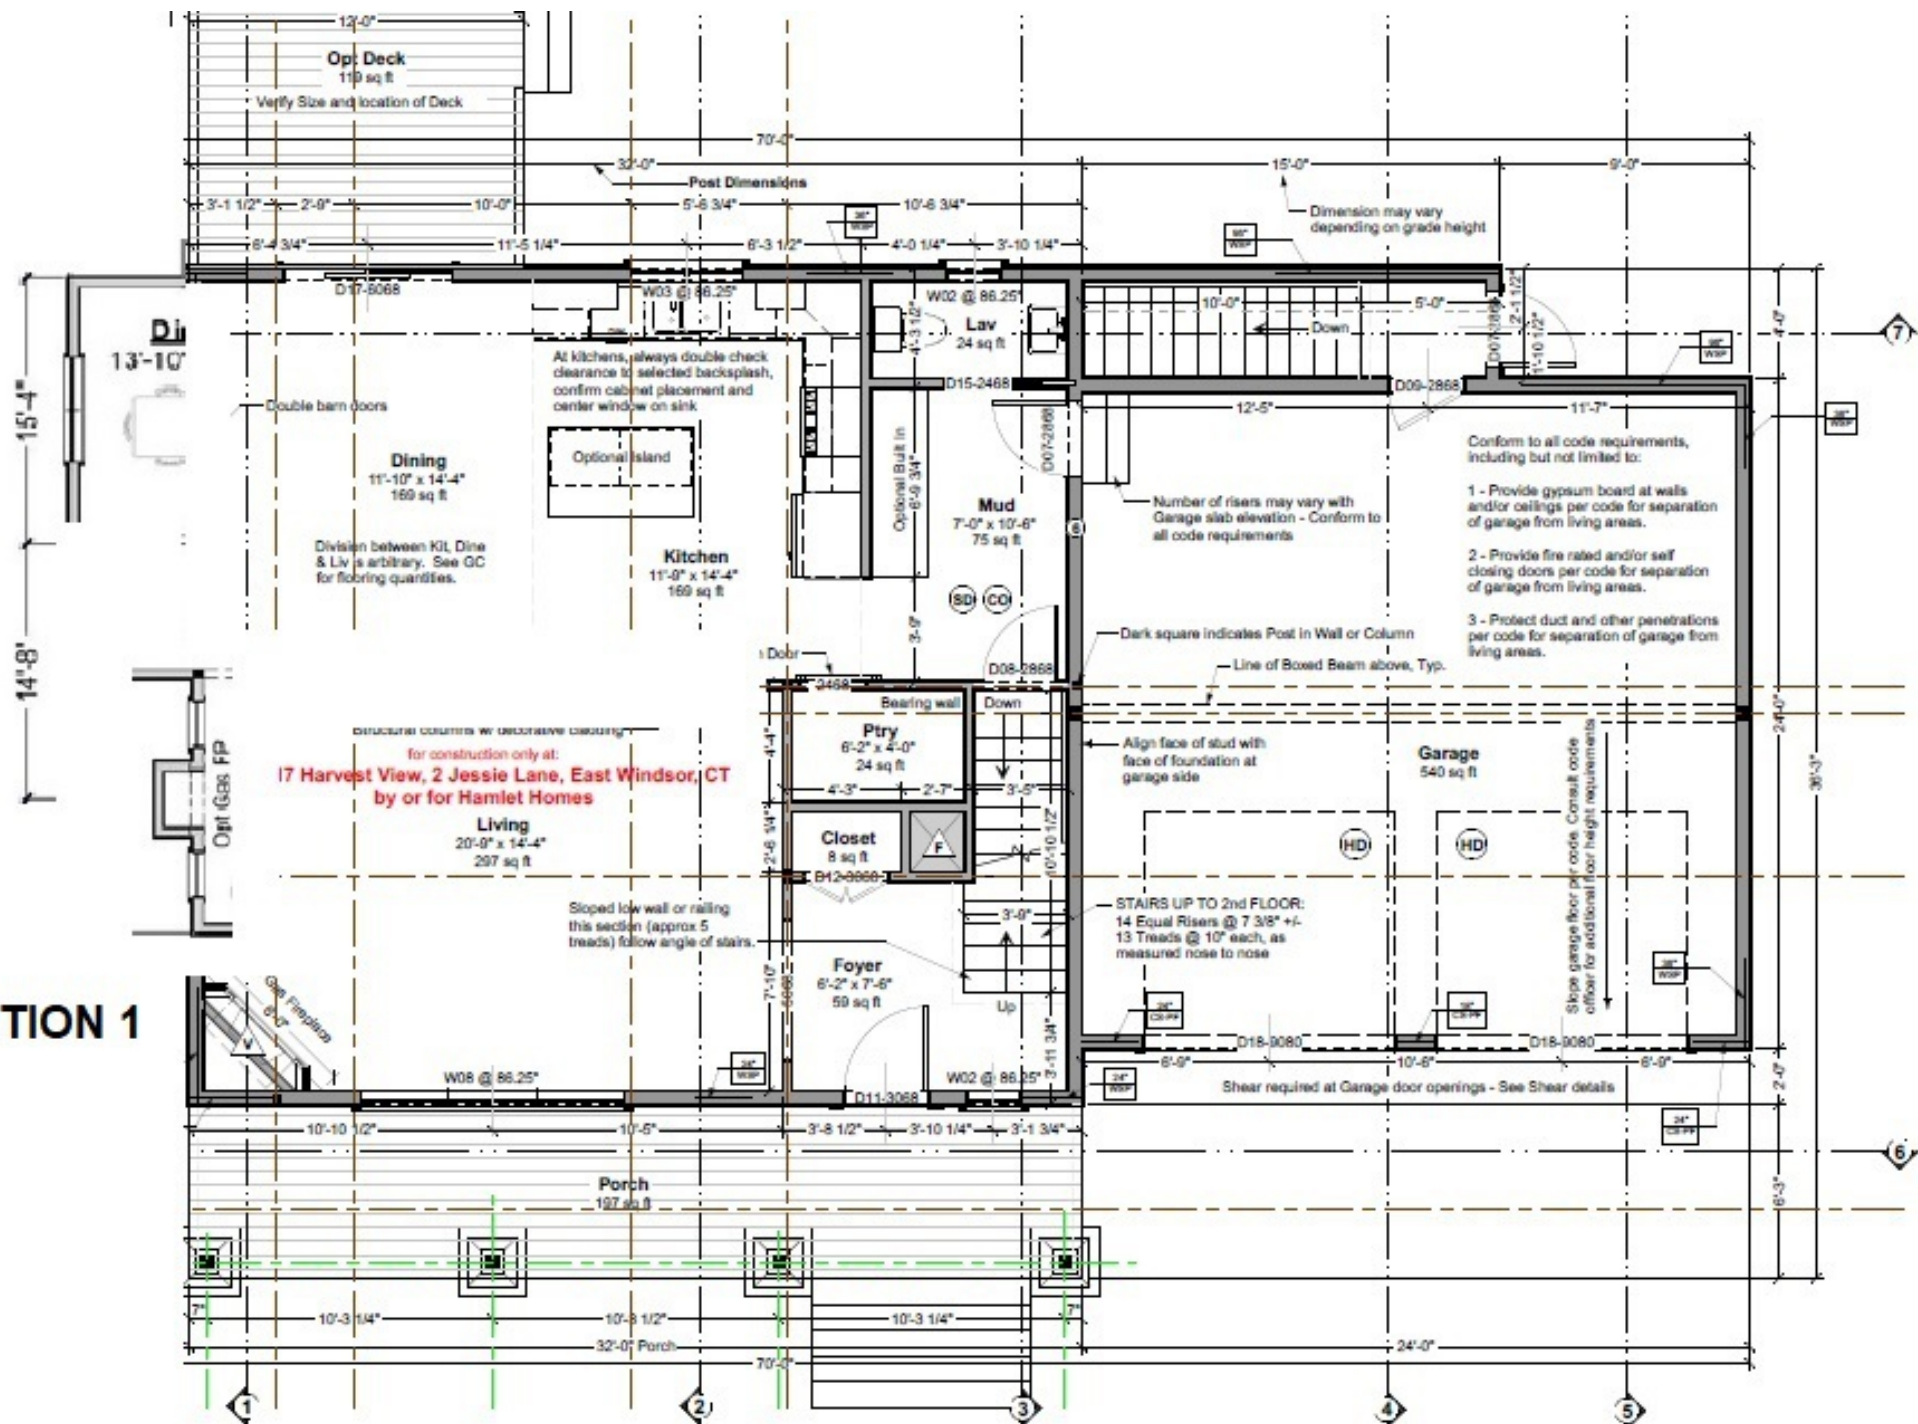


**OPTION 2- use
same floor plan as
OPTION 1**

stairway to basement

24x24 awning

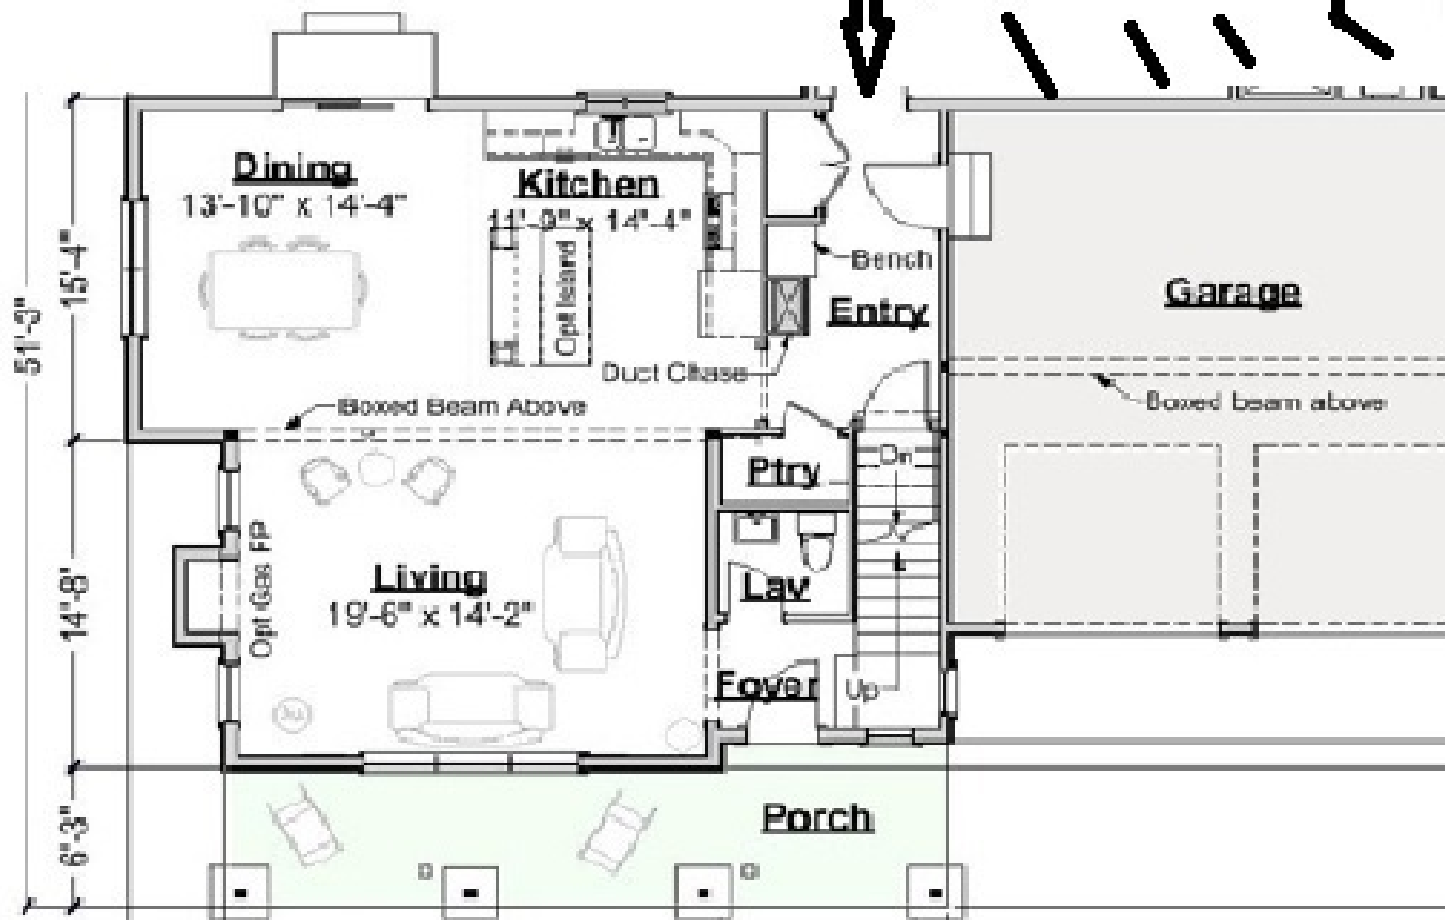

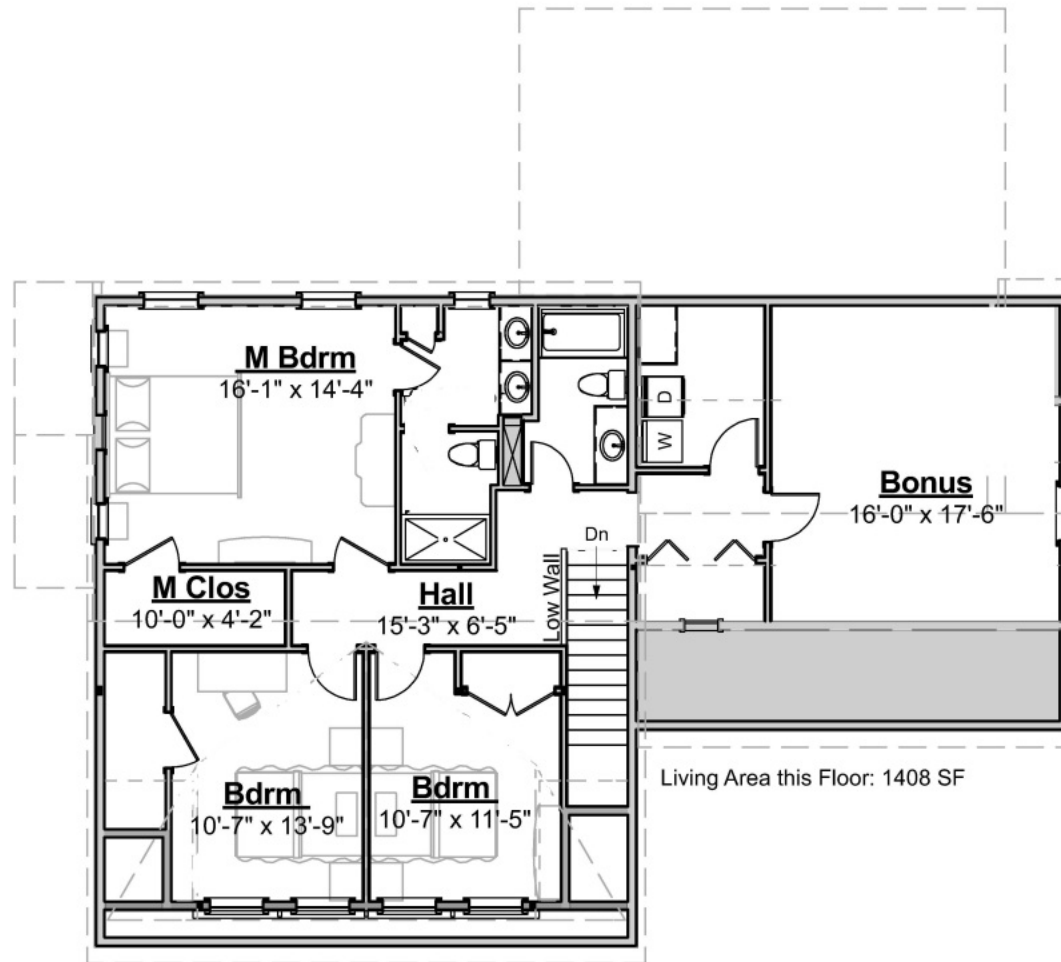

Second Floor Plan