

© 2011-2015 Wendy Welton, all rights reserved. You may not build this design without purchasing a license, even if you make changes. This design may have geographic restrictions.

High Skipper
389.120j.v4 ER

Add
Porch

Artform Home Plans

603-431-9559



Some items shown are optional and/or may vary. Builder's written specifications always govern.

1. Gas fireplace and it's surround or mantel
2. Kitchen - island, cabinet style & trim, countertop material, etc.
3. Door styles and trim
4. Window grilles and trim, window treatments
5. Stair balusters or low walls at stairs
6. Lighting
7. Material selections (flooring, siding, roofing, paint colors, etc.)
8. Other furnishings
9. Landscaping, paving and walkways
10. Gutters, shutters and other exterior trim components
11. Deck size, railing style, stair location, etc.
12. Amount of exposed basement and/or wood framed walls at basement.

These images are not of any specific building site. Sun and view through windows will vary, as will the site around the house on the exterior and the slope of the land.

High Skipper



389.004

© 2011 Wendy Welton, all rights reserved

USE 389-12014 kitchen

First Floor

Second Floor

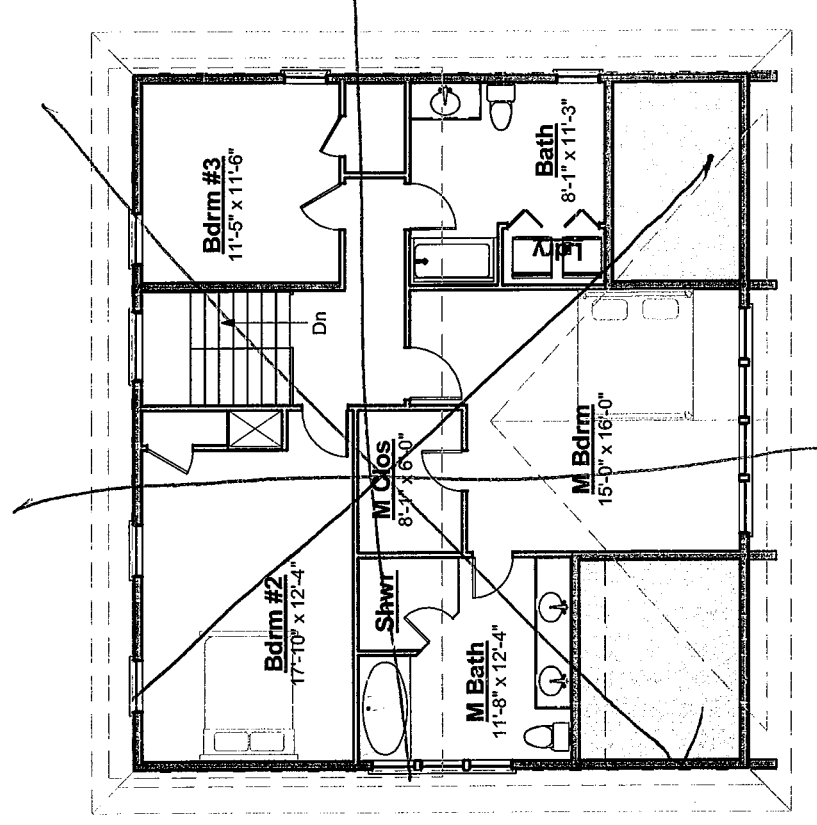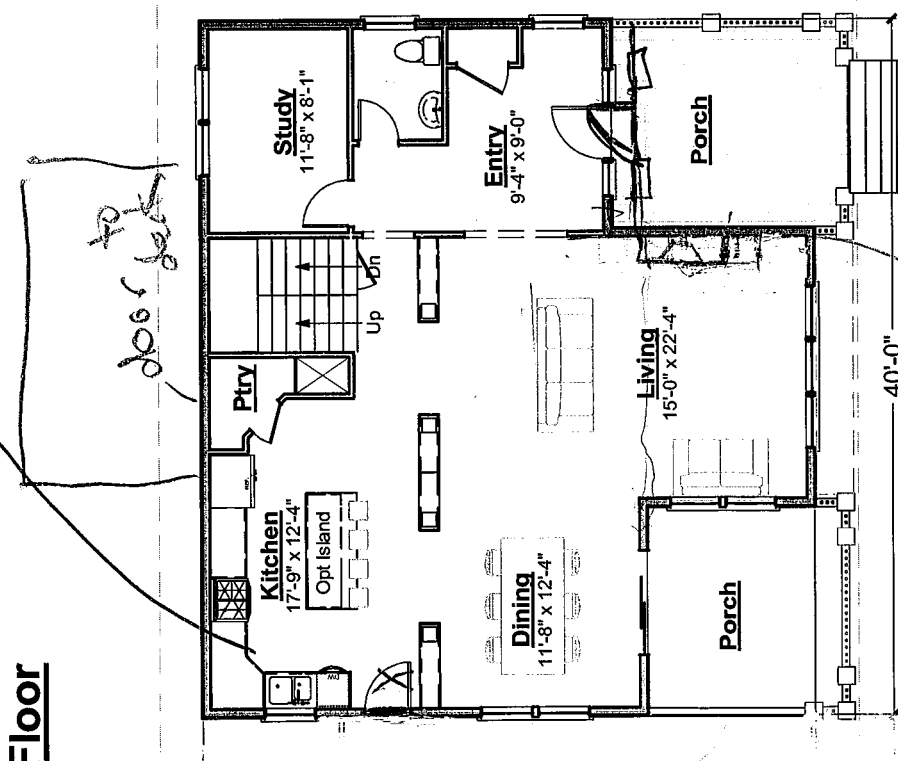


Center

© 2011-2015 Wendy Welton, all rights reserved. You may not build this design without purchasing a license, even if you make changes. This design may have geographic restrictions.

High Skipper
389.120j.v4 ER



603-431-9559

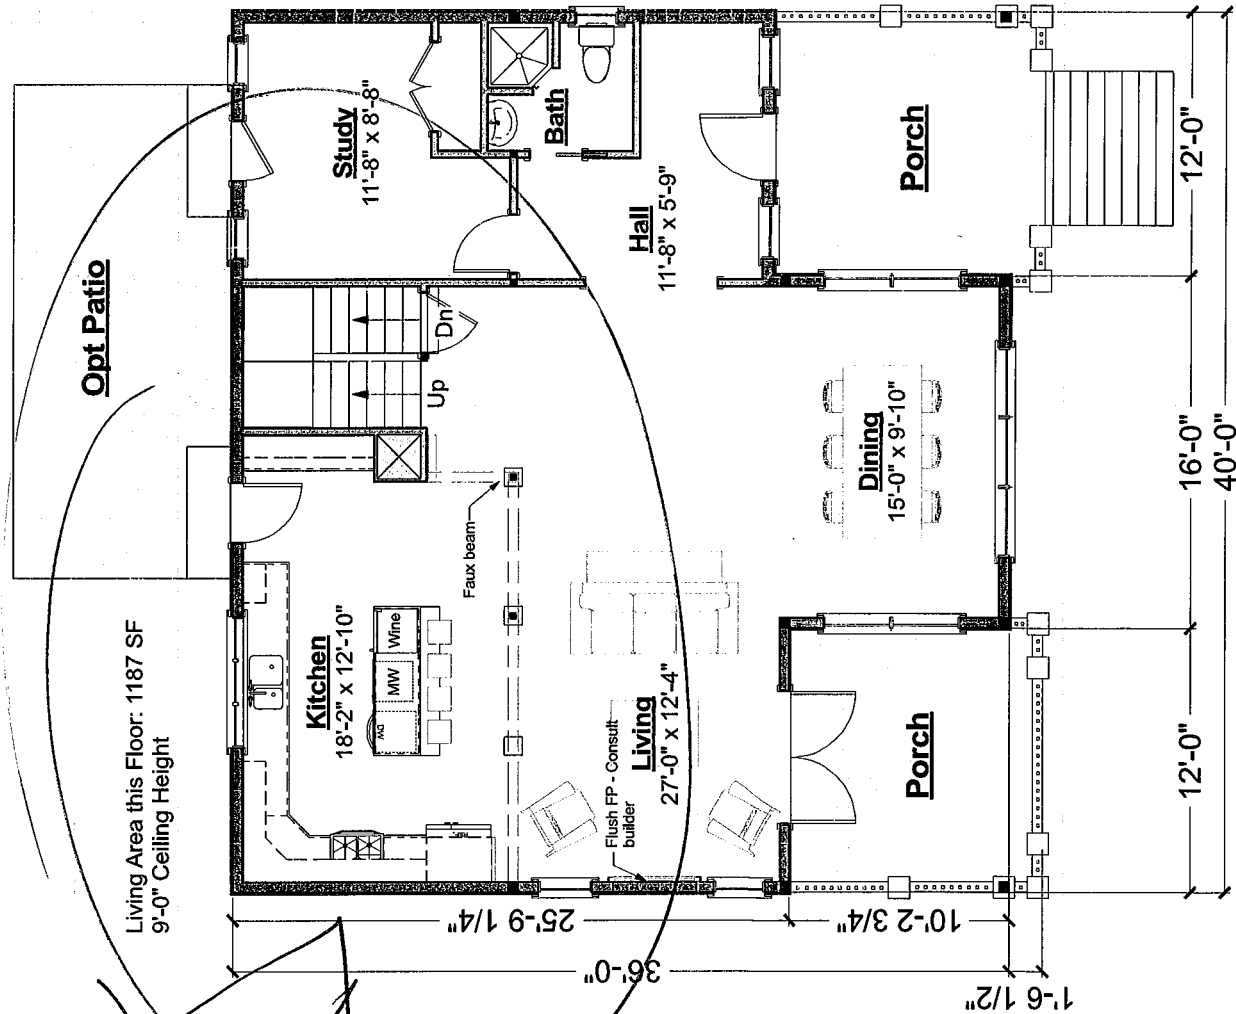

*use two new
use 4x6*

First Floor Plan

High Skipper


389.120j.v3 ER

© 2014 Wendy Welton, all rights reserved. You may not build this design without purchasing a license, even if you make changes. This design may have geographic restrictions.



603-431-9559

Living Area this Floor: 1234 SF

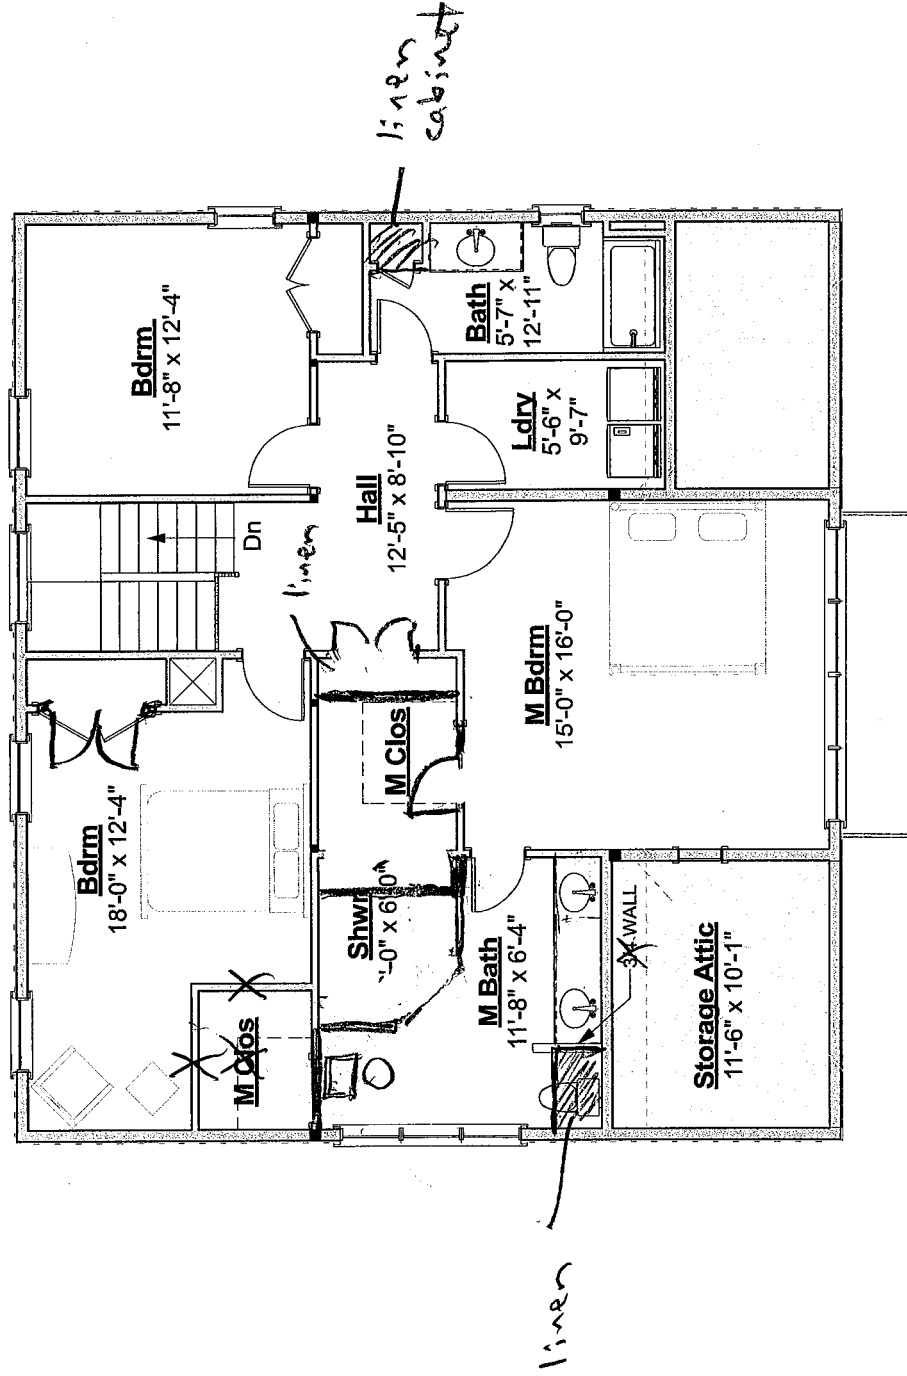


Second Floor Plan

© 2011-2015 Wendy Welton, all rights reserved. You may not build this design without purchasing a license, even if you make changes. This design may have geographic restrictions.

High Skipper
389.120j.v4 ER

Artform Home Plans
603-431-9559

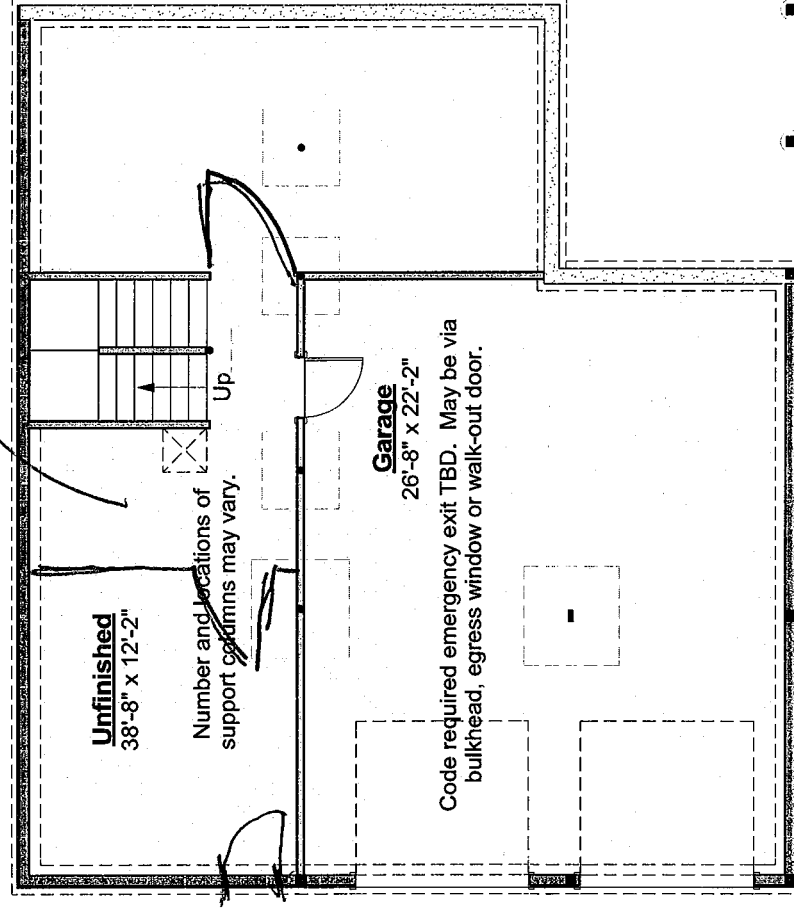

Foundation Plan