

3/18/2021


Add/Reno - Huebner Residence

(3/18/2021)

©2021 Art Form Architecture, Inc., all rights reserved. You may not build this design without purchasing a license, even if you make changes. This design may have geographic restrictions.

Artform Home Plans

Prelim / Work in Progress 603-431-9559

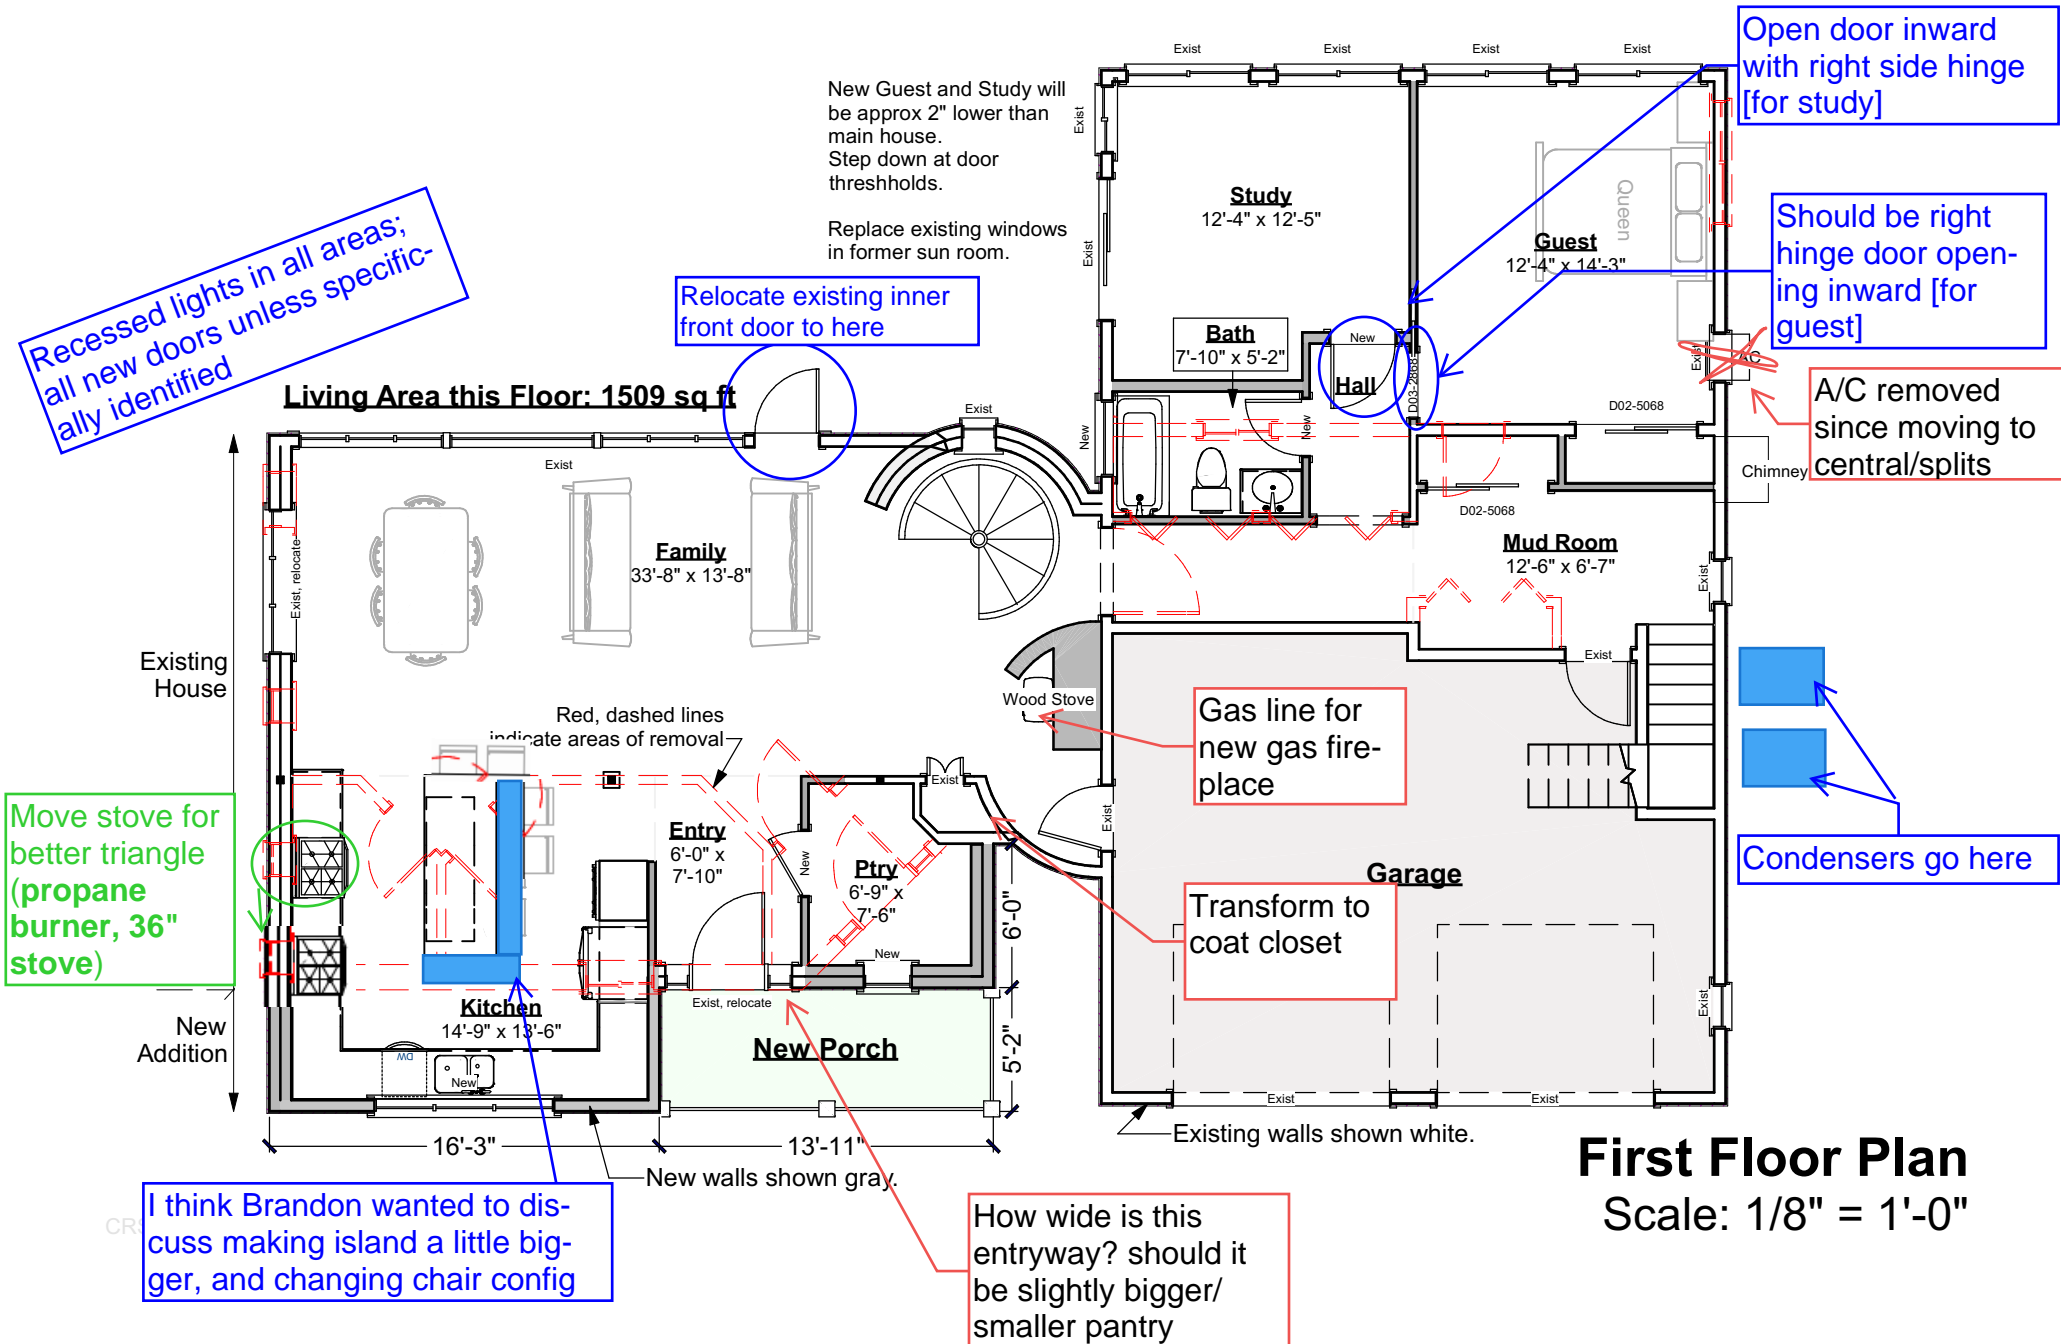

3/18/2021

Add/Reno - Huebner Residence


(3/18/2021)

©2021 Art Form Architecture, Inc., all rights reserved . You may not build this design without purchasing a license, even if you make changes. This design may have geographic restrictions.



Prelim / Work in Progress 603-431-9559

Remove skylights in wet bar area and master bedroom (use of ducts?)

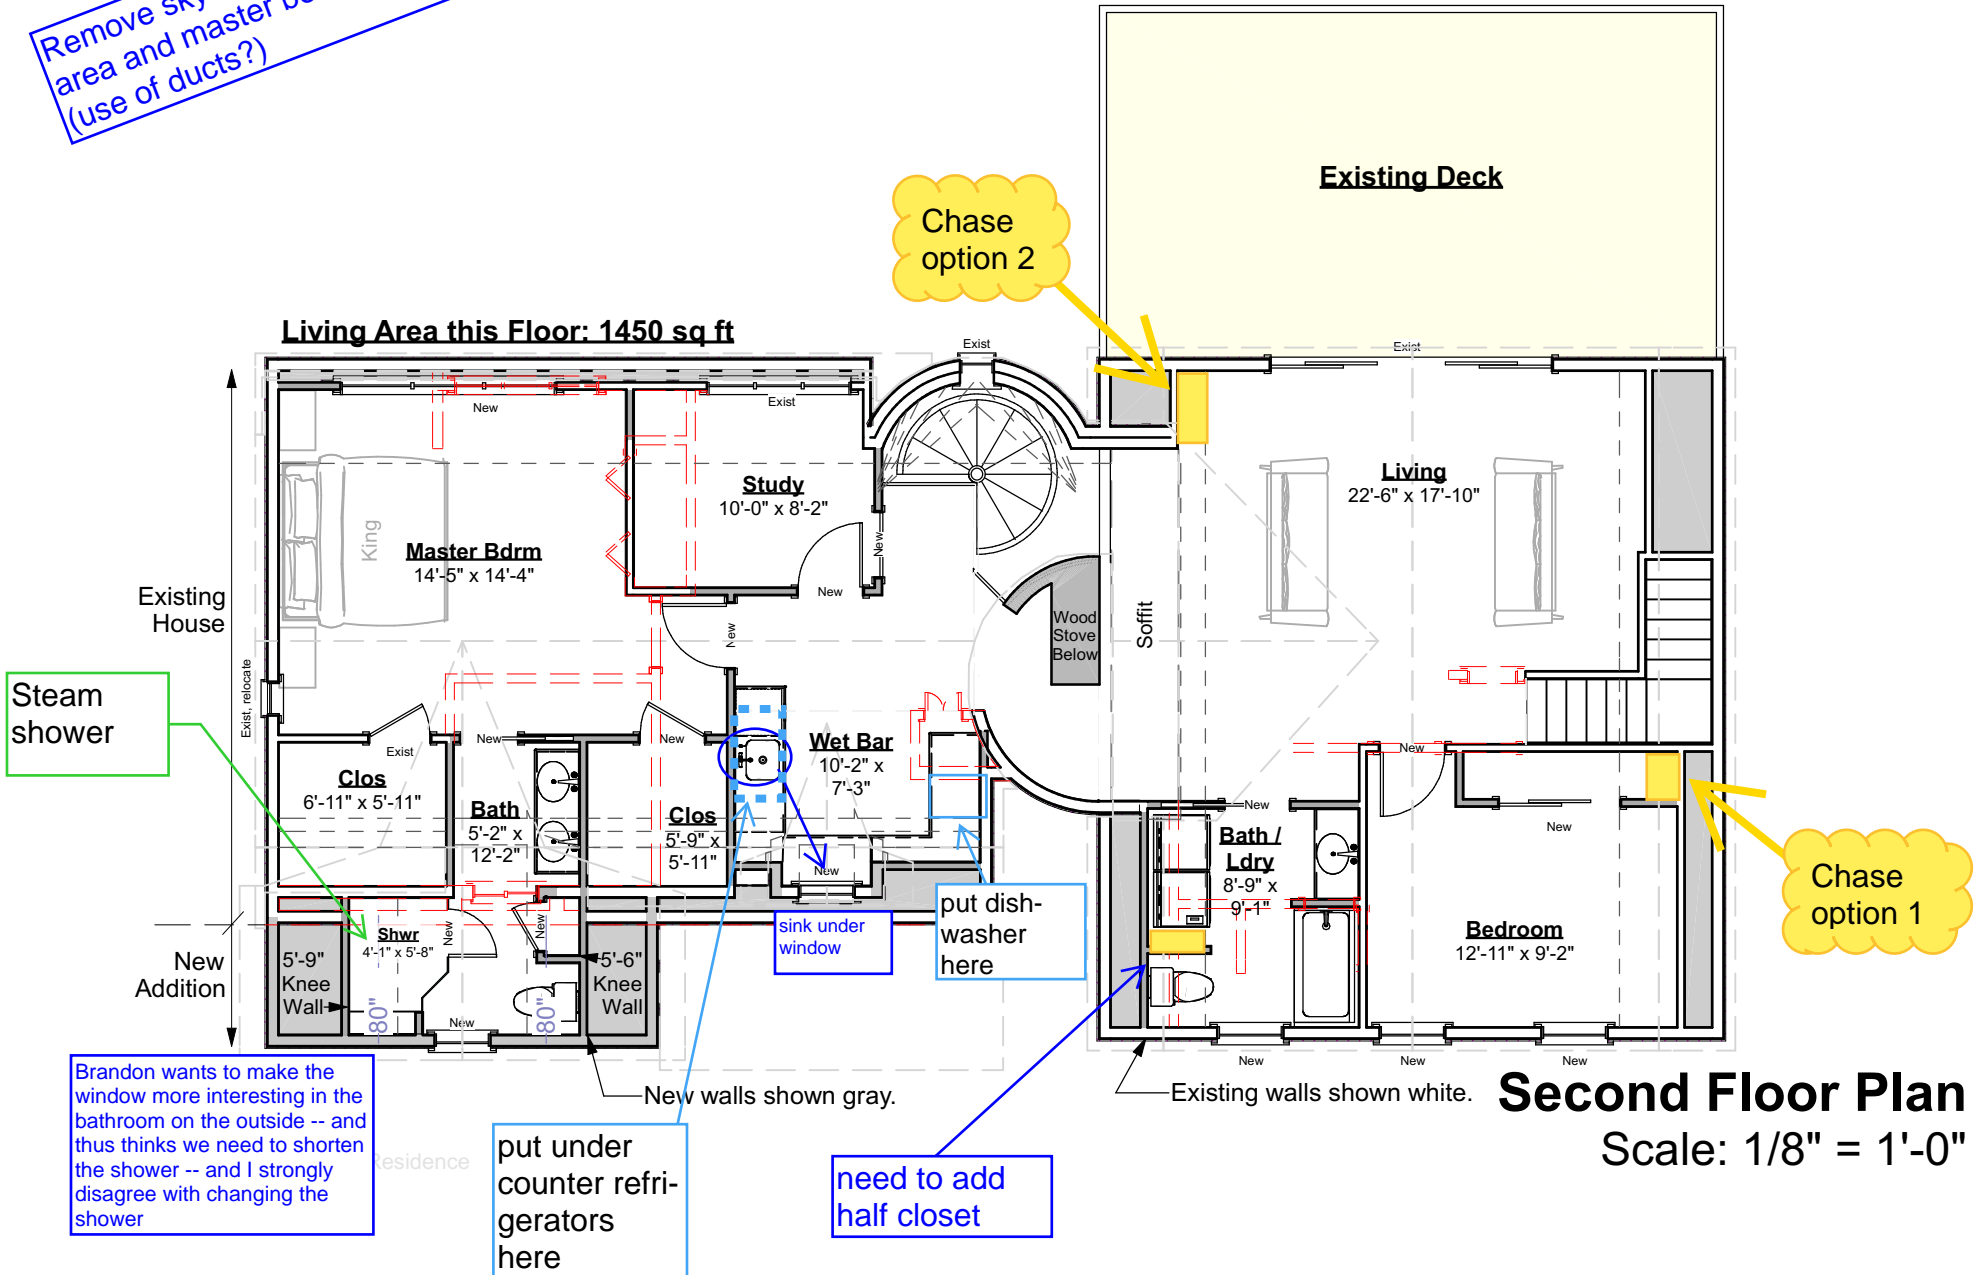

3/18/2021

Add/Reno - Huebner Residence

(3/18/2021)

©2021 Art Form Architecture, Inc., all rights reserved . You may not build this design without purchasing a license, even if you make changes. This design may have geographic restrictions.



Prelim / Work in Progress 603-431-9559



This is the window brandon is talking about a "unique shaped window".... care to get your thoughts... it doesn't bother me

Brandon also scribbled little roof augment back on -- but disagree -- think it's more a nice to have in the future... not sure if easy to see though what it would look like... i honestly think cleaner/ like as is



Pentagon



Isosceles Triangle

Dear Builders and Home Buyers,

In addition to our Terms and Conditions (the "Terms"), please be aware of the following:

This design may not yet have Construction Drawings (as defined in the Terms), and is, therefore, only available as a Design Drawing (as defined in the Terms and together with Construction Drawings, "Drawings"). It is possible that during the conversion of a Design Drawing to a final Construction Drawing, changes may be necessary including, but not limited to, dimensional changes. Please see Plan Data Explained on www.ArtformHomePlans.com to understand room sizes, dimensions and other data provided. We are not responsible for typographical errors.

Artform Home Plans ("Artform") requires that our Drawings be built substantially as designed. Artform will not be obligated by or liable for use of this design with markups as part of any builder agreement. While we attempt to accommodate where possible and reasonable, and where the changes do not denigrate our design, any and all changes to Drawings must be approved in writing by Artform. It is recommended that you have your Drawing updated by Artform prior to attaching any Drawing to any builder agreement. Artform shall not be responsible for the misuse of or unauthorized alterations to any of its Drawings.

Facade Changes:

- To maintain design integrity, we pay particular attention to features on the front facade, including but not limited to door surrounds, window casings, finished porch column sizes, and roof friezes. While we may allow builders to add their own flare to aesthetic elements, we don't allow our designs to be stripped of critical details. Any such alterations require the express written consent of Artform.
- Increasing ceiling heights usually requires adjustments to window sizes and other exterior elements.

Floor plan layout and/or Structural Changes:

- Structural changes always require the express written consent of Artform
- If you wish to move or remove walls or structural elements (such as removal of posts, increases in house size, ceiling height changes, addition of dormers, etc), please do not assume it can be done without other additional changes (even if the builder or lumber yard says you can).

3/18/2021

Add/Reno - Huebner Residence

(3/18/2021)


©2021 Art Form Architecture, Inc., all rights reserved . You may not build this design without purchasing a license, even if you make changes. This design may have geographic restrictions.

Artform Home Plans

Prelim / Work in Progress 603-431-9559

Main A/C Duct
Air handler in garage

Need chase
through circular
hallway

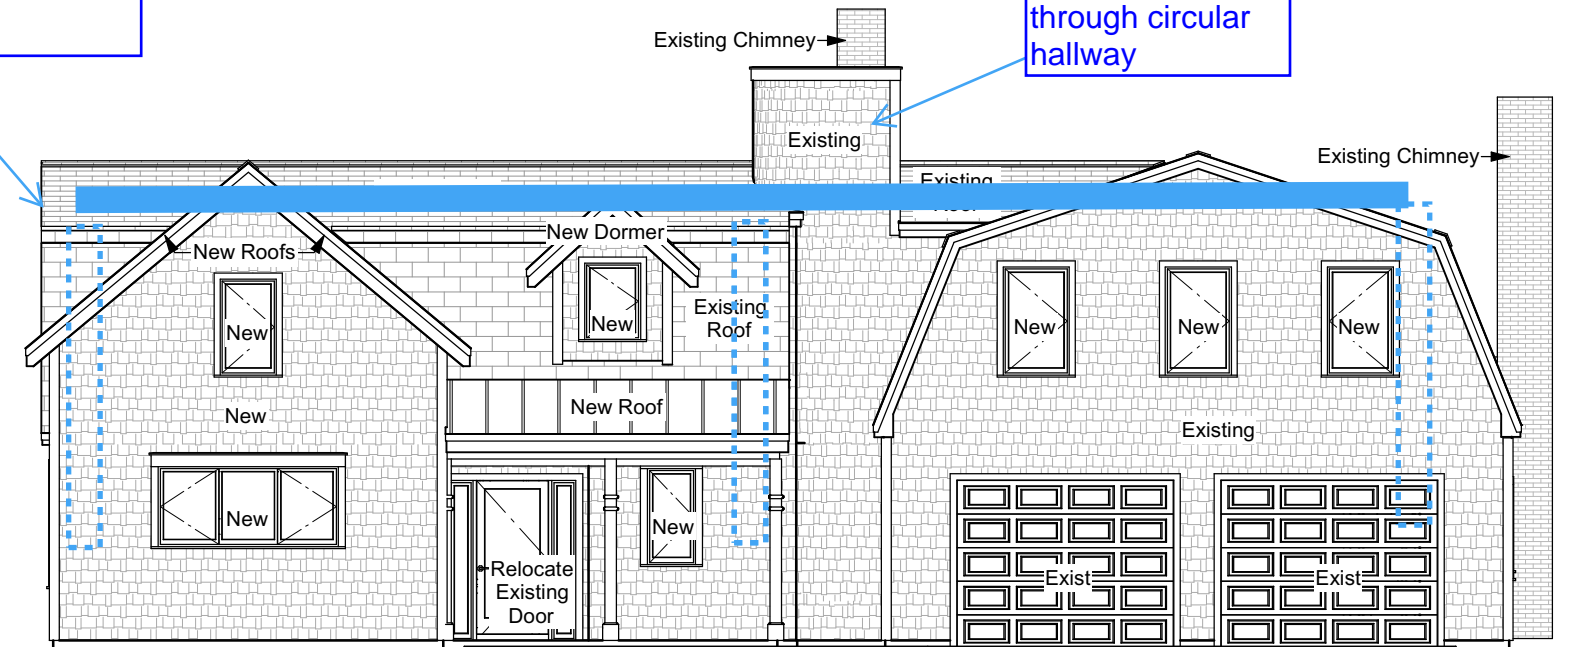

Front Elevation
Scale: 1/8" = 1'-0"