


Great Skye  
635.124

© 2013 Wendy Wilson, all rights reserved. You may not build this design without purchasing a license, even if you make changes. This design may have geographic restrictions.

# Artform Home Plans

603-431-9559

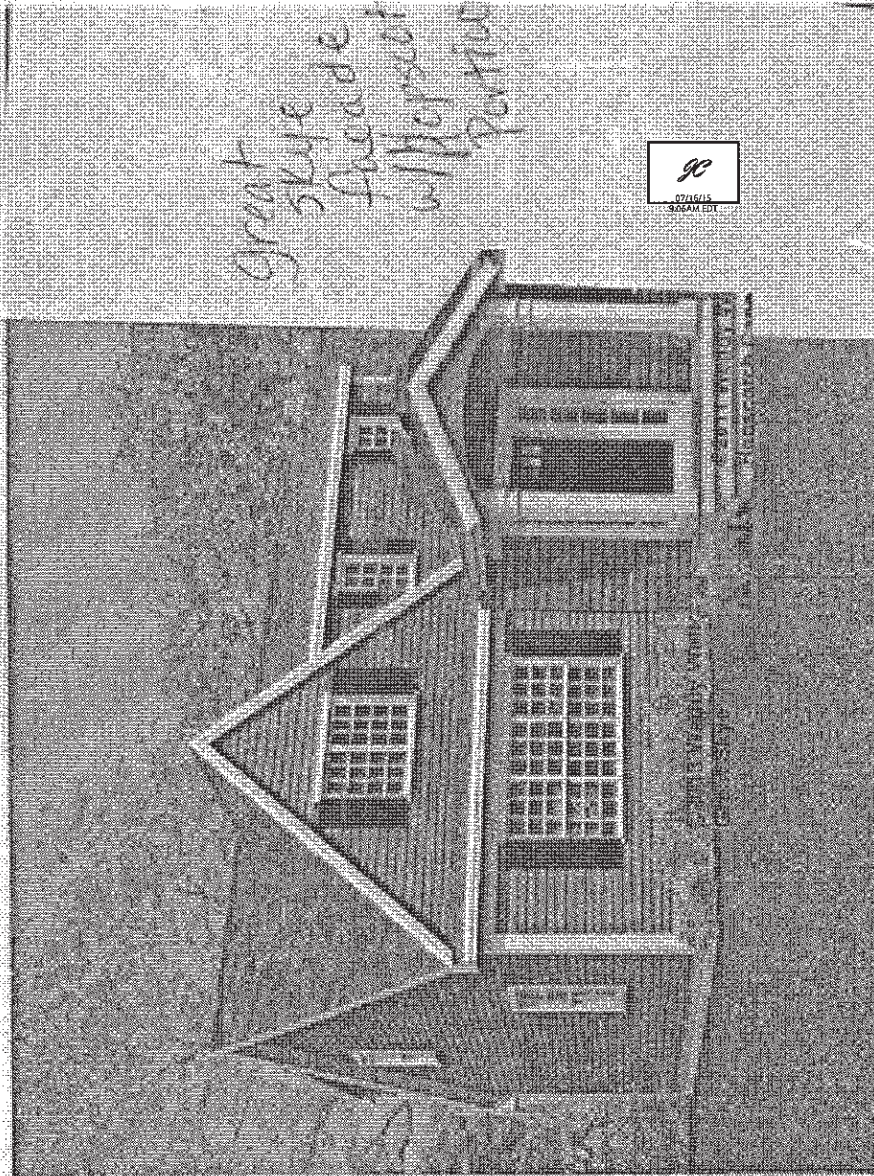

Some items shown are optional and/or may vary. Builder's written specifications always govern.

1. Gas fireplace and it's surround or mantel
2. Kitchen - island, cabinet style & trim, countertop material, etc.
3. Door styles and trim
4. Window grilles and trim, window treatments
5. Stair balusters or low walls at stairs
6. Lighting
7. Material selections (flooring, siding, roofing, paint colors, etc.)
8. Other furnishings
9. Landscaping, paving and walkways
10. Gutters, shutters and other exterior trim components
11. Deck, size, railing style, stair location, etc.
12. Amount of exposed basement and/or wood framed walls at basement

These images are not of any specific building site. Sun and view through windows will vary, as will the site around the house on the exterior and the slope of the land.


JP  
07/19/15  
10:37AM EDT




603-431-9559

© 2012 Wendy Wilson. All rights reserved. You may not build this design without purchasing a license, even if you make changes. This design may have geographic restrictions.


**Great Skye**  
635.124


 R Artform  
 Handwriting  
 10/10/2010  
 10/10/2010

Har  
off  
year  
of deck  
or  
side  
of  
deck

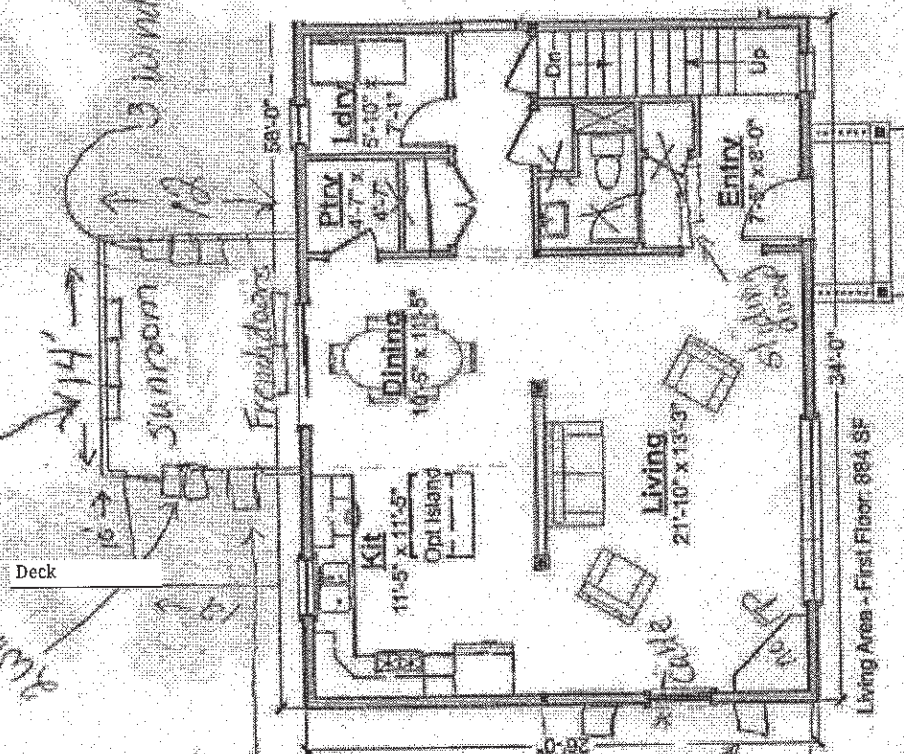

Harcourt Portico

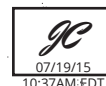

*Gamine Comito*

dotloop verified  
07/16/15 8:37AM EDT  
Z6C6-SOMD-G9LH-XU01



07/16/15  
9:56AM EDT

07/19/15  
10:37AM EDT

