


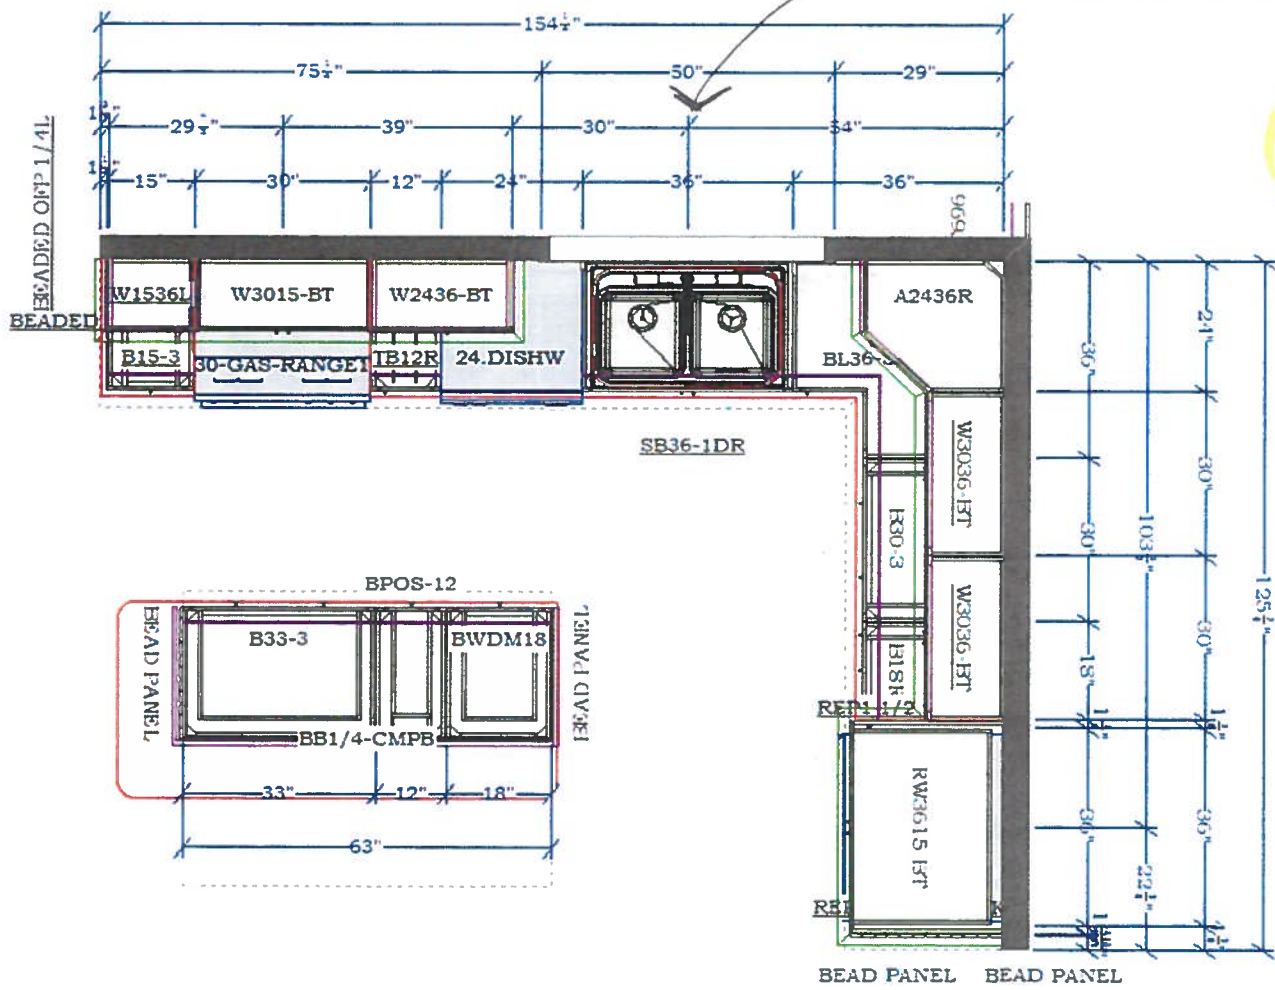

CENTERLINE OF WINDOW FROM RH CORNER = 54" FINISHED (54.5" FRAMED ONLY)

LOT #1
KILEY

FINAL DESIGN 4/21

APPROVED: _____

DATE: _____

CLIENT NAME:	GREEN & CO.
ADDRESS	HAMPTON WOODS
CITY / STATE:	NORTH HAMPTON
CONTRACTOR:	GREEN & CO.
DATE:	April 22, 2014

THESE DRAWINGS ARE A CONCEPT OF WHAT YOUR FINISHED PROJECT MAY LOOK LIKE, AND ARE NOT AN EXACT REPRESENTATION. THESE DRAWINGS SHOULD BE USED FOR LAYOUT & CONCEPTUAL PURPOSES, BUT ALL MEASUREMENTS AND CONDITIONS NEED TO BE FIELD VERIFIED FOR ACCURACY. THESE DRAWINGS REMAIN THE PROPERTY OF PLAISTOW CABINET COMPANY AND MAY NOT BE REPRODUCED WITHOUT PRIOR APPROVAL.

PLAISTOW
CABINET COMPANY
56 NEWTON ROAD - PLAISTOW, NH 03865 - (603) 382-1098
www.plaistowcabinet.com

