

Job: Lorden 85 - Bhogal

- ① Expanded Plan
- ② Replace deck w/sun rm
- ③ Add pocket door or french double
- ④ Add pantry & wall oven
- ⑤ Relocate Bulkhead.

dotloop signature verification: drip-0000460-00000000


Sir Isaac Newton

627.124.v9 GR (11/12/2020)

© 2017-2020 Art Form Architecture, Inc., all rights reserved.
You may not build this design without purchasing a license,
even if you make changes. This design may have geographic
restrictions.

Artform Home Plans

603-431-9559

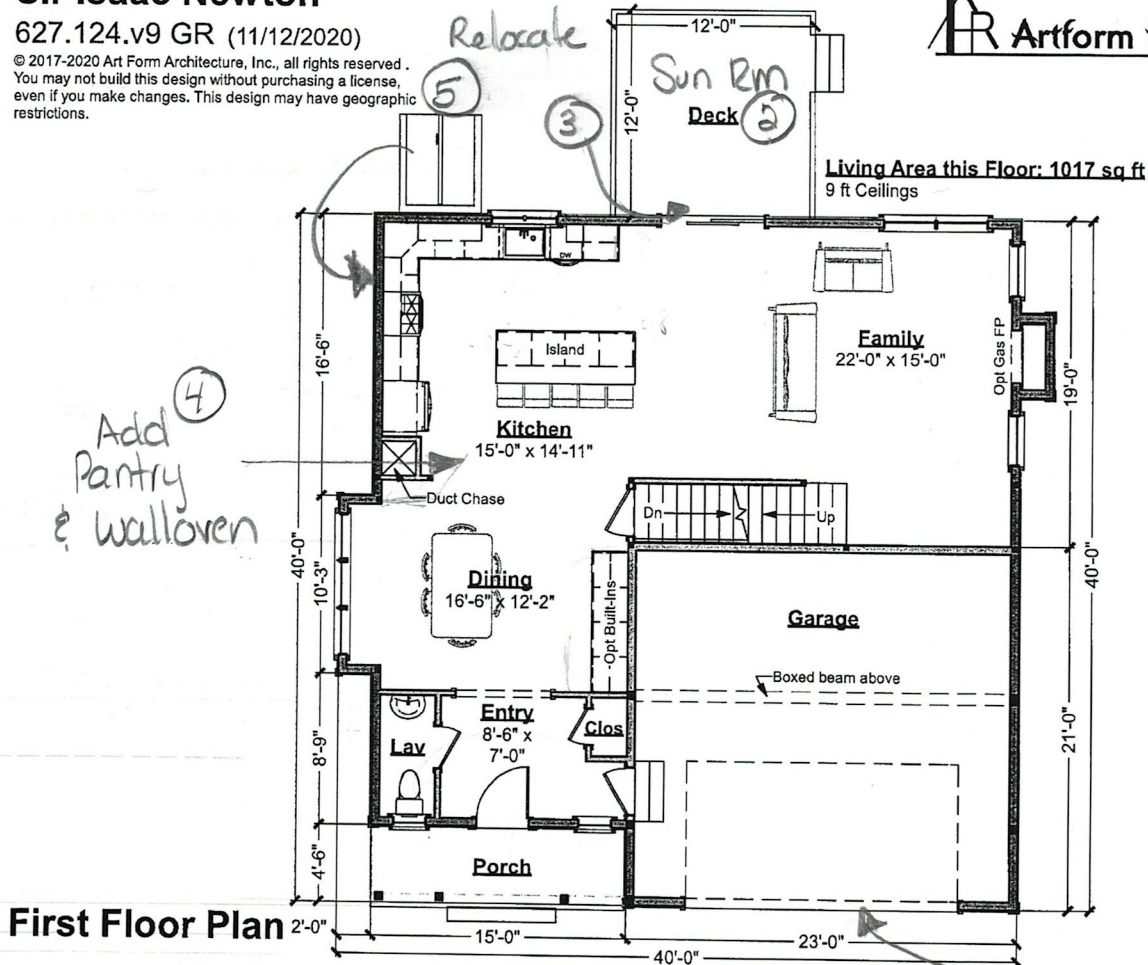

25B
12/28/20
8:39 PM EST
dotloop verified

xc

2nd Floor
9' Ceilings?

- ⑥ Rework Laundry & add closet to Bedroom
- ⑦ Relocate closet

dotloop signature verification: 1110.051455.1110.051455

Sir Isaac Newton

627.124.v9 GR (11/12/2020)

© 2017-2020 Art Form Architecture, Inc., all rights reserved .
You may not build this design without purchasing a license,
even if you make changes. This design may have geographic
restrictions.

⑥ include closet
space into Laundry
RM.

Artform Home Plans

603-431-9559


Living Area this Floor: 1388 sq ft
8 ft Ceilings

Rework to include
master bath w/soaking
tub - double vanity
& Master closet

25B
12/28/20
8:39 PM EST
dotloop verified

eliminate closet ⑦
Relocate closet

Relocate
master bath
& Master closet

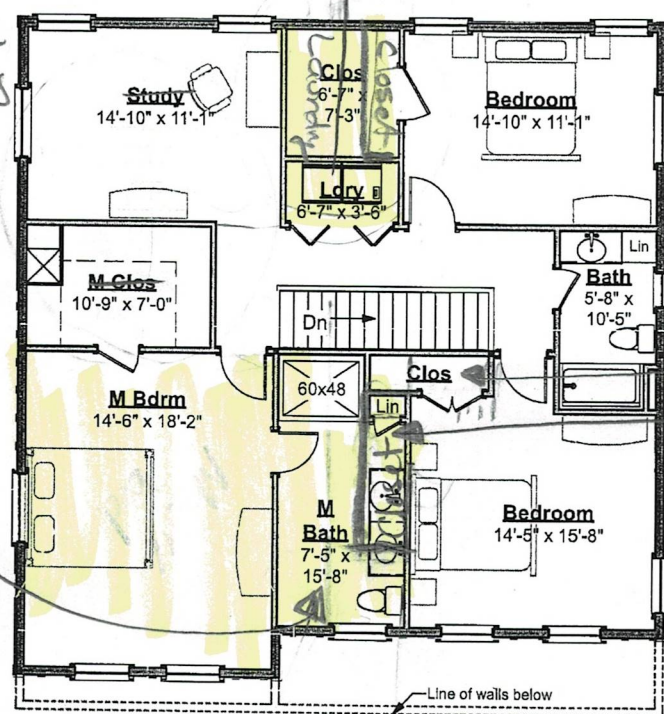

Second Floor Plan

XC

Basement
9' ceilings in basement?
Rough Plumbing in
basement

dotloop signature verification: <http://dotloop.com/verify/255B>


Sir Isaac Newton

627.124.v9 GR (11/12/2020)

© 2017-2020 Art Form Architecture, Inc., all rights reserved.
You may not build this design without purchasing a license,
even if you make changes. This design may have geographic
restrictions.

 **Artform Home Plans**


603-431-9559

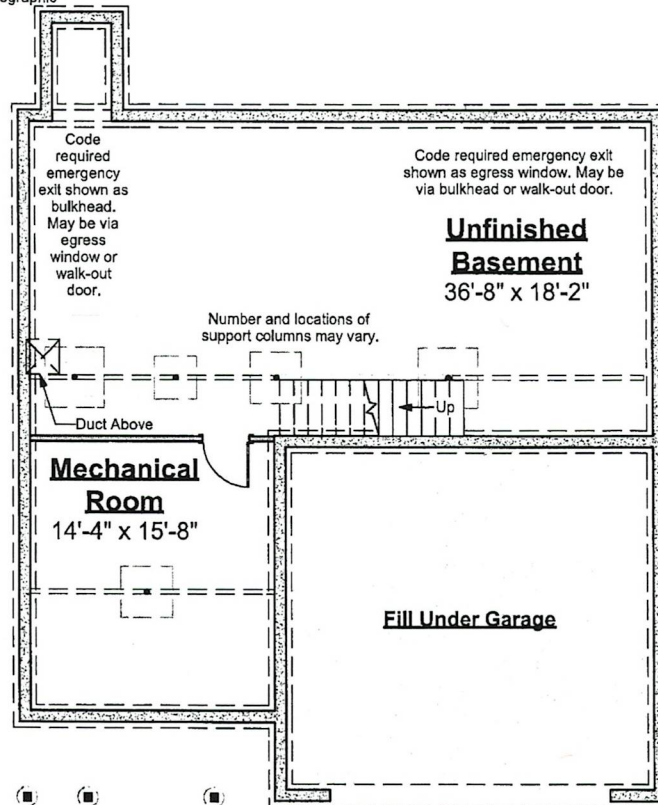

Foundation Plan

KC

Example of
preferred master
suite design

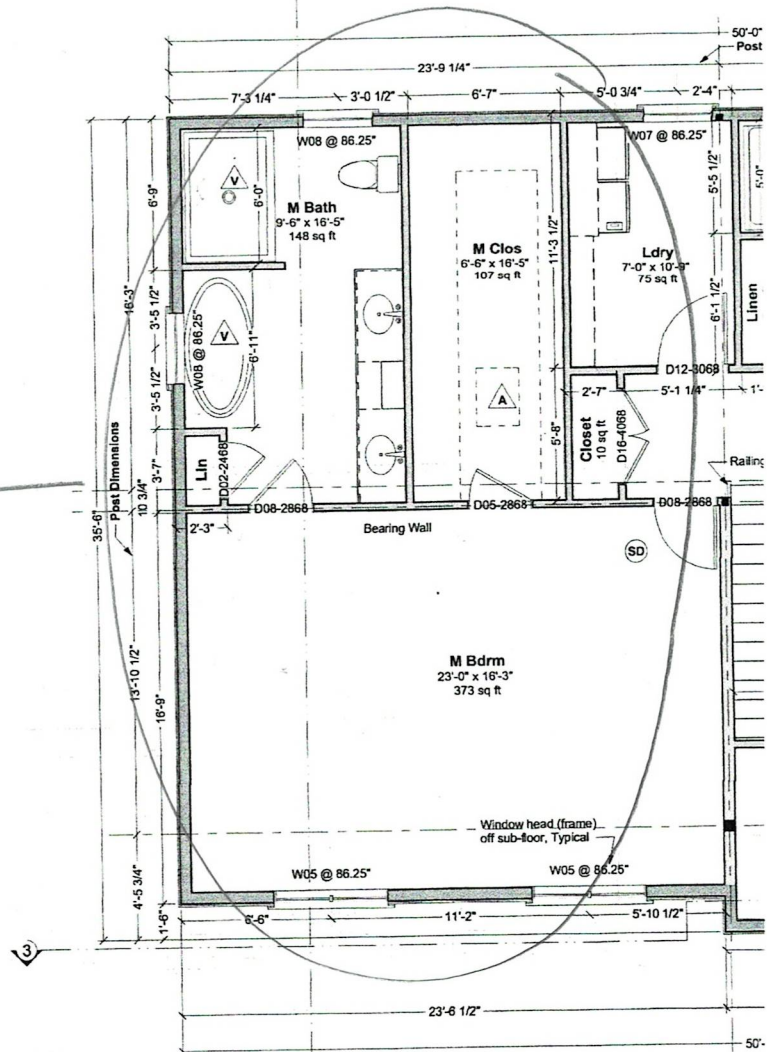

DOOR SCHEDULE						
NUMBER	QTY	FLOOR	SIZE	WIDTH	HEIGHT	TYPE
D01	1	1	1468 L IN	16"	80"	HINGED
D02	1	2	2468 R IN	28"	80"	HINGED
D03	1	1	2468 L IN	28"	80"	HINGED
D04	1	2	2668 L IN	30"	80"	HINGED
D05	2	2	2668 R IN	32"	80"	HINGED
D06	1	1	2668 R IN	32"	80"	HINGED
D07	2	1	2668 L IN	32"	80"	HINGED
D08	4	2	2668 L IN	32"	80"	HINGED
D09	1	0	2668 L IN	32"	80"	HINGED
D10	1	1	3068 L EX	36"	80"	HINGED
D11	1	1	3068 R EX	36"	80"	HINGED
D12	1	2	3068 R IN	36"	80"	HINGED
D13	1	2	2668 R	32"	80"	POCKET
D14	1	1	3068 L	36"	80"	POCKET
D15	1	1	3668 L/R IN	42"	80"	DOUBLE HINGED
D16	2	2	4068 L/R IN	48"	80"	DOUBLE HINGED
D17	2	1	5068 L/R IN	60"	80"	DOUBLE HINGED
D18	1	1	5880	68"	96"	MULLED UNIT
D19	1	1	6068 R EX	72"	80"	SLIDER
D20	2	1	9090	108"	96"	GARAGE

NUMBER	QTY	WIDTH	HEIGHT	R/O	EGRESS
W01	2	23 1/2"	23 1/2"	24"X24"	YES
W02	1	35 1/2"	23 1/2"	36"X24"	
W03	1	27 1/2"	47 1/2"	28"X48"	
W04	1	47"	47 1/2"	47 1/2"X48"	
W05	2	59"	47 1/2"	59 1/2"X48"	YES
W06	2	23 1/2"	47 1/2"	24"X48"	
W07	1	35 1/2"	47 1/2"	36"X48"	
W08	3	35 1/2"	47 1/2"	36"X48"	
W09	2	35 1/2"	65 1/2"	36"X66"	
W10	2	35 1/2"	65 1/2"	36"X66"	YES
W11	5	38"	61 1/2"	38 1/2"X62"	YES
W12	1	71"	65 1/2"	71 1/2"X66"	
W13	1	106 1/2"	65 1/2"	107"X66"	