

# Lot 1 Brads Landing

Opal Marquise, 30x28

370.124.v14 GL (6/30/2020)

© 2011-2020 Art Form Architecture, Inc., all rights reserved. You may not build this design without purchasing a license, even if you make changes. This design may have geographic restrictions.

 Artform Home Plans

603-431-9559

△ THIS facade

Add (2) Full size DH to front of Garage

△ SIDE LOAD GARAGE

white doors

△ larger windows



Alt. Color Option

# Opal Marquise, 30x28

370.124.v14 GL (6/30/2020)

© 2011-2020 Art Form Architecture, Inc., all rights reserved. You may not build this design without purchasing a license, even if you make changes. This design may have geographic restrictions.




603-431-9559

*Extend deck to 10x16*

*leave deck as is Per 3.23.2021 Followup email*

*Make garage 24x24  
3.23.21 - Followup email*

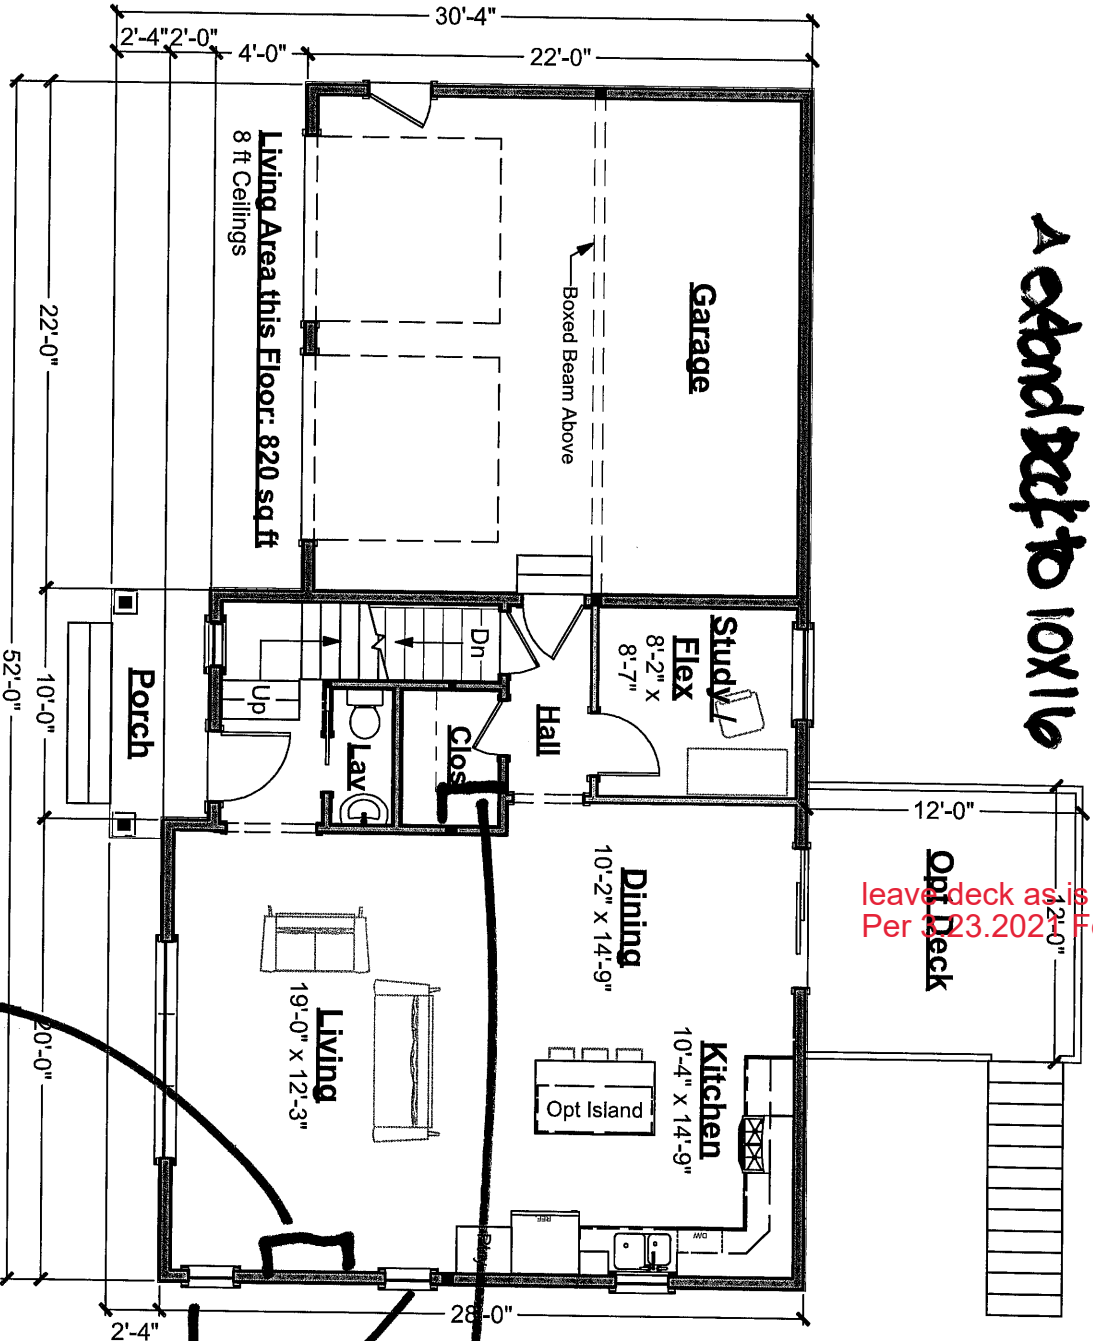

*Add fireplace*

*First Floor Plan*

*Scale: 1/8" = 1'-0"*

*Add duct chase*

*swing windows floor*


# Opal Marquise, 30x28

370.124.v14 GL (6/30/2020)

© 2011-2020 Art Form Architecture, Inc. All rights reserved. You may not build this design without permission. Even if you make changes, this design is not a new design. Restrictions.

Extend 4' here  
Artform Home Plans

603-431-9559

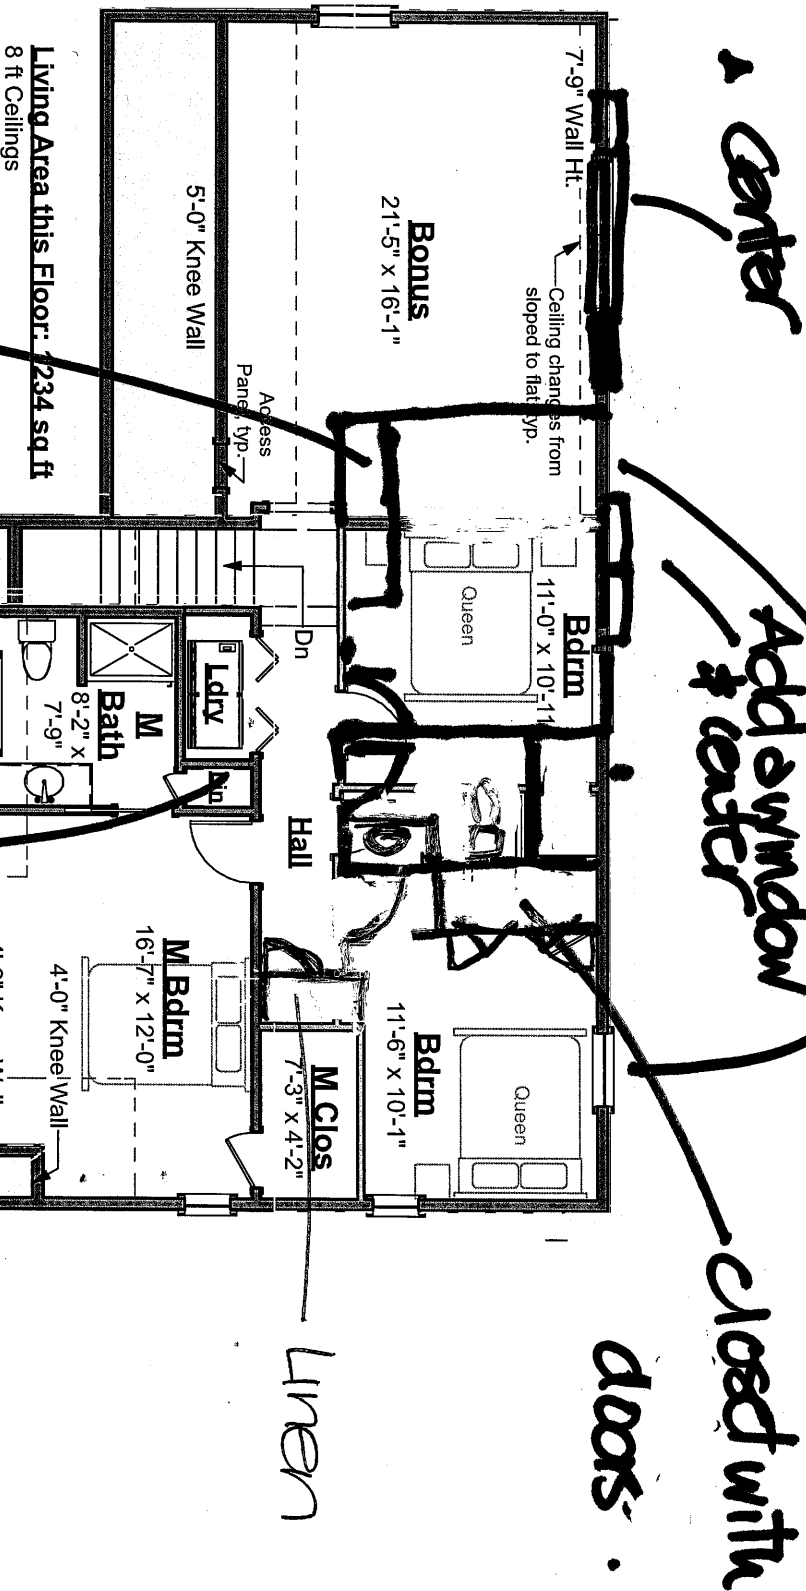

closet with sliding doors

And check

Second Floor Plan


Scale: 1/8" = 1'-0"

**Opal Marquise, 30x28**  
370.124.v14 GL (6/30/2020)

© 2011-2020 Art Form Architecture, Inc., all rights reserved.  
You may not build this design without purchasing a license,  
even if you make changes. This design may have geographic  
restrictions.

**Artform Home Plans**

603-431-9559

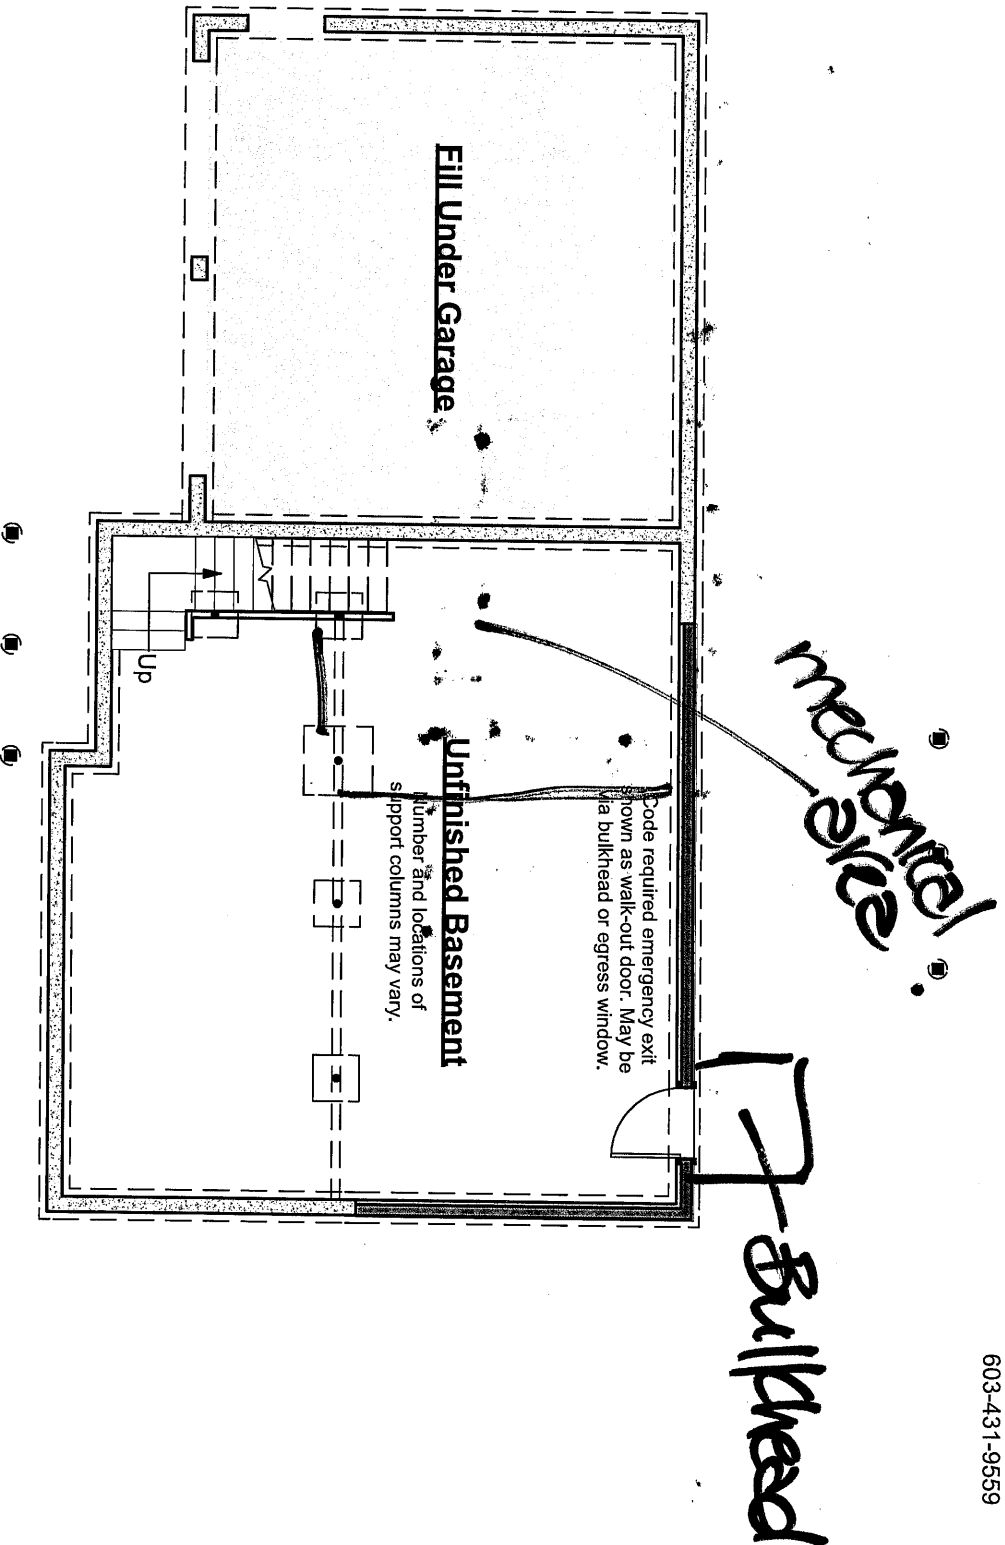

**Foundation Plan**  
Scale: 1/8" = 1'-0"