


© 2014 Wendy Welton, all rights reserved . You may not build this design without purchasing a license, even if you make changes. This design may have geographic restrictions.



603-431-9559

Configuration:
127 Robin, Classic with Wing
2nd Floor
Living Area this Floor: 1353 SF

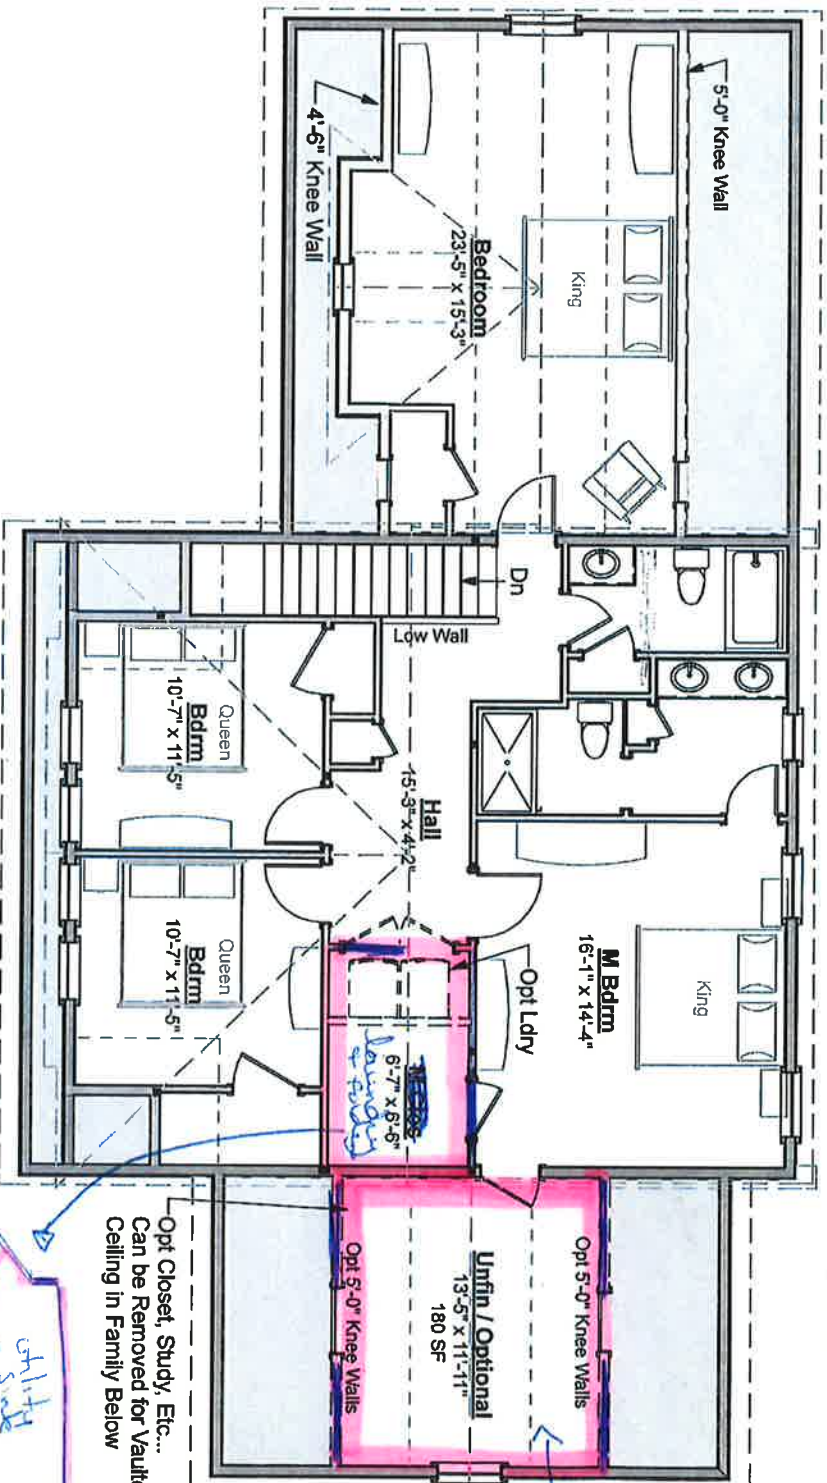

Furnish
as a
basic
closet

**—Opt Closet, Study, Etc...
Can be Removed for Vaulted
Ceiling in Family Below**

A hand-drawn diagram of a rectangular box. The top edge is labeled "width" with a double-headed arrow. The right edge is labeled "height" with a double-headed arrow. The bottom edge is labeled "depth" with a double-headed arrow. The front face of the box is divided into two sections: a smaller rectangle on the left and a larger rectangle on the right. The left section is labeled "smaller" with a double-headed arrow. The right section is labeled "larger" with a double-headed arrow. The entire box is outlined with a thick black line.

Second Floor Plan

4/1/2014
495.127


Robin Classic w Wing

© 2014 Wendy Welton, all rights reserved. You may not build this design without purchasing a license, even if you make changes. This design may have geographic restrictions.

Artform Home Plans

603-431-9559

Configuration:
127 Classic with Wing
1st Floor
Living Area this Floor: 1224 SF
9 ft Ceilings

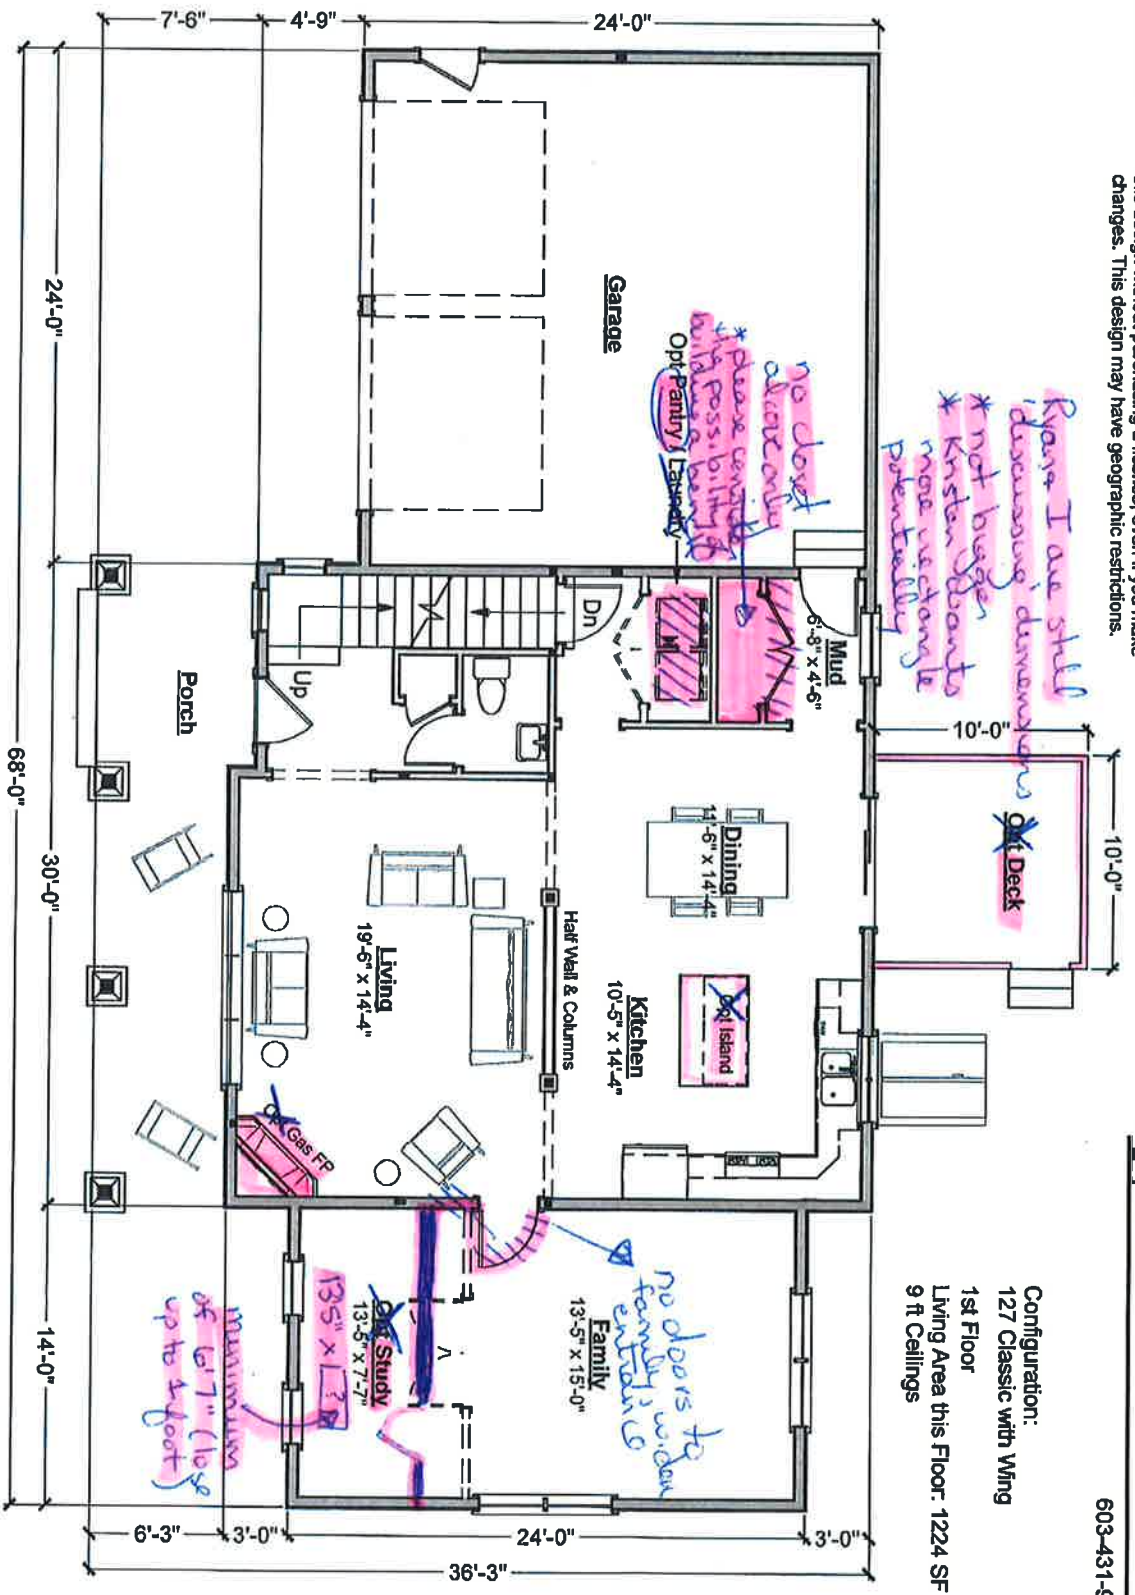

First Floor Plan