

Blueberry Grand Torte

1035.124 GL
(7/17/2020)

© 2020 Art Form Architecture, Inc., all rights reserved. You may not build this design without purchasing a license, even if you make changes. This design may have geographic restrictions.

Artform Home Plans

603-431-9559

Living Area This Floor: 1662 sq ft

8 ft Ceilings

Flip: Garage Right
Kitchen window: grids
Window grids: Top only
Slider: Clear

Change to triple full-size windows


Move transom window here

Barn Door slide left
Pocket Door

Shower, no tub

Double Doors (No bi-fold)

- Reconfig layout
- Add transom window high enough to allow for mirrors

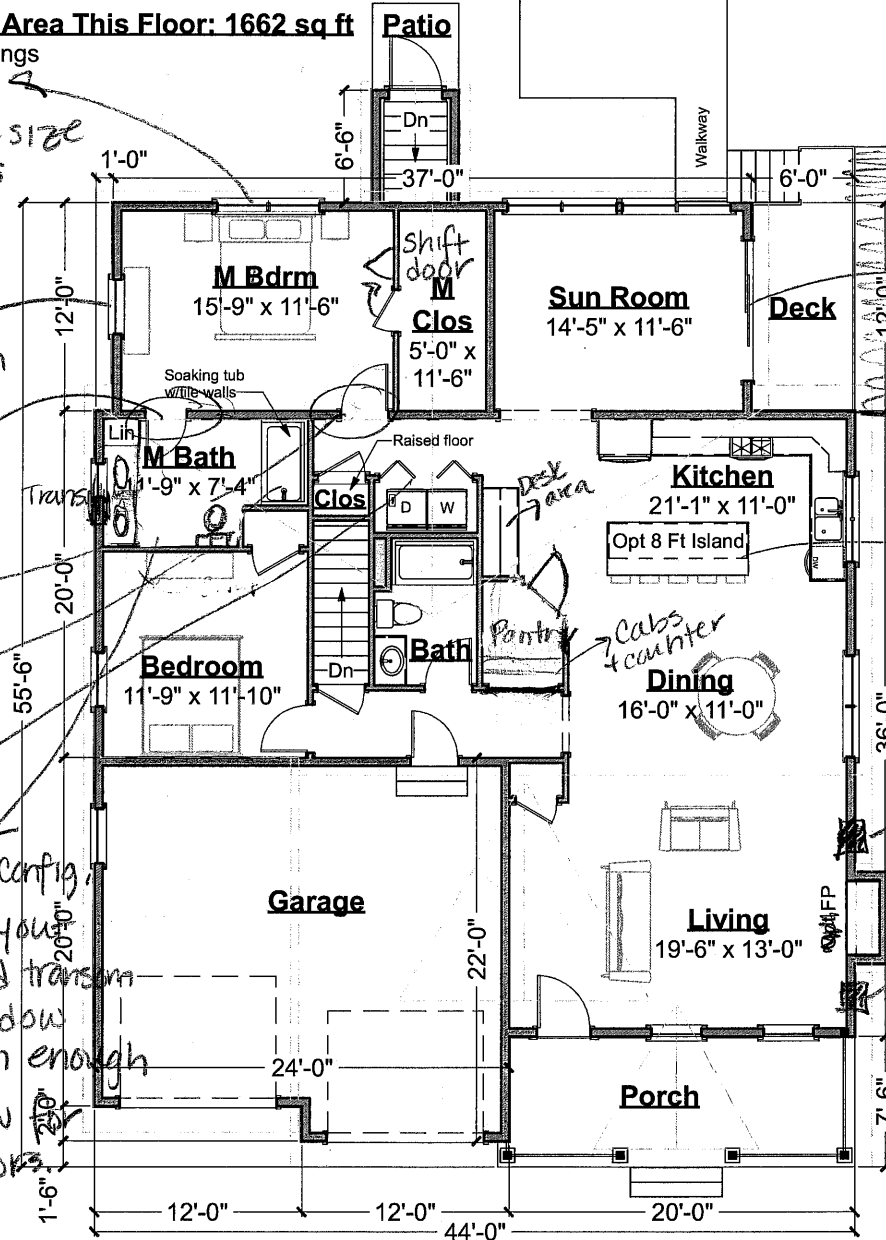

First Floor Plan
Scale: 3/32" = 1'-0"