

Raspberry Biscotti

564.144

© 2013 Art Form Architecture, Inc. All Rights Reserved . <http://www.artformhomeplans.com>

First Floor

Living Area: 1604 SF

Bedrooms: 3

Bathrooms: 2.5

Ceiling Height Shown: 8'-0"

Ceiling Height Possible*: 9'-0"

* -- Increasing ceiling height requires a Major Change.

The master bedroom wing in the rear can be expanded as much as your lot and budget allow. This plan also expands to the right if you have room on your lot.

Enlarge by 2'-0" FRT BACK
9 FT Ceilings
+ other changes

21x9

6x18


35x38

1729
1749
1869

<http://www.artformhomeplans.com/Contact.a5w>

Lot 11

Rocky Ridge
Nottingham
NH

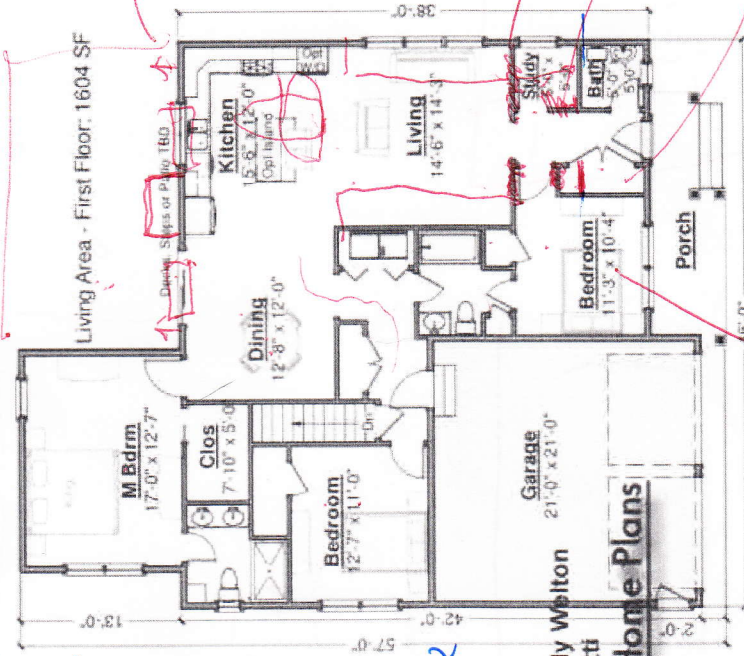

Bed/Study

18'0"

<http://www.artformhomeplans.com/TermsConditions.a5w>

DWL Builders

Artform Home Plans