


## Second Floor

### Floor Plan

New plans to be drawn with buyers and sellers satisfactory review.

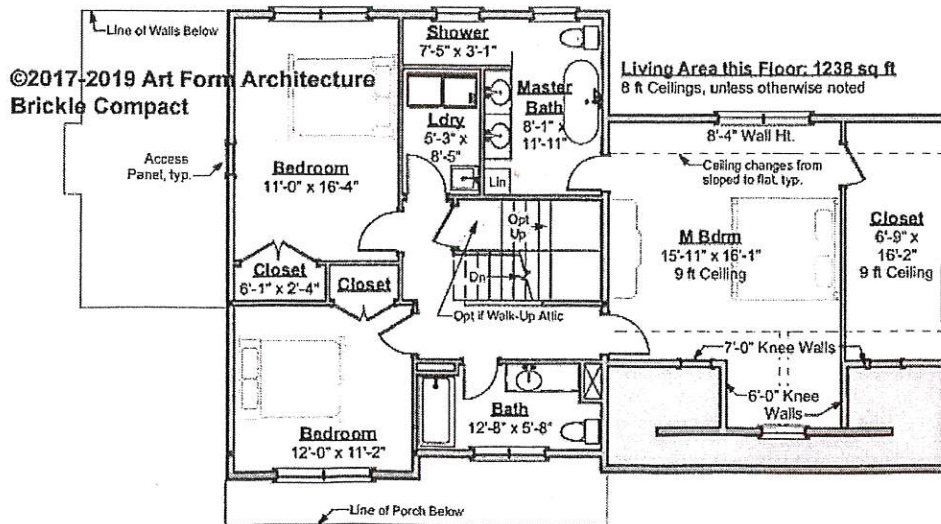

## Third Floor

### Floor Plan

Optional Living Area this Floor: 403 sq ft  
8 ft Ceilings