

April Tulip Classic w/ Wings



323.127.v6 KL

© 2010-2015 Artform Architecture, LLC, all rights reserved.
You may not build this design without purchasing a license,
even if you make changes. This design may have geographic
restrictions.



Artform Home Plans

603-431-9559

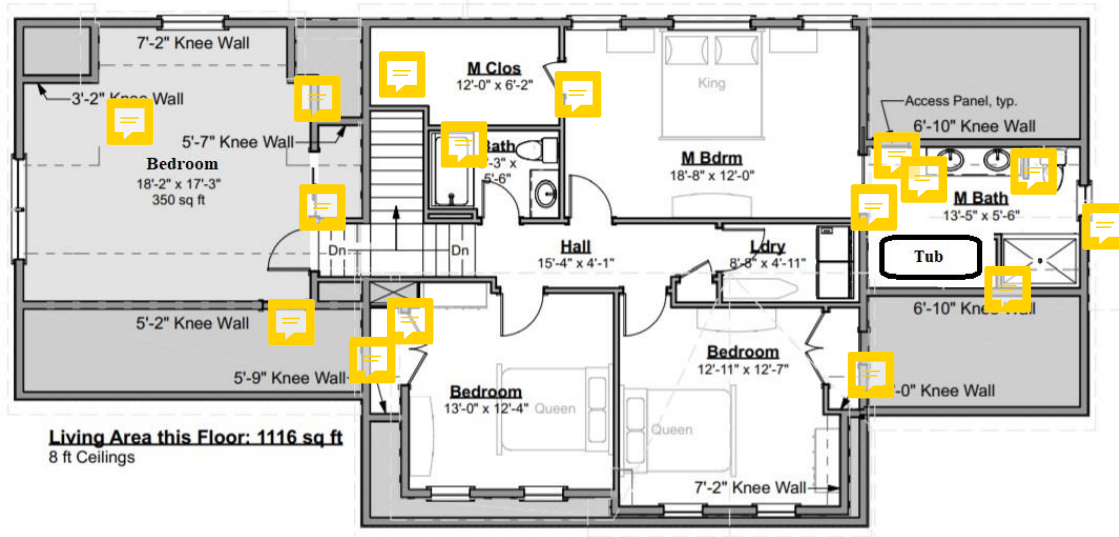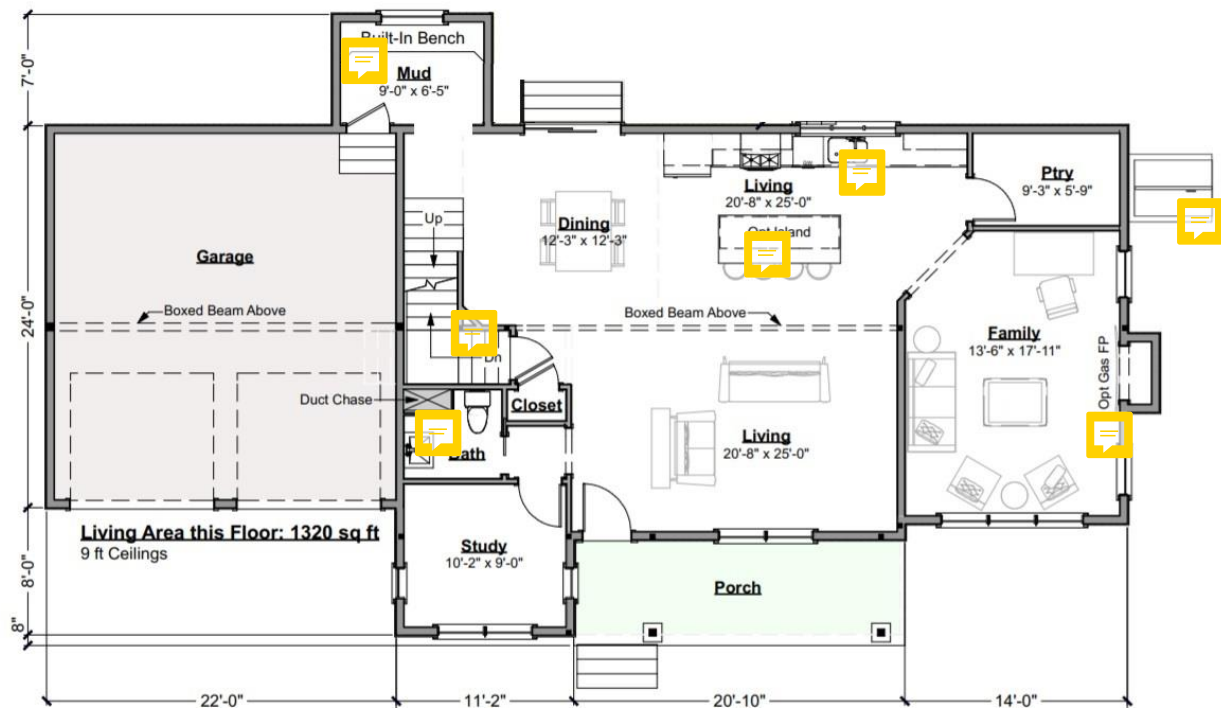

Second Floor Plan