


Emerald Sea Grande 320.012.001 © 2008-2012 Wendy Welton, all rights reserved

First Floor

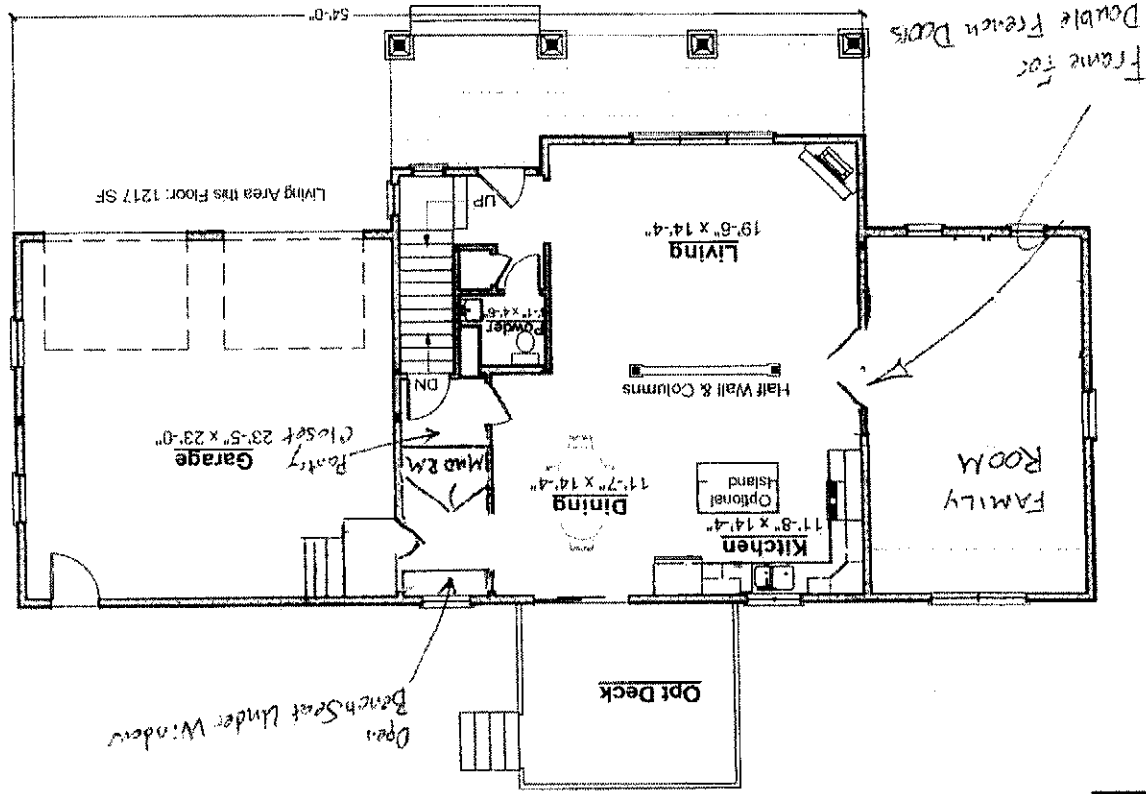

Artform Home Plans

Good Wendy

*Only 2nd Floor Change
 not landing at End of Hall as in
 it is forced*