


April Yarrow

326.003

© 2010-2011 Wendy Welton, all rights reserved



First Floor

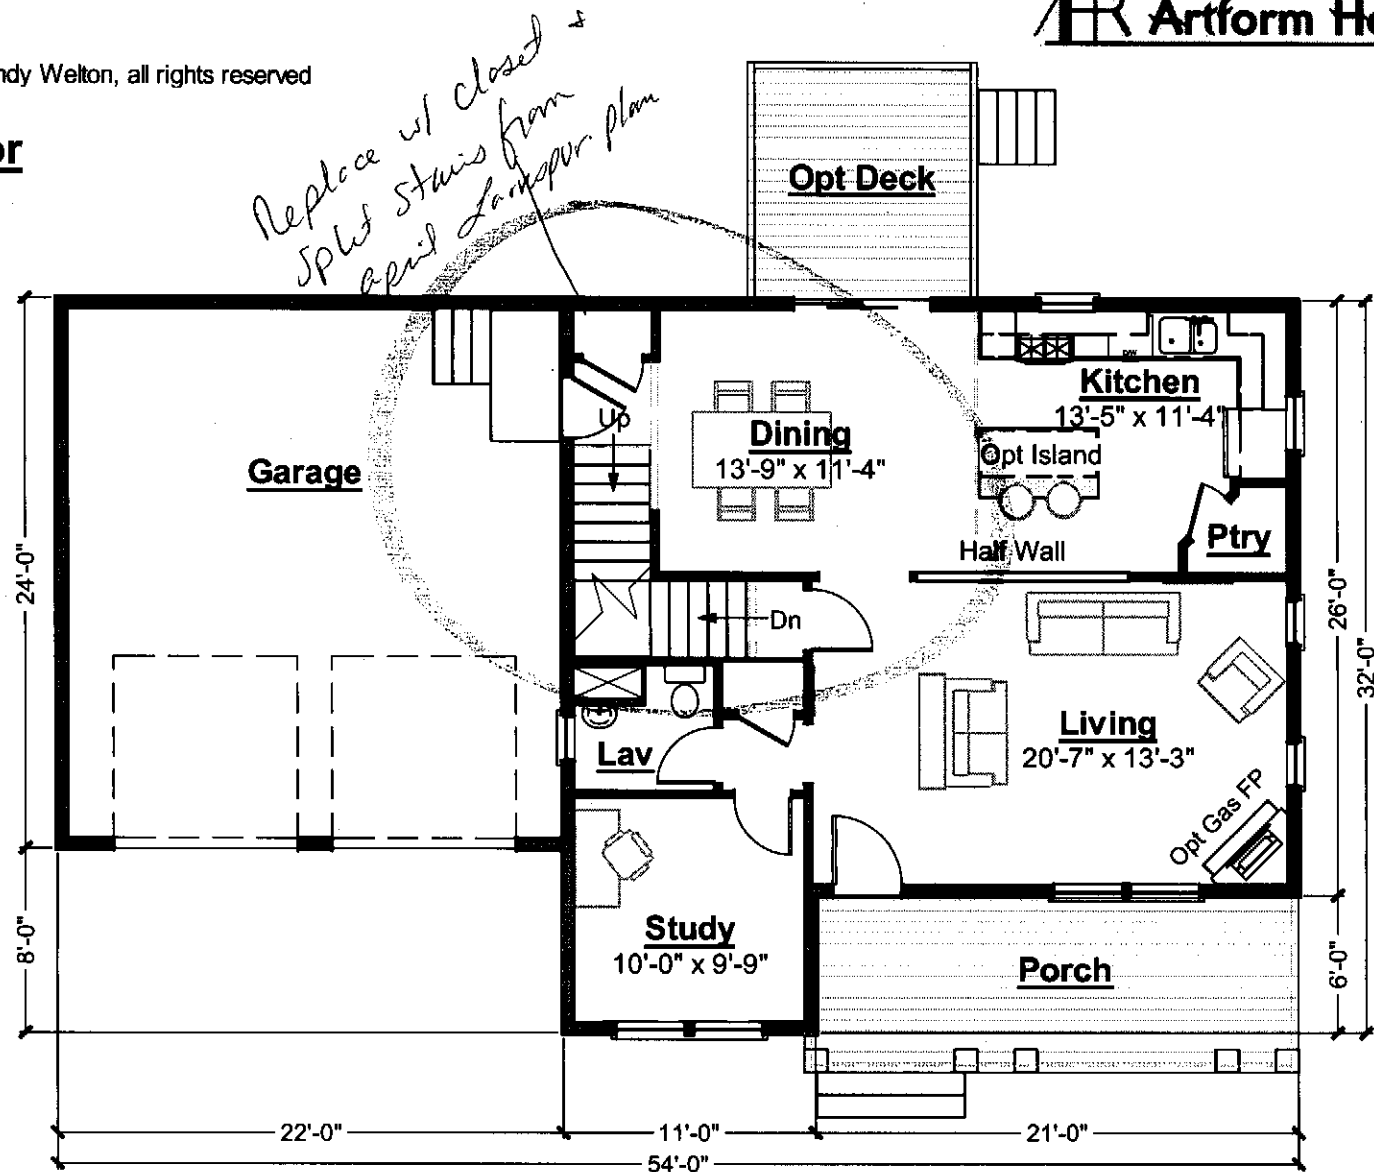

April Larkspur

325.003

© 2010-2011 Wendy Welton, all rights reserved



First Floor

