


Vanilla Crescent

668.124 KR © 2014 Wendy Welton, all rights reserved. You may not build this design without purchasing a license, even if you make changes. This design may have geographic restrictions.

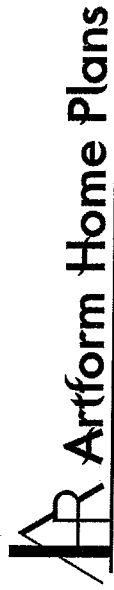


603-431-9559

LOT 23 ROCK

6/1 windows

- 1) Slider to Fall view door
- 2) new Kitchen Layout - ADD window
- 3) Remove 2 windows in Dining
- 4) 2 single windows vs. mullion in LR
- 5) Front windows to be a triple
- 6) DO Flora Porch

- 7) 6 over 1 windows
- 8) ADD Slider + window TO Basement

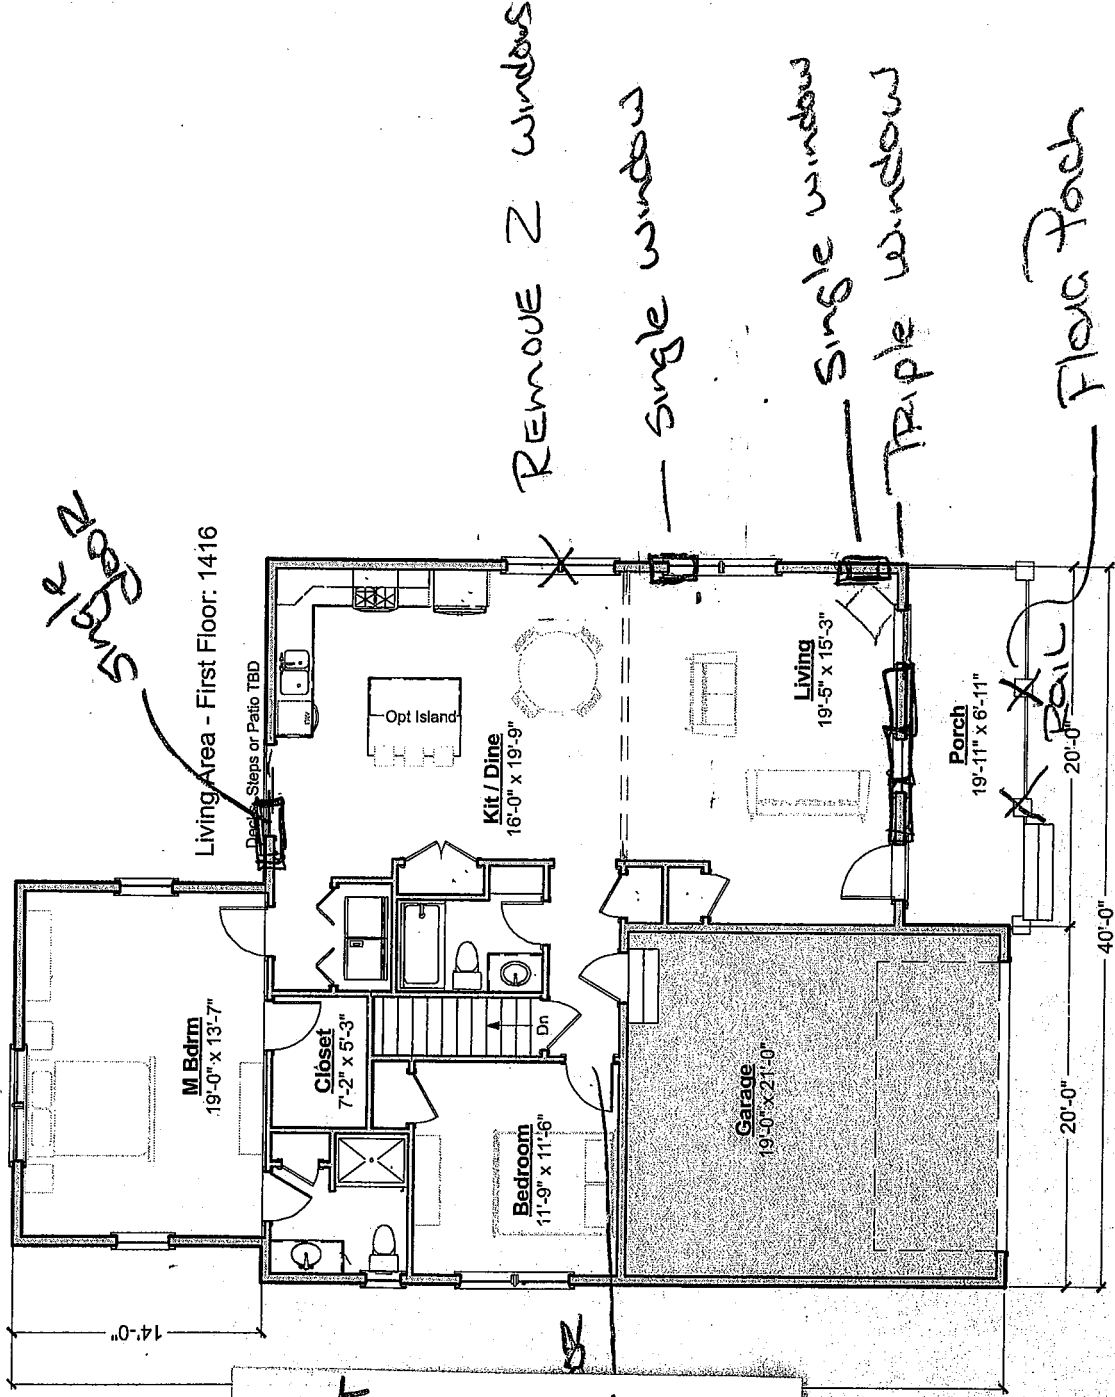


Vanilla Crescent

668.124 KR © 2014 Wendy Welton, all rights reserved. You may not build this design without purchasing a license, even if you make changes. This design may have geographic restrictions.

sliding

Window

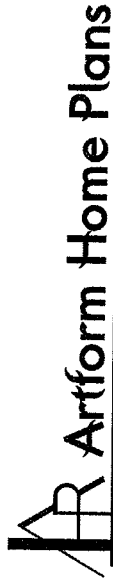

603-431-9559

