

1/20/2021

Opal Marquise Classic


370.124.v17 GL (1/20/2021)

© 2011-2021 Art Form Architecture, all rights reserved . You may not build this design without purchasing a license, even if you make changes. This design may have geographic restrictions.


Reconfigure Laundry/Mudroom Area according to Alternate Drawing



603-431-9559

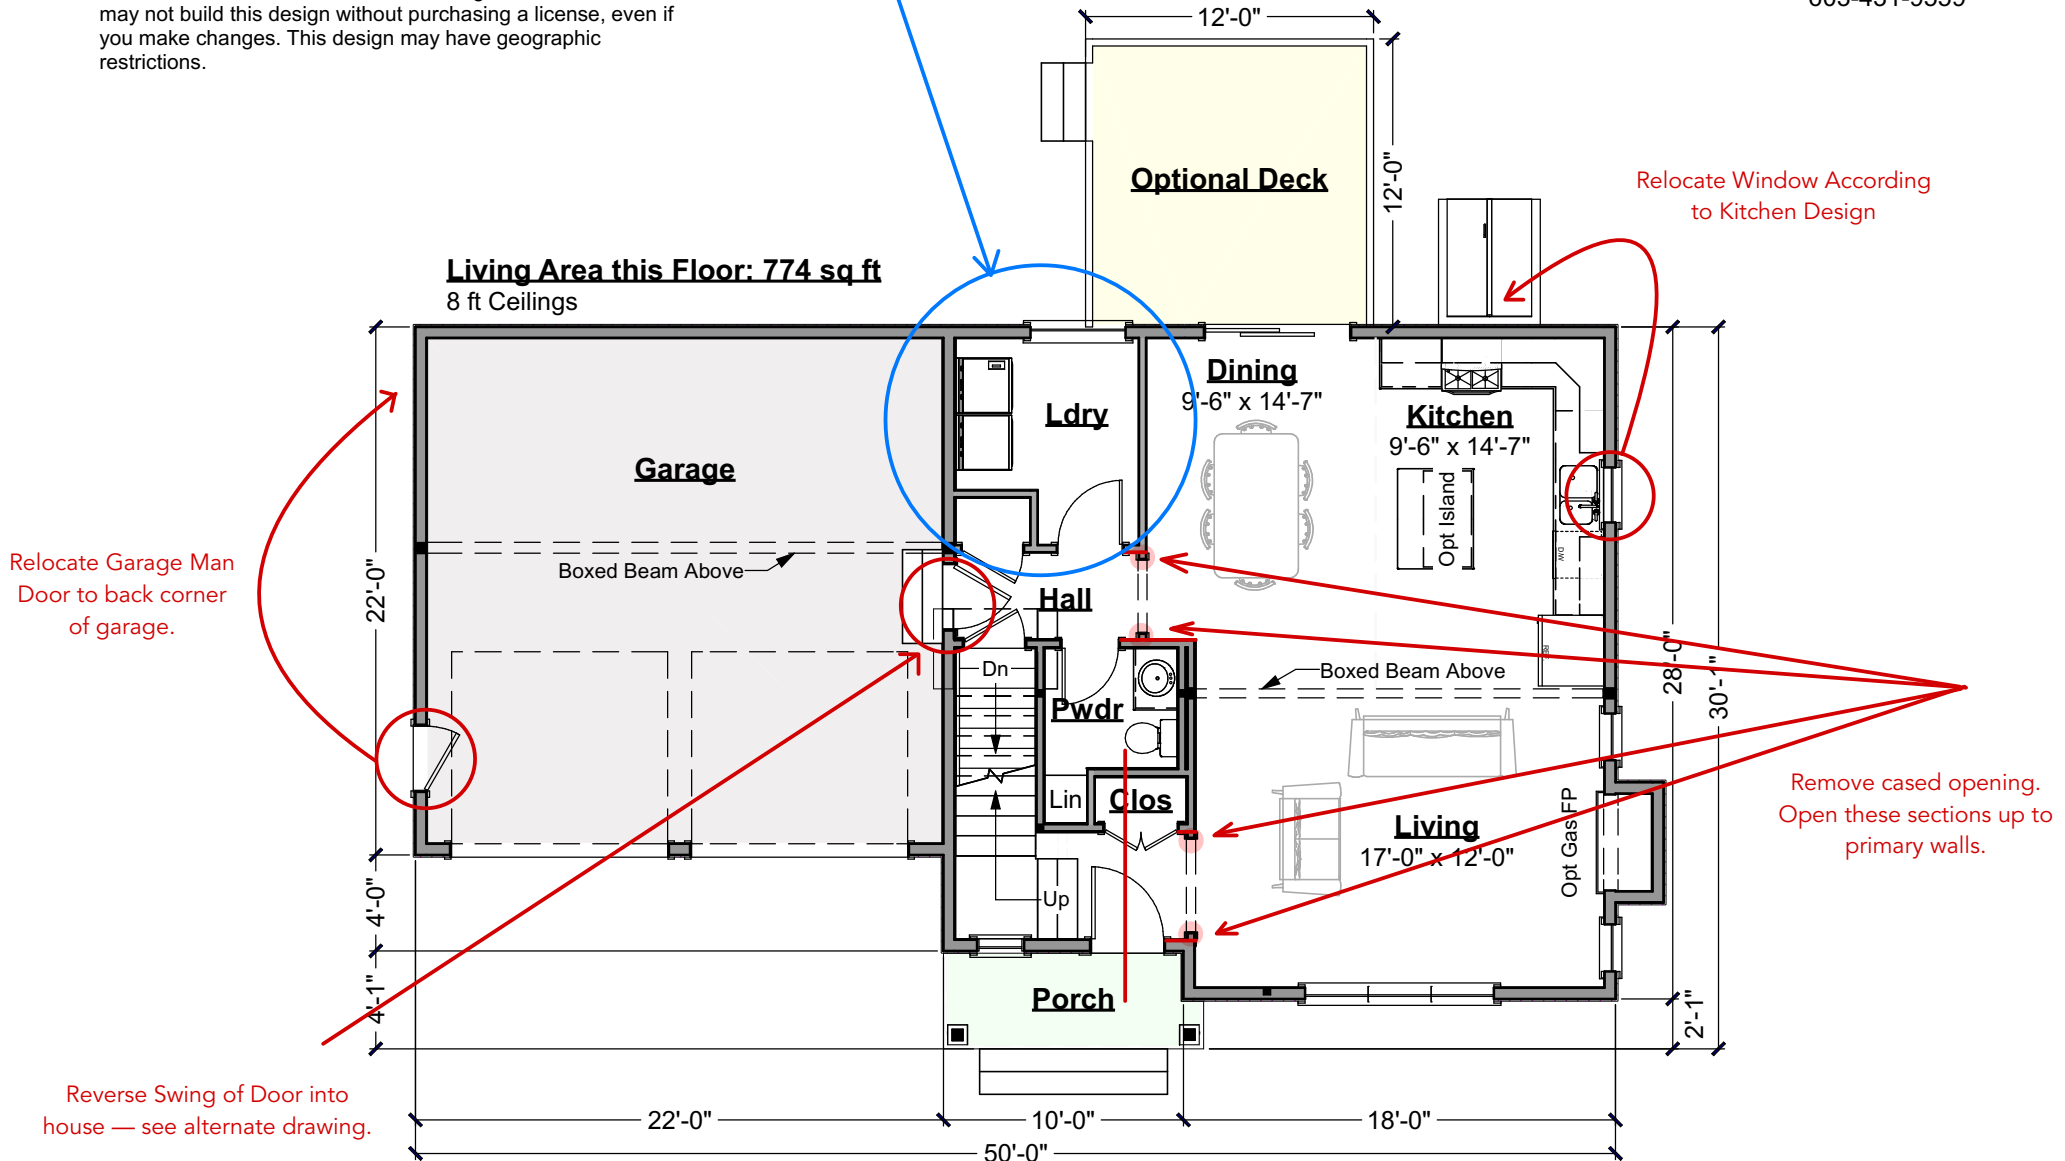

First Floor Plan
Scale: 1/8" = 1'-0"

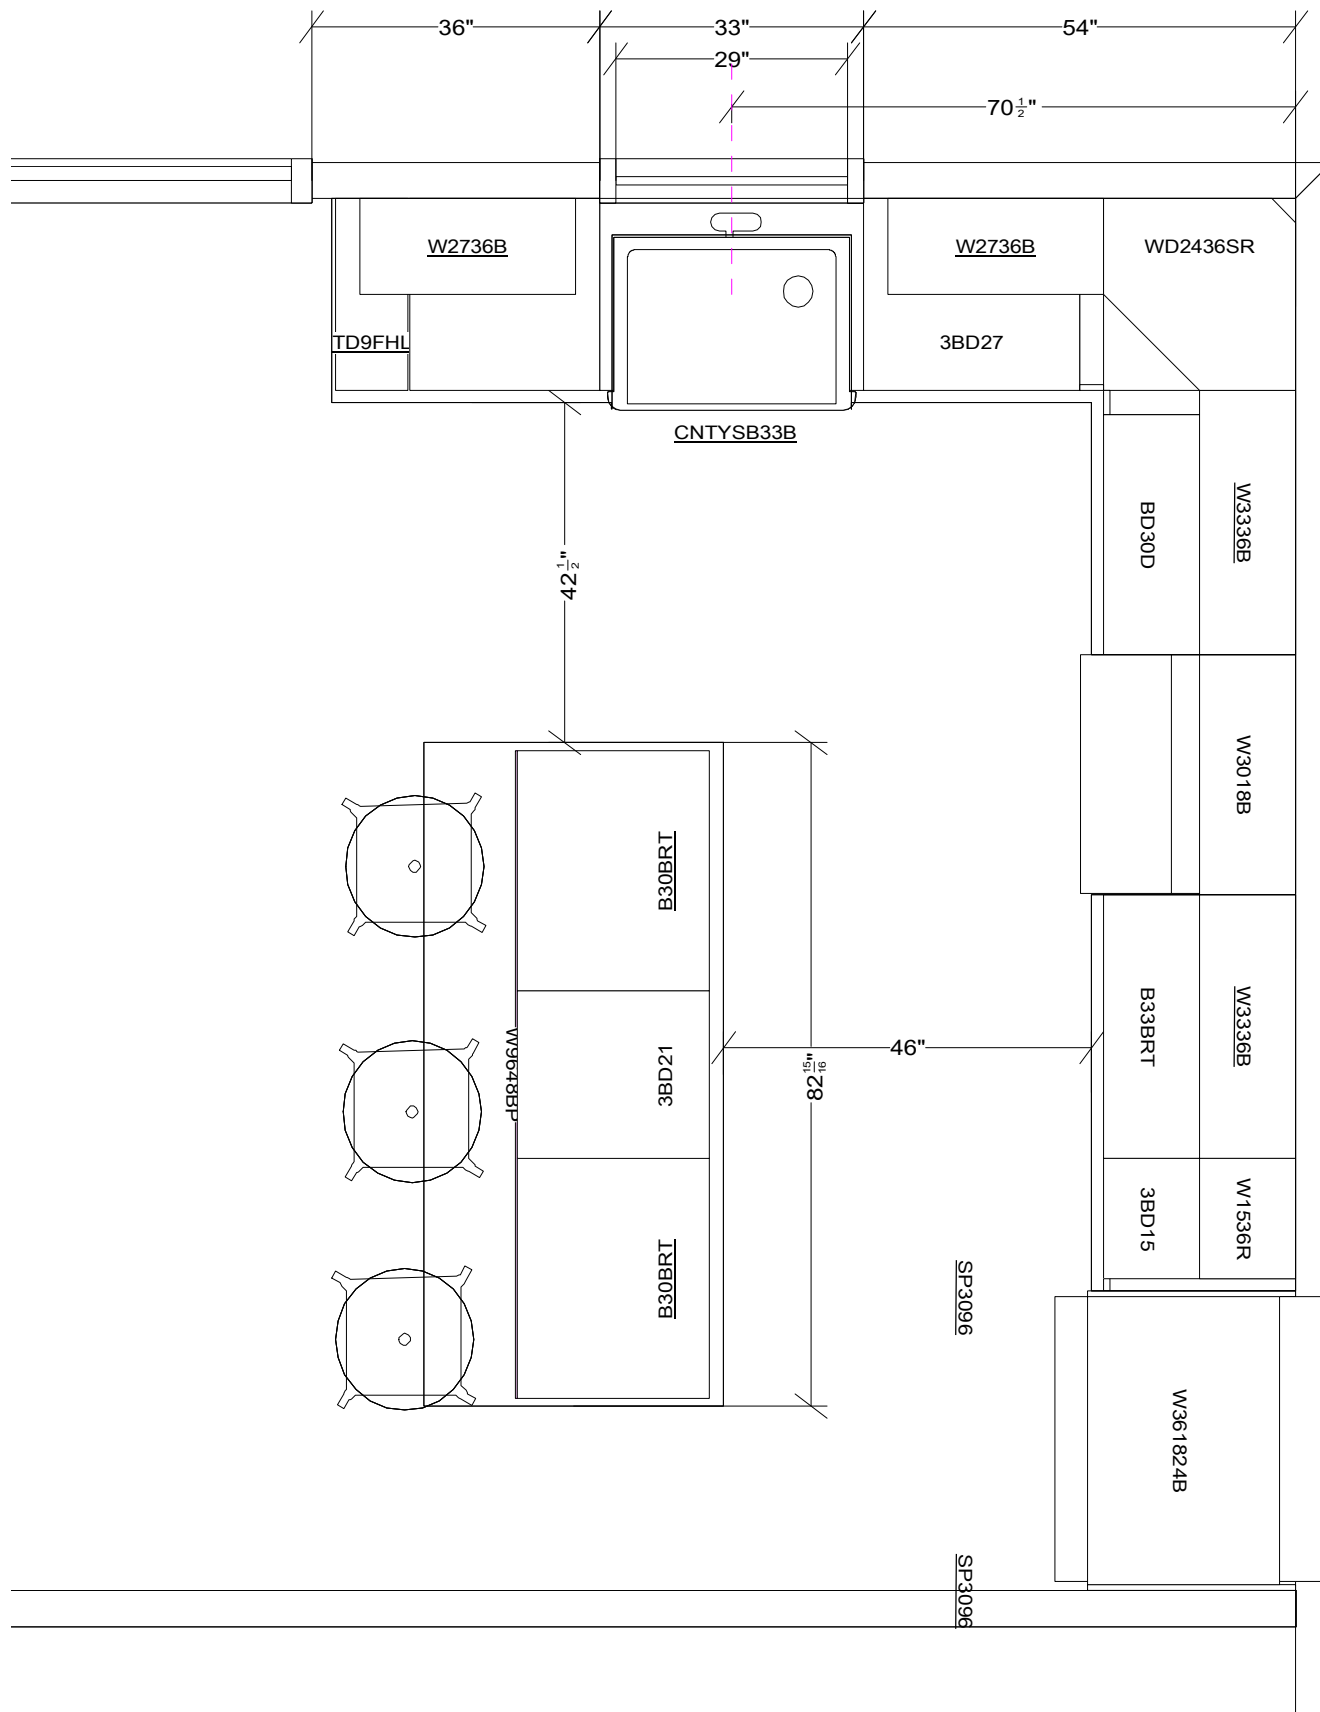

All dimensions _size designations given are subject to verification on job site and adjustment to fit job conditions.



This is an original design and must not be released or copied unless applicable fee has been paid or job order placed.

Designed: 4/9/2021
Printed: 4/15/2021