

[Login](#) | [Sign-Up](#) | [View Cart](#) (empty)[Home](#) | [My Account](#) | [About Us](#) | [Contact Us](#)

Artform Home Plans

603.431.9559

[Home](#) [Photos & Builder Galleries](#) [Service for Homeowners](#) [Service for Builders](#) [Prices & Details](#) [About Us](#)

Plans by Lifestyle

Downloadable PDF

Aging in Place

For empty nesters, 1st floor masters, etc

Generations™

For 3 generation families

Home Works™

Include work spaces large and small

Entertainers™

Entertainment friendly, all sizes

Simple Family™

2 1/2 kids, with or without the dog!

by Size\Complexity

Small Wonders

Small Home Plans - LEED neutral or better

Good Manors

A better way to do the modern "Manor" house

Expandables

Include unfinished

Ask

Relatively simple framing and lines

Patron

More complex shape, framing or detailing


Special Pricing

Free & Honor

Free or discounted to veterans


Strawberry Ranch



Strawberry Ranch has a peekaboo shed dormer that's not one of those fake ones you see on ranches. It brings light into the vaulted Living, Dining and Kitchen!

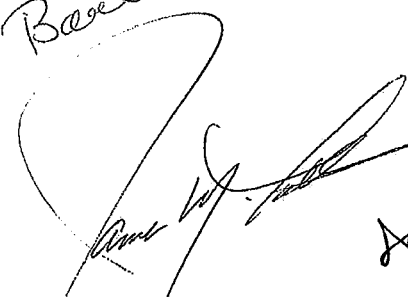11/23/13 Barbara Felle's

 XC

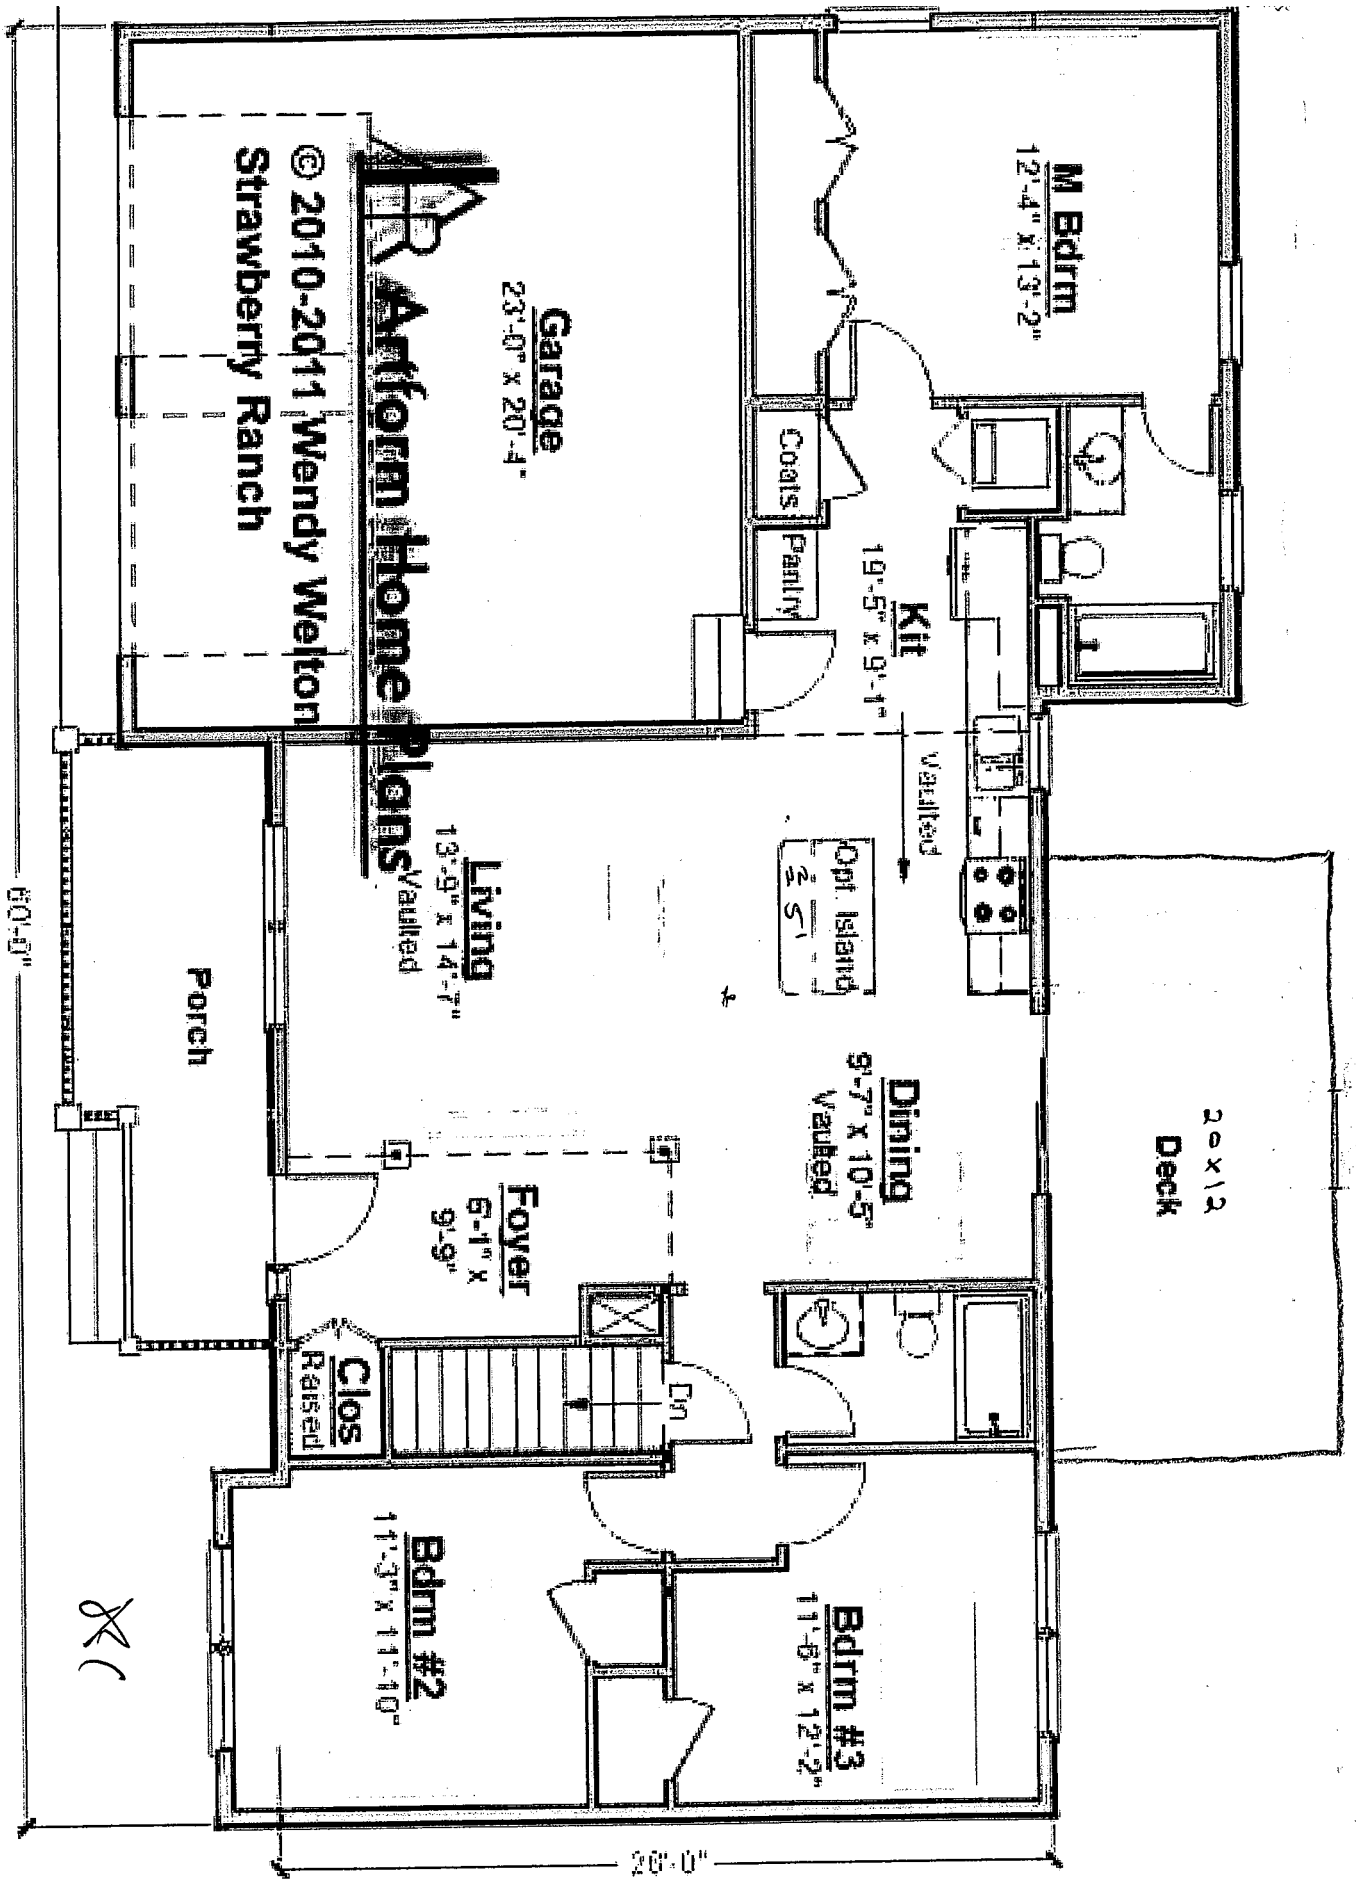

mirror image

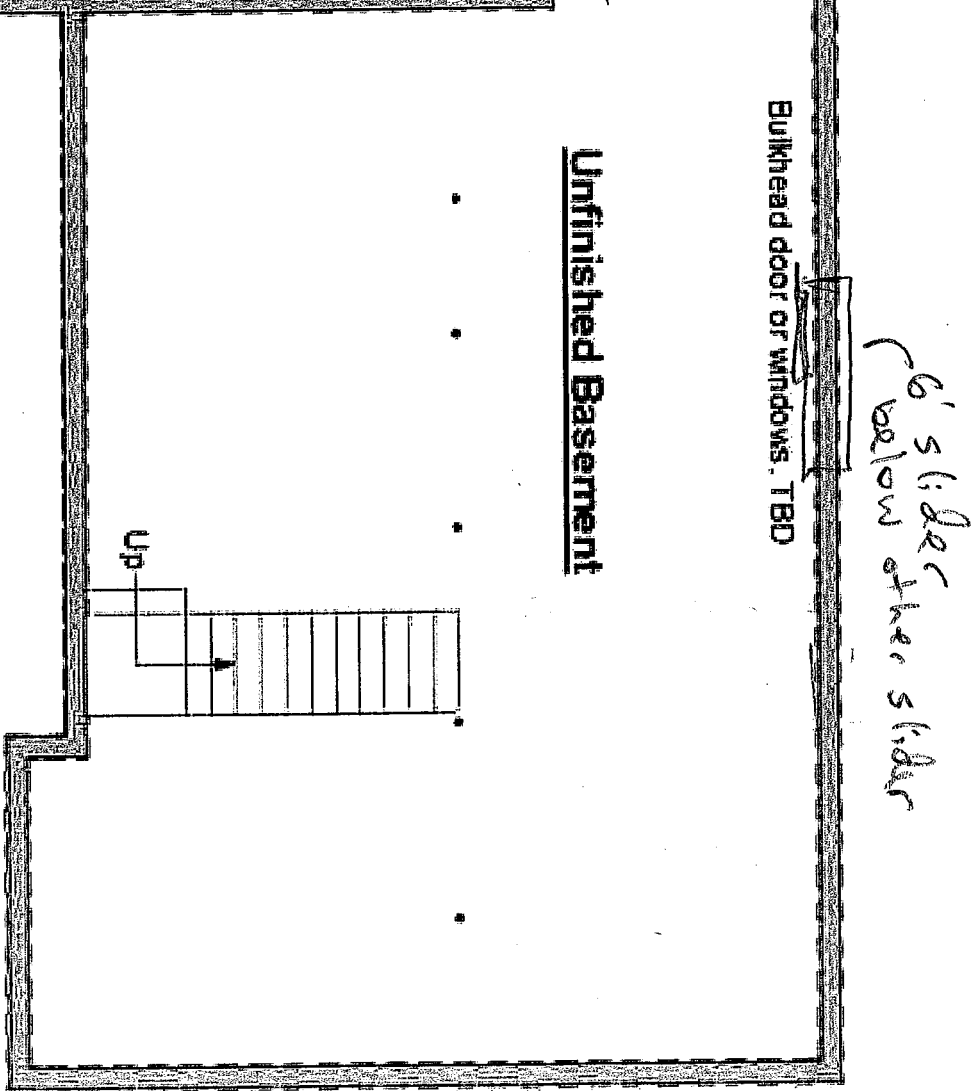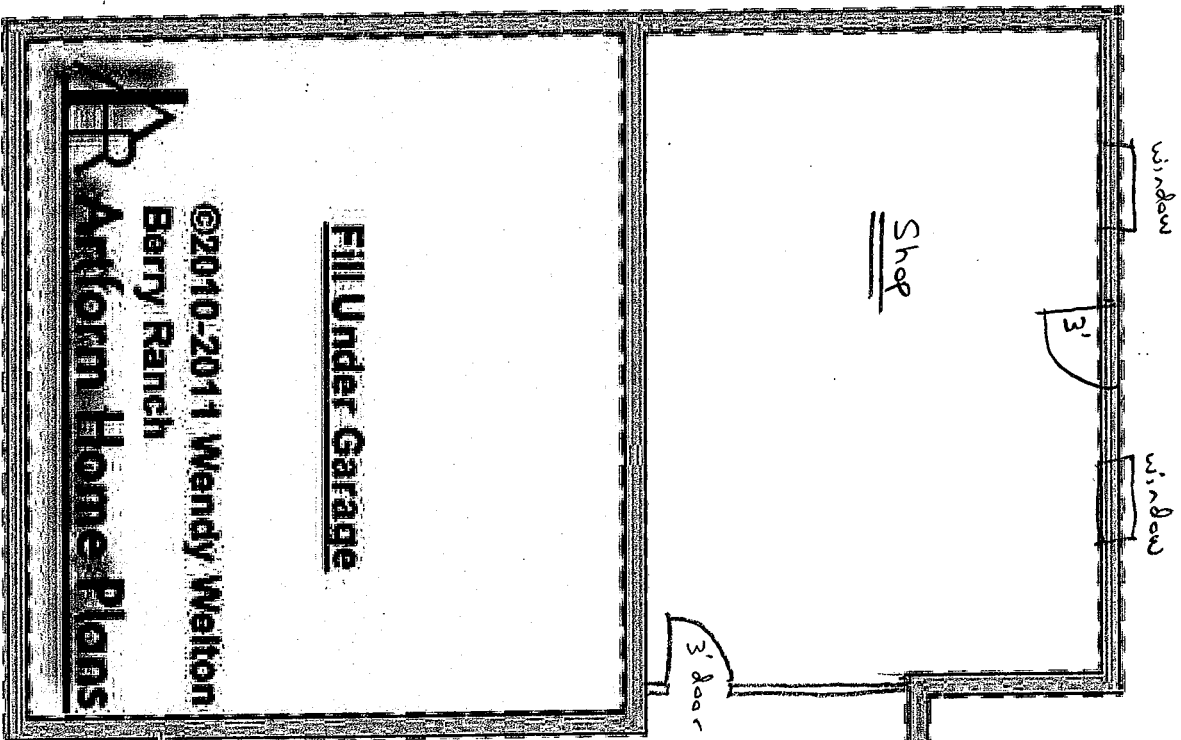



XC