


ORIG #3

Finished
area


Living Area this Floor: 1080 sq ft
8'-0" Finished Ceiling Height

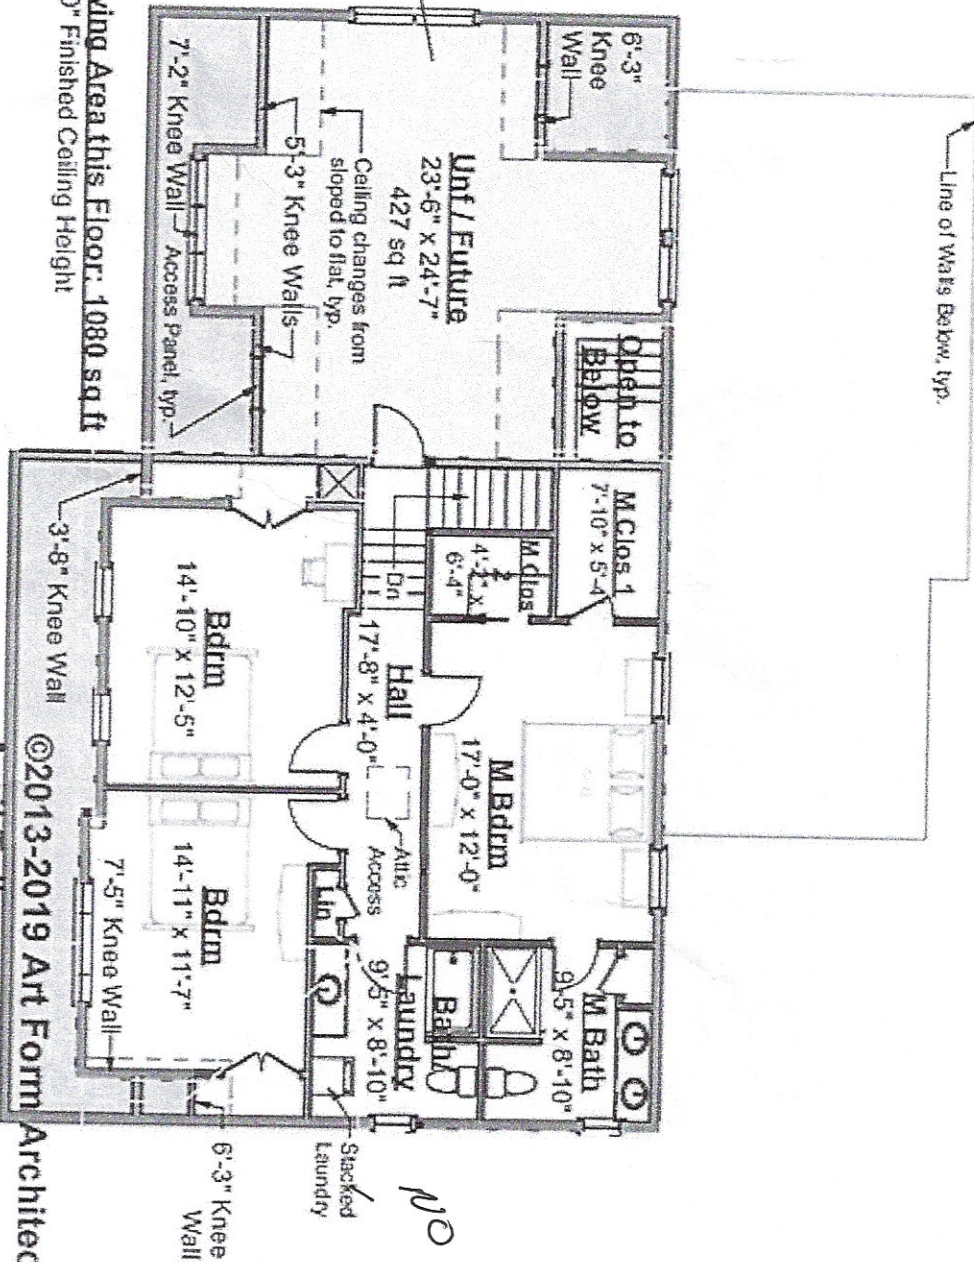


April Tulip

©2013-2019 Art Form Architecture

©2013-2019 Art Form Architecture
April Tulip

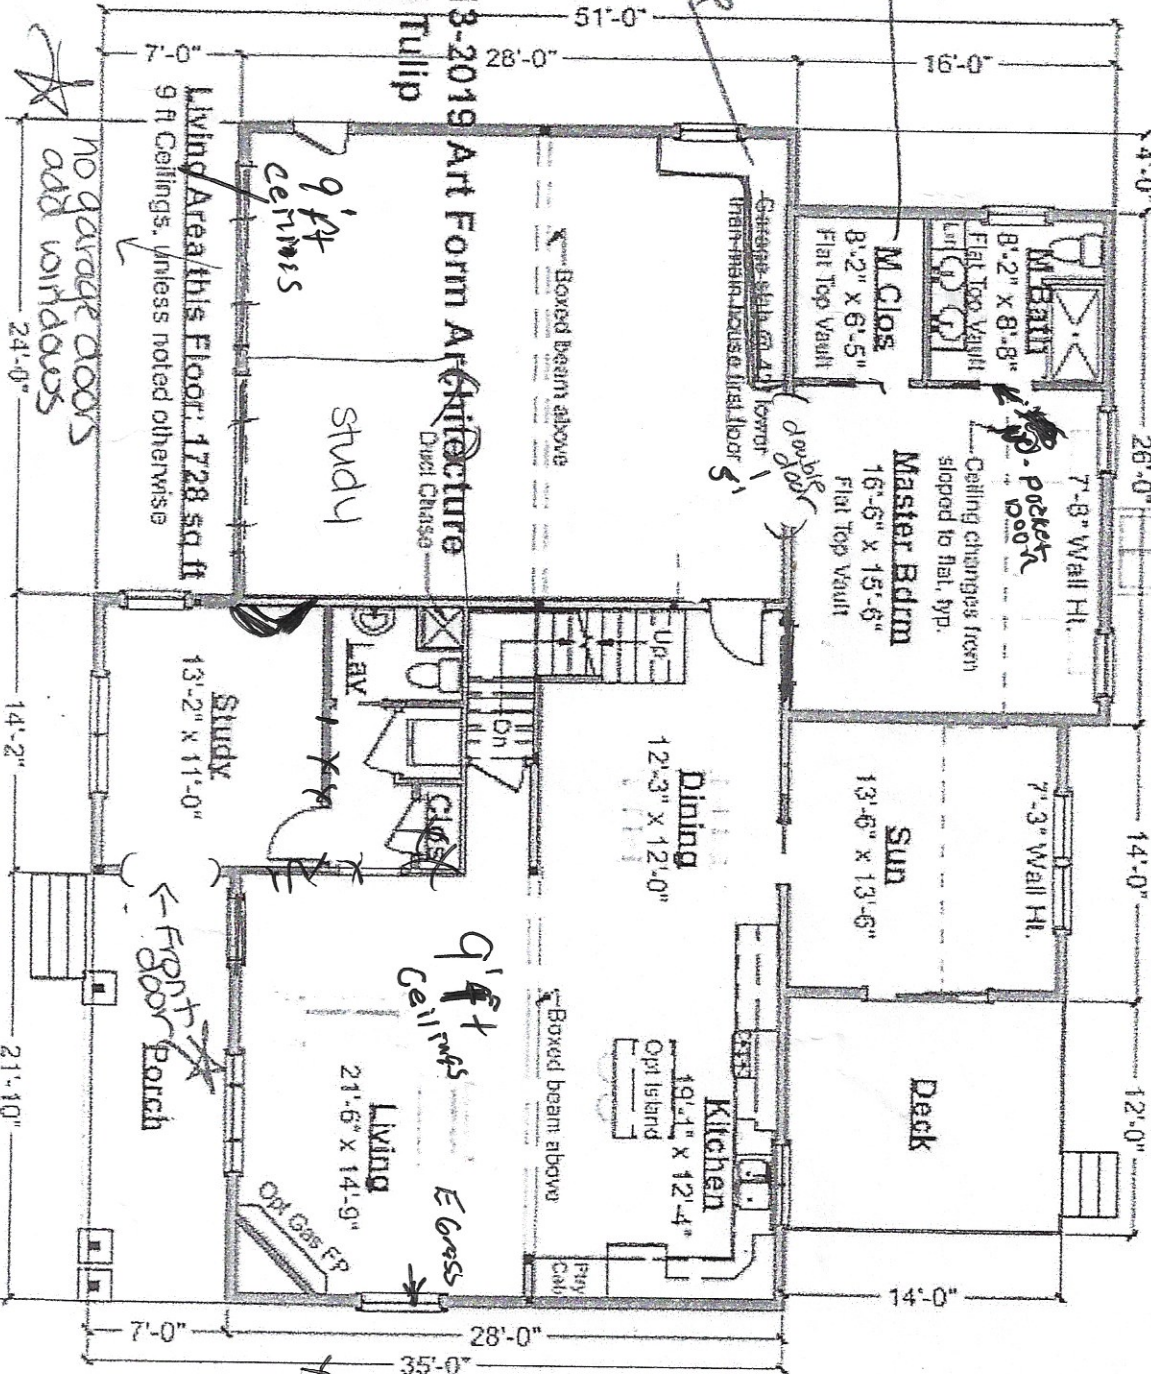

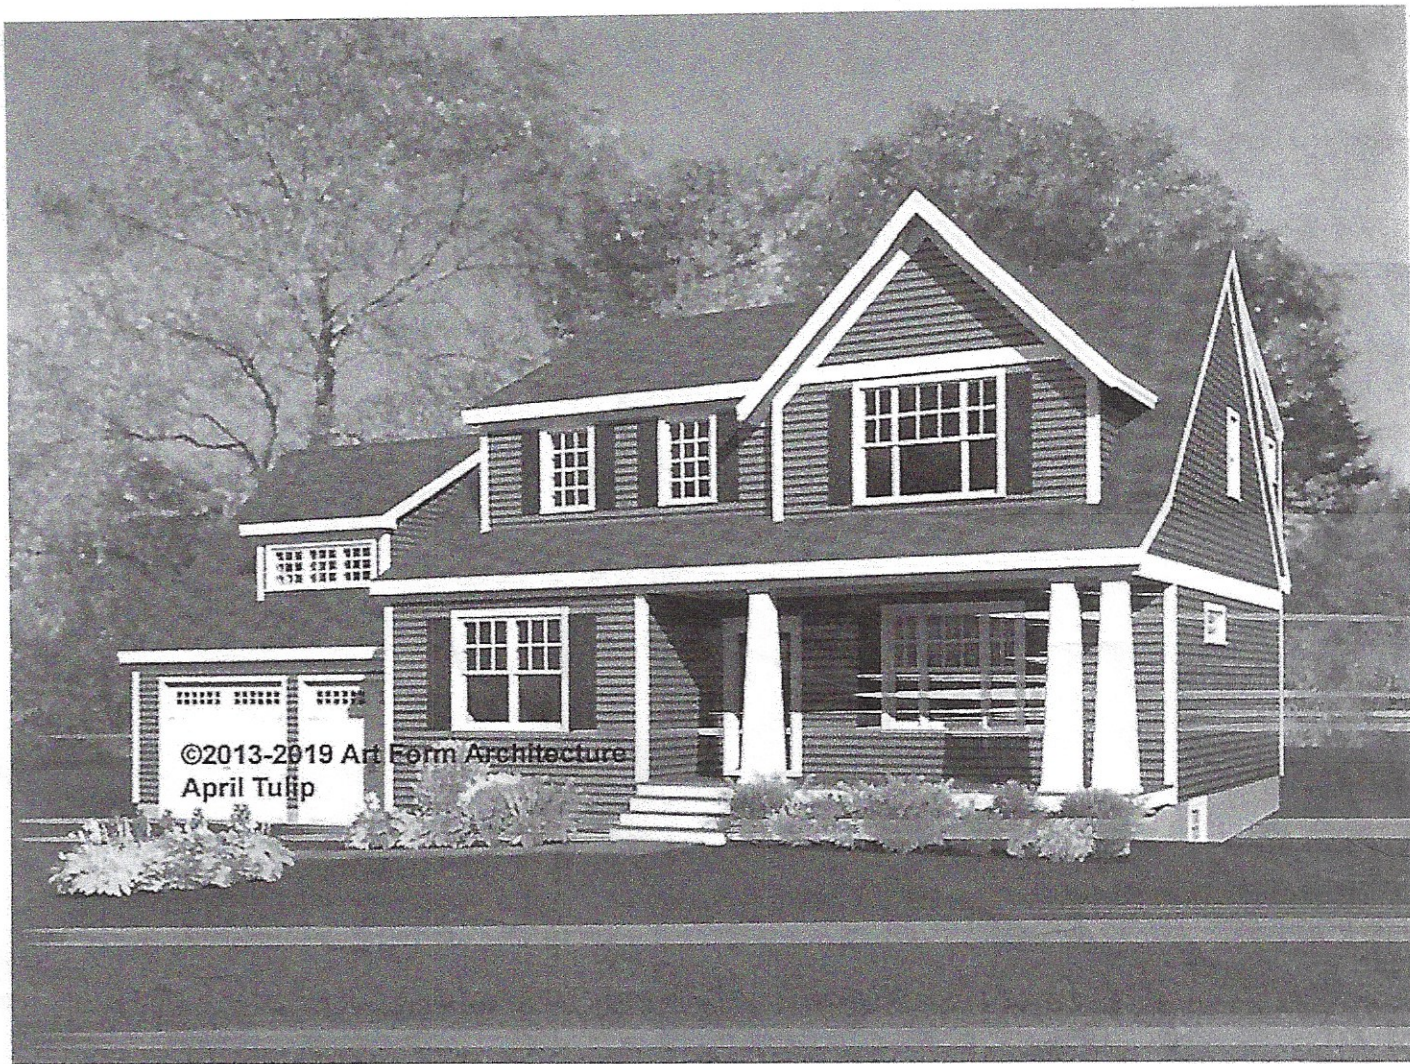

©2013-2019 Art Form Architecture
April Tulip

B 563, 200