

Dara
699.126 KL




603-431-9559

© 2015 Wendy Walton, all rights reserved. You may not make any changes to this design without purchasing a license, even if the changes are minor. This design may have geographical restrictions.

4' add

Lorden
Lot 31

deck

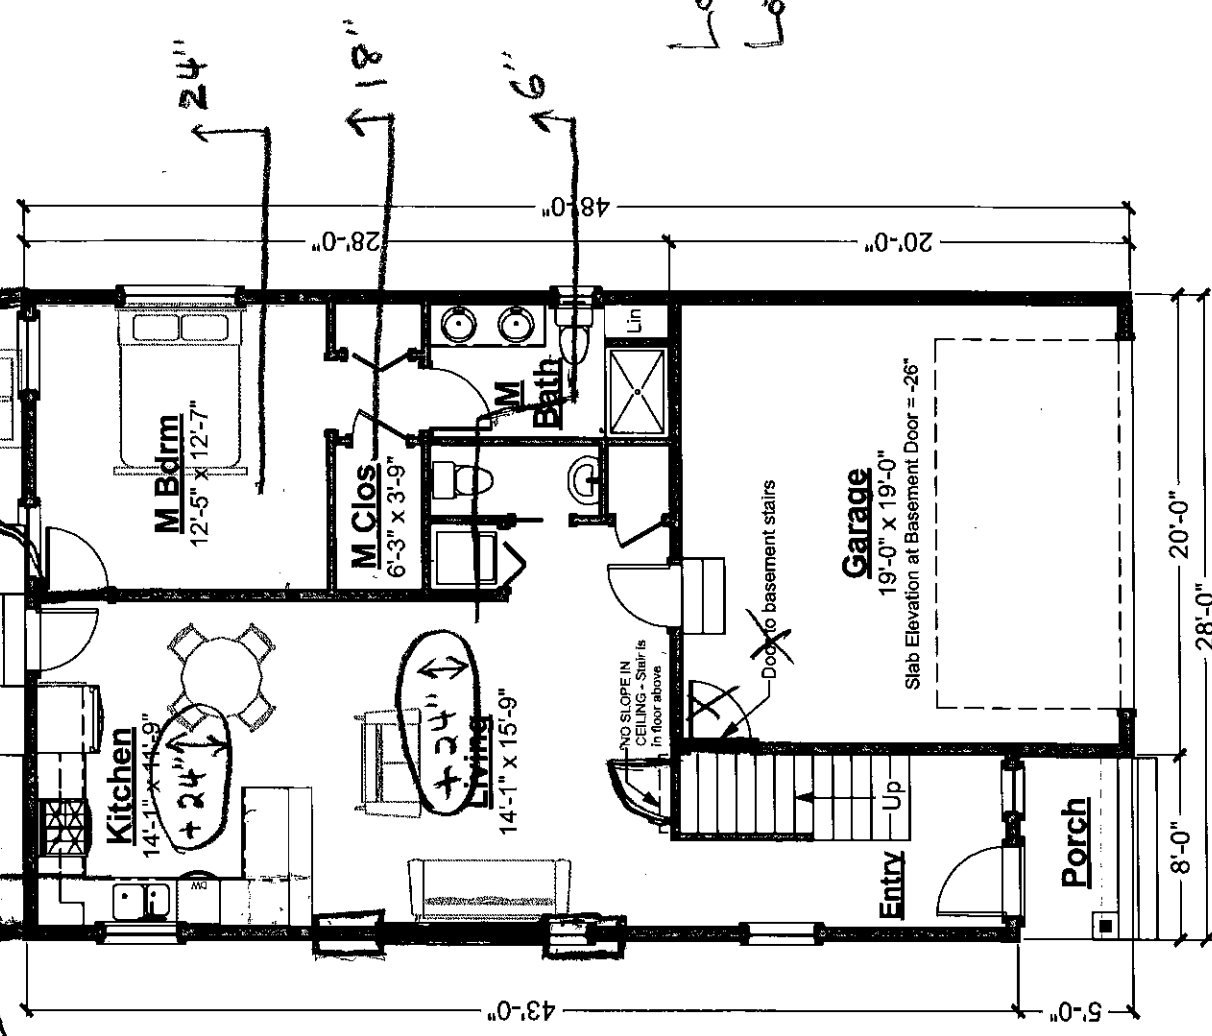

Living Area - This Floor: 920 SF


First Floor Plan

Dara
699.126 KL



603-431-9559

© 2015 Wendy Welton, all rights reserved. You may not build this design without purchasing a license, even if you make changes. This design may have geographic restrictions.

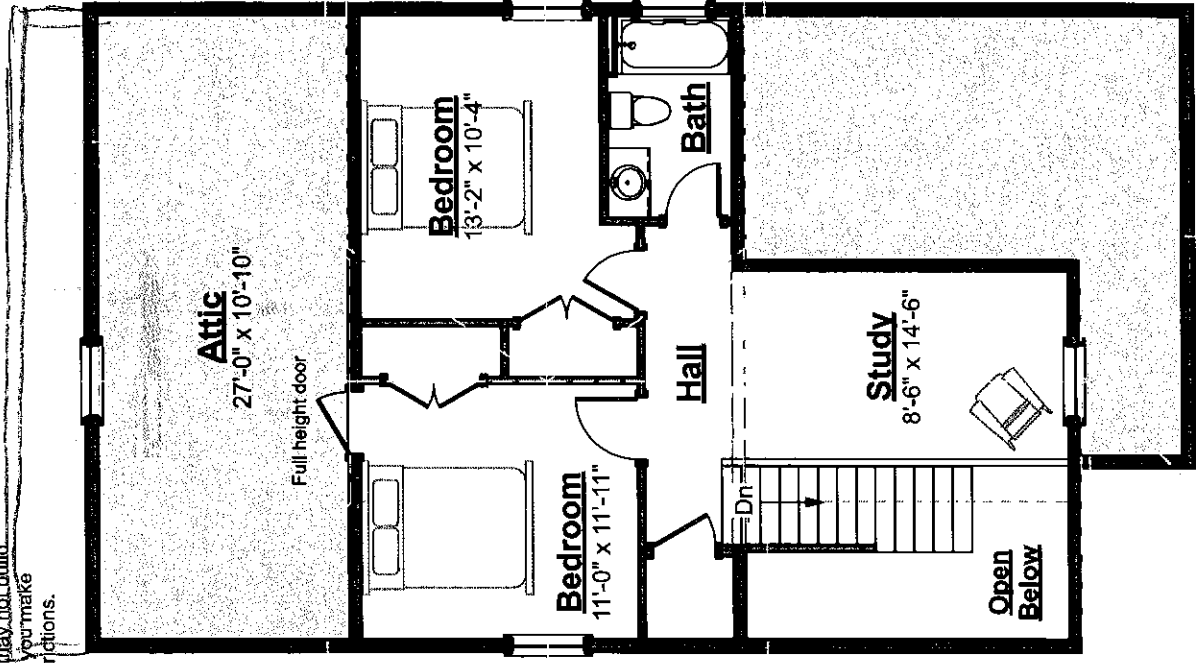


Second Floor Plan

Living Area - This Floor: 721 SF

Dara
699.126 KL

© 2015 Wendy Walton, all rights reserved . You may not build
this design without purchasing a license, even if you make
changes. This design may have geographic restrictions.

6' slider

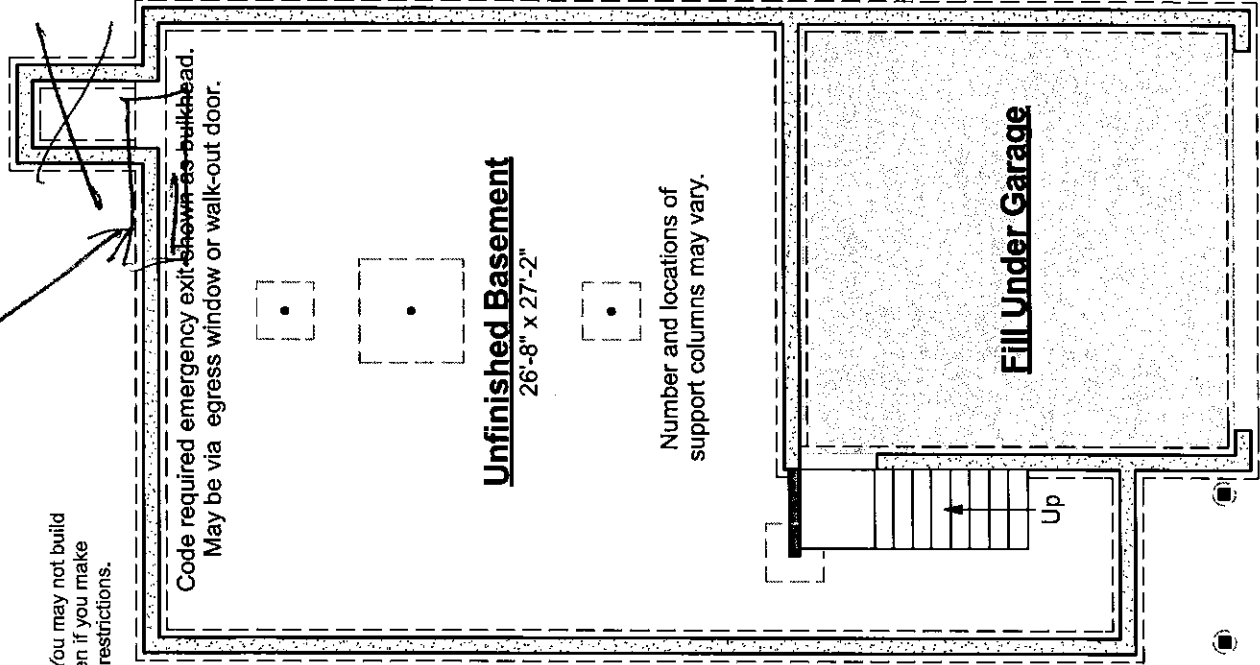

Foundation Plan