

Raspberry Biscotti

564.144.v39 GL (3/9/2021)

© 2013-2021 Art Form Architecture, Inc., all rights reserved. You may not build this design without purchasing a license, even if you make changes. This design may have geographic restrictions.




603-431-9559

dotloop signature verification : d1p1u5r3ybrq3-w0u1-k1m0u1

Living Area First Floor: 1744 sq ft
9 ft Ceilings

Alan Anderson
dotloop verified
03/09/21 6:19 PM EST
54GQ-DVHM-KM7N-IKRC

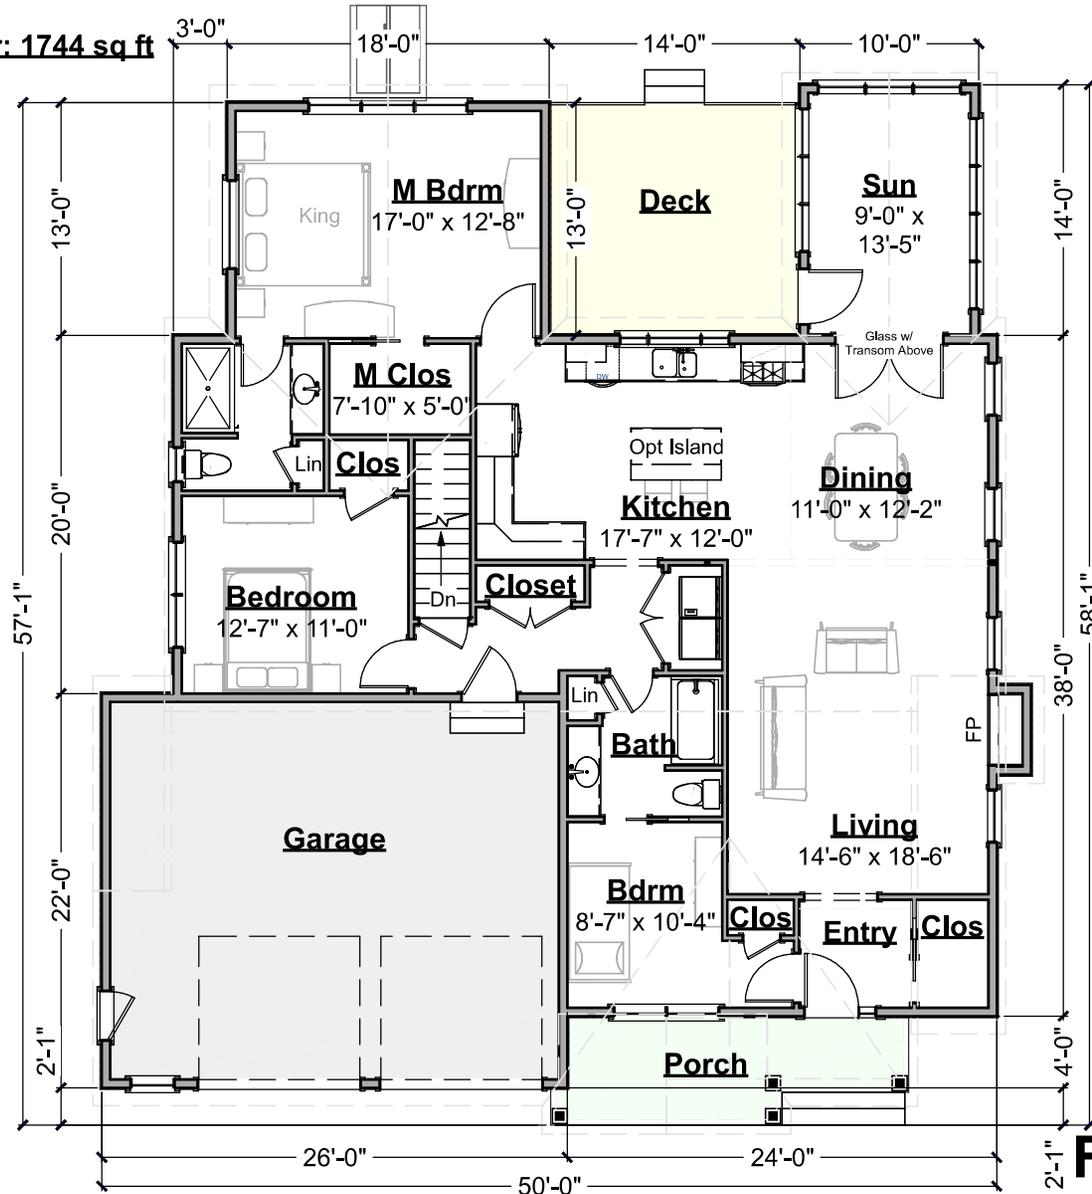

- Change living room windows so that we have wall space and the windows are set higher towards the ceiling.
- Change the window in the master bedroom to a single french door. We plan to build a deck off the back of the house later after the house is built.
- Tile shower in Master BR
- Gas FP

First Floor Plan

Scale: 3/32" = 1'-0"