

Raspberry Biscotti Changes

Lot 39

Adam Anderson

Change Requests

- 9ft Ceilings
- Fireplace
- A/C
- Hardwood in all rooms
- Substitute red oak with hardwood material TBD
- Wider kitchen window (see Fig. 1)
- Sunroom entrance (see Fig. 4)
- Transoms above double hung windows (see Fig. 2-4)
- Pocket Doors in front bedroom/bathroom, master closet, and entry closet as per 564.144.v24 KR (see Fig. 5)
- Wider garage with window as per 564.144.v24 KR (see Fig. 5)
- Composite decking (e.g., TREX) instead of pressure treated



Fig. 1

Kitchen window features center picture window in original plan width now flanked by two casement windows



Fig. 2
Double hung windows in living room with transoms above



Fig. 3
Double hung windows in sunroom with transoms above



Fig. 4
Sunroom entrance with transoms above

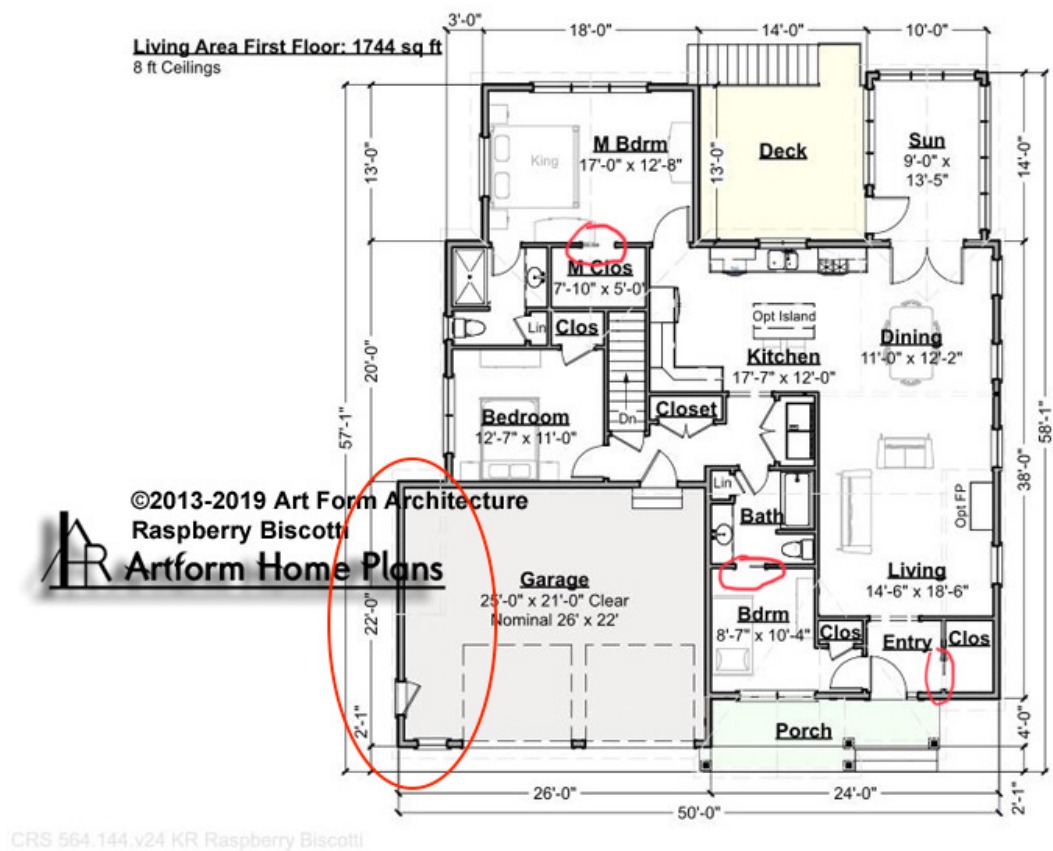


Fig. 5
Pocket doors and larger garage (plan 564.144.v24 KR)

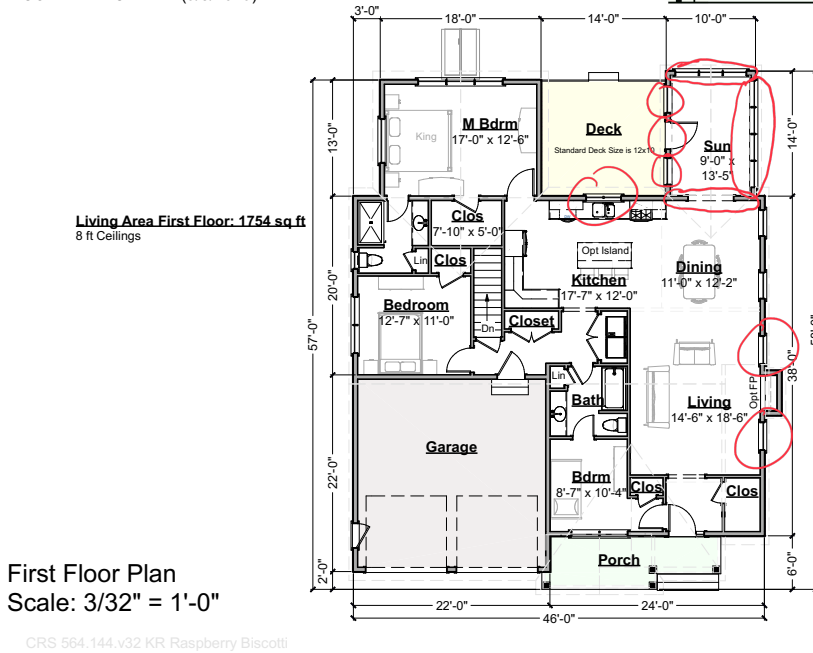


Fig. 6
Windows to be changed



Right Elevation
 Scale: 1/8" = 1'-0"

CRS 564.144.v32 KR Raspberry Biscotti

Fig. 7
Sideview of windows to be changed



Rear Elevation
Scale: 1/8" = 1'-0"

CRS 564.144.v32 KR Raspberry Biscotti

Fig. 8
Rear view of windows to be changed

