

# 668.124.v2 KR Vanilla Crescent



## First Floor


	Area	Beds	Baths
Main	1416 SF	2	2
Future	0 SF	0	0
Apt	0 SF	0	0
Total	1416 SF	2	2

Ceiling Height
Shown 8'-0"

Possible\* 9'-0"

\* See Major Change information on plan page for cost

\*for front of house, hallow barrell gable in front peak\*. and no railings on deck, include 1 post

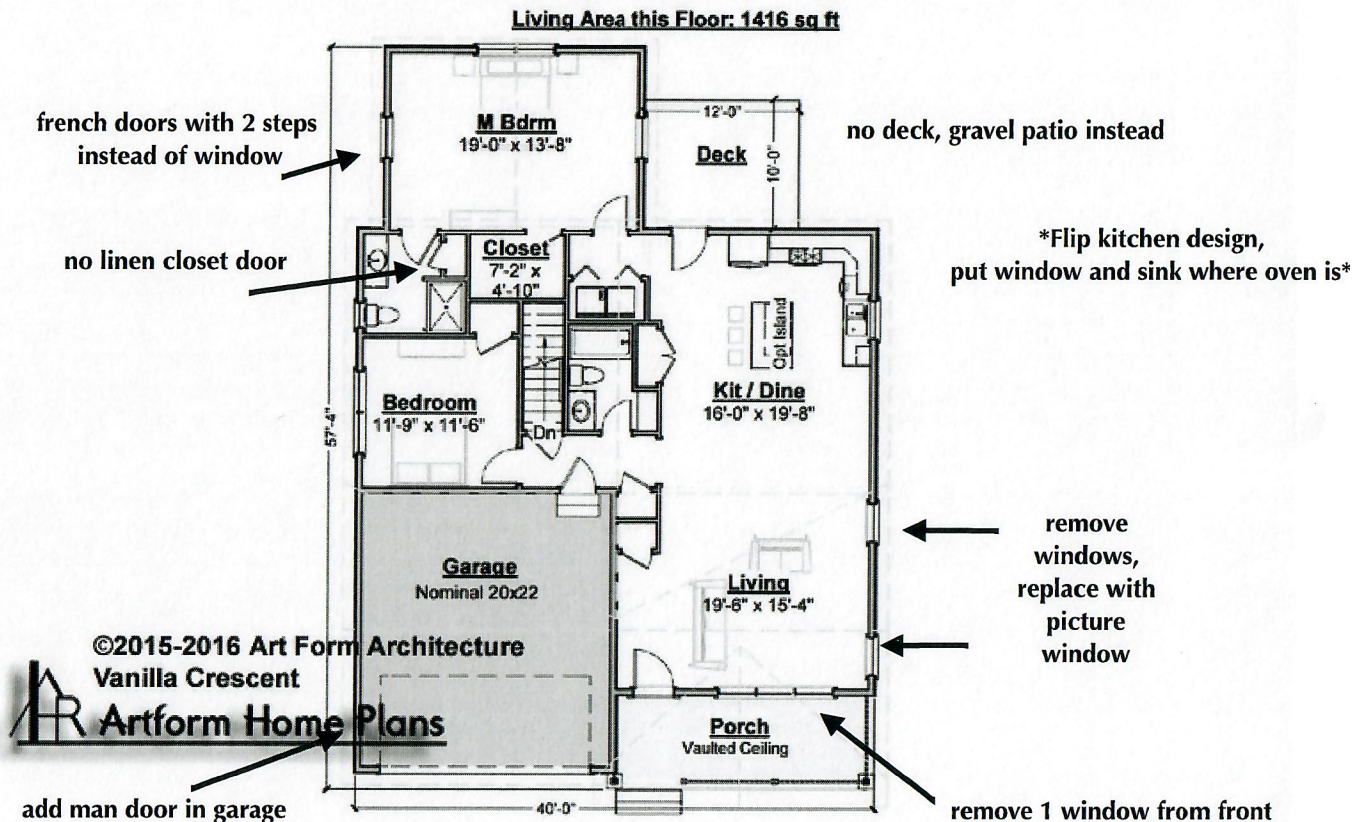

**Use of this document** is governed by our **Terms and Conditions**, found on our website:  
<http://www.artformhomeplans.com/TermsConditions.a5w>

© 2015 Art Form Architecture, Inc. ALL RIGHTS RESERVED.  
You may not build this Design without purchasing a License to Build (as defined in our Terms). Unauthorized changes are not permitted and violate copyright laws, which provide substantial penalties for infringement.

Some features show are optional. Your Purchase & Sale Agreement governs, whether items are labeled "optional" in this document or not.

We are not responsible for typographical errors.

ARQ.