

First Floor

	Area	Beds	Baths
Main	1171 SF	1	1.5
Future	0 SF	0	0
Apt	0 SF	0	0
Total	1171 SF	1	1.5

Ceiling Height

Shown 9'-0"

Possible* 8'-0"

* See Major Change information on plan page for cost

Slide

ake Extend deck between
sunroom and doghouse
with steps going off back of deck

Slider on left wall, regular windows on back wall


Artform Home Plans

CHANGE TO SUNROOM 12'x19'
transom windows on this wall

Living Area this Floor: 1171 sq ft

9 ft Ceilings

flip sink/window and stove

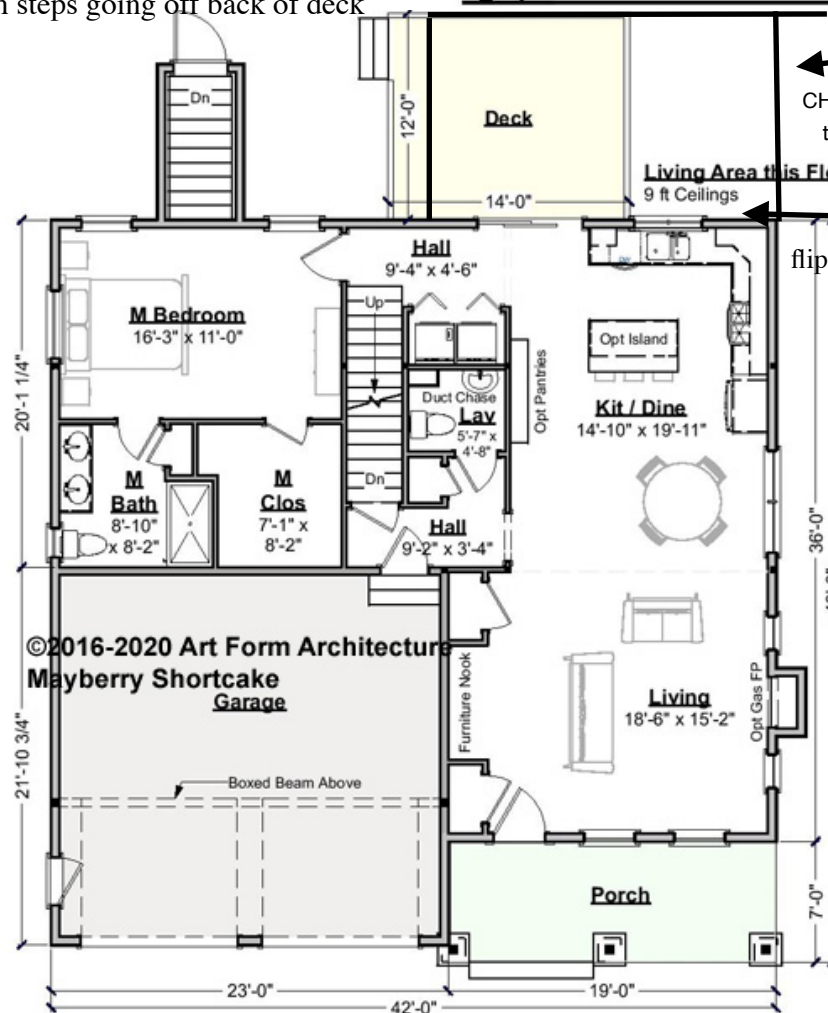

JB

10/27/21
2:02 PM EDT
dotloop verified

KJR
10/27/21

10/27/21
2:04 PM EDT
dotloop verified

TML
10/27/21

10/27/21
1:59 PM EDT
dotloop verified

Use of this document is governed by our **Terms and Conditions**, found on our website: <http://www.artformhomeplans.com/TermsConditions.a5w>

Some features show are optional. Your Purchase & Sale Agreement governs, whether items are labeled "optional" in this document or not.

We are not responsible for typographical errors.

© 2016 Art Form Architecture, Inc. ALL RIGHTS RESERVED.
You may not build this Design without purchasing a License to Build (as defined in our Terms). Unauthorized changes are not permitted and violate copyright laws, which provide substantial penalties for infringement.