


Boysenberry Biscotti

703.144.v18 GR
(2/24/2021)

© 2014-2021 Art Form Architecture, Inc., all rights reserved . You may not build this design without purchasing a license, even if you make changes. This design may have geographic restrictions.

Artform Home Plans
603-431-9559

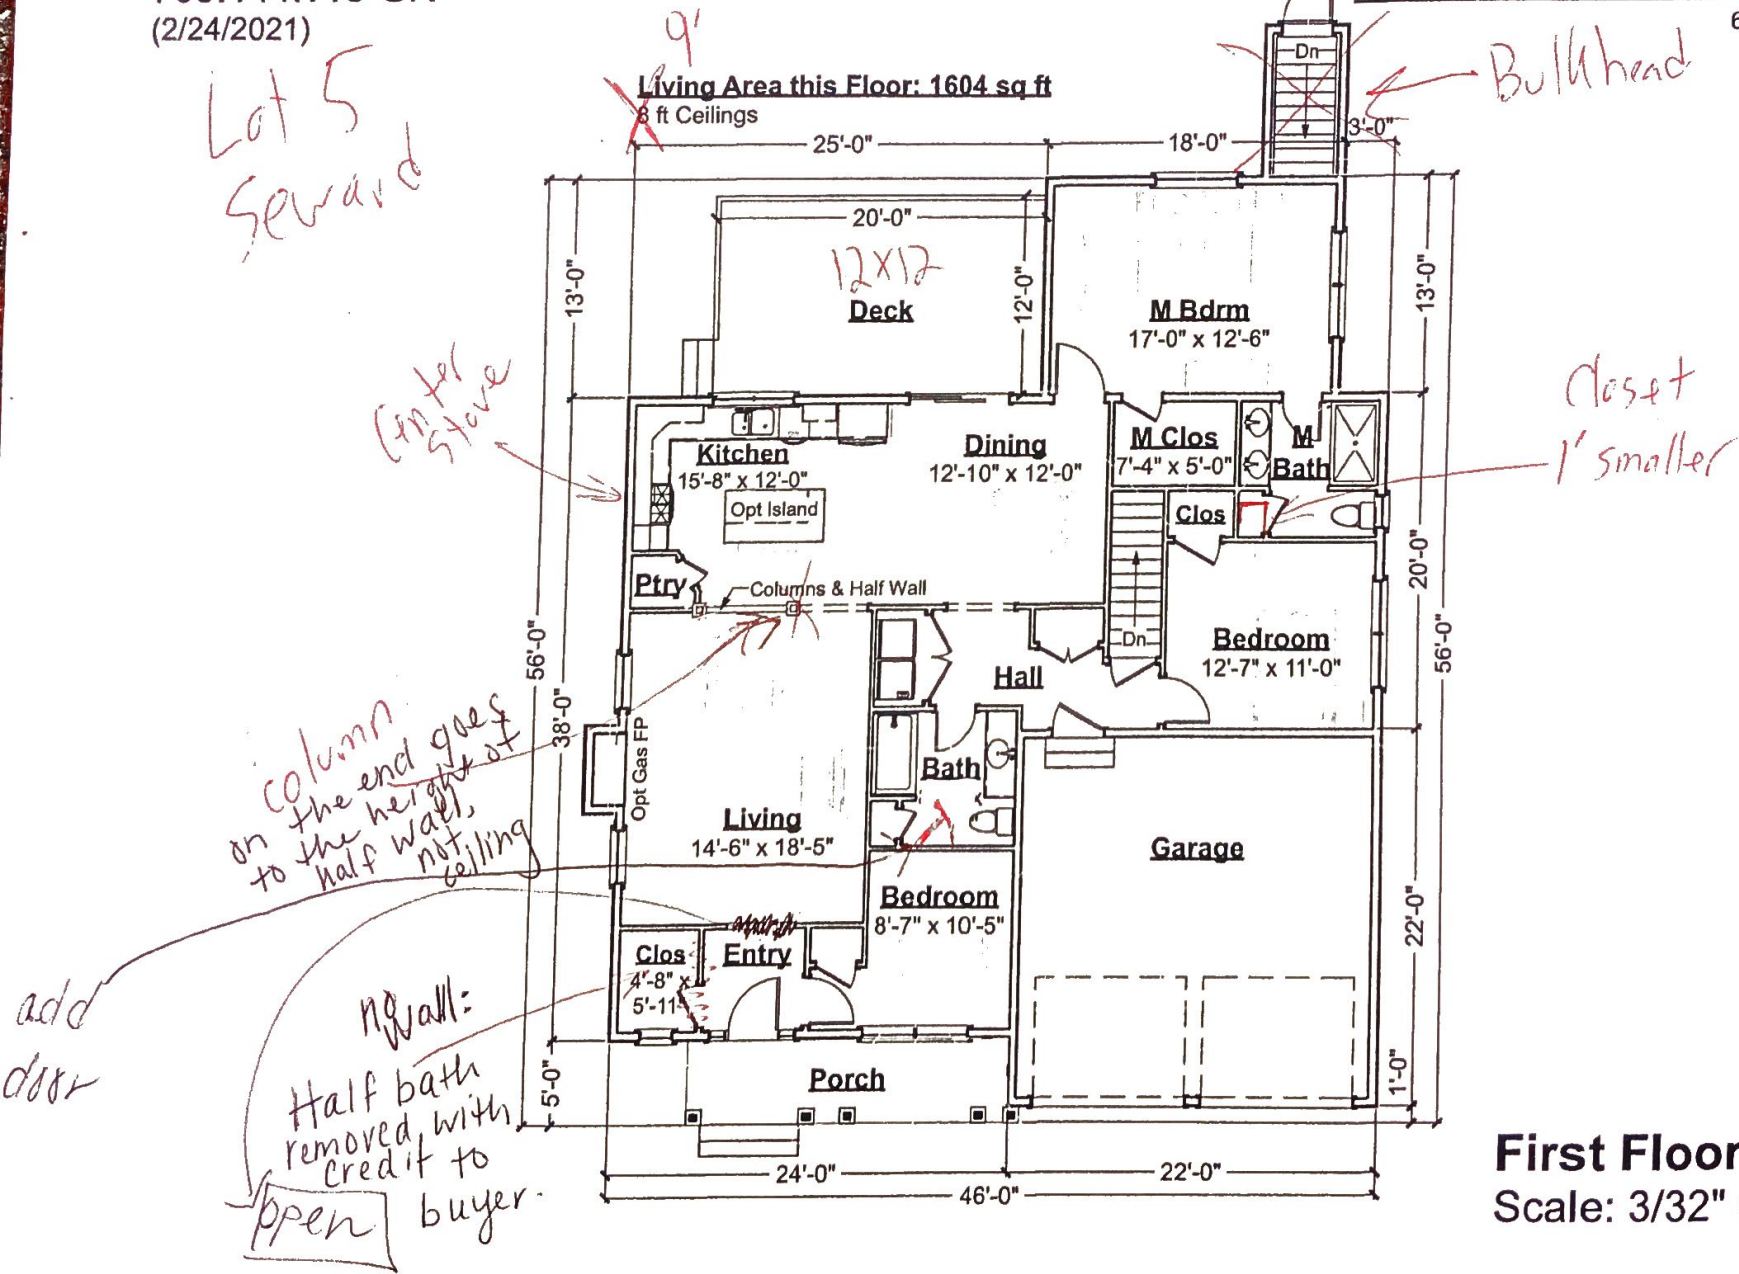

First Floor Plan
Scale: 3/32" = 1'-0"