

# Raspberry Biscotti

564.144.v32 KR (9/3/2019)


© 2013-2019 Art Form Architecture, Inc., all rights reserved .  
You may not build this design without purchasing a license,  
even if you make changes. This design may have geographic  
restrictions.



603-431-9559

Lot 63 Luna Circle  
Eliminate door in front br  
to bathroom replace with  
solid wall  
Eliminate FP

**Living Area First Floor: 1754 sq ft**  
8 ft Ceilings

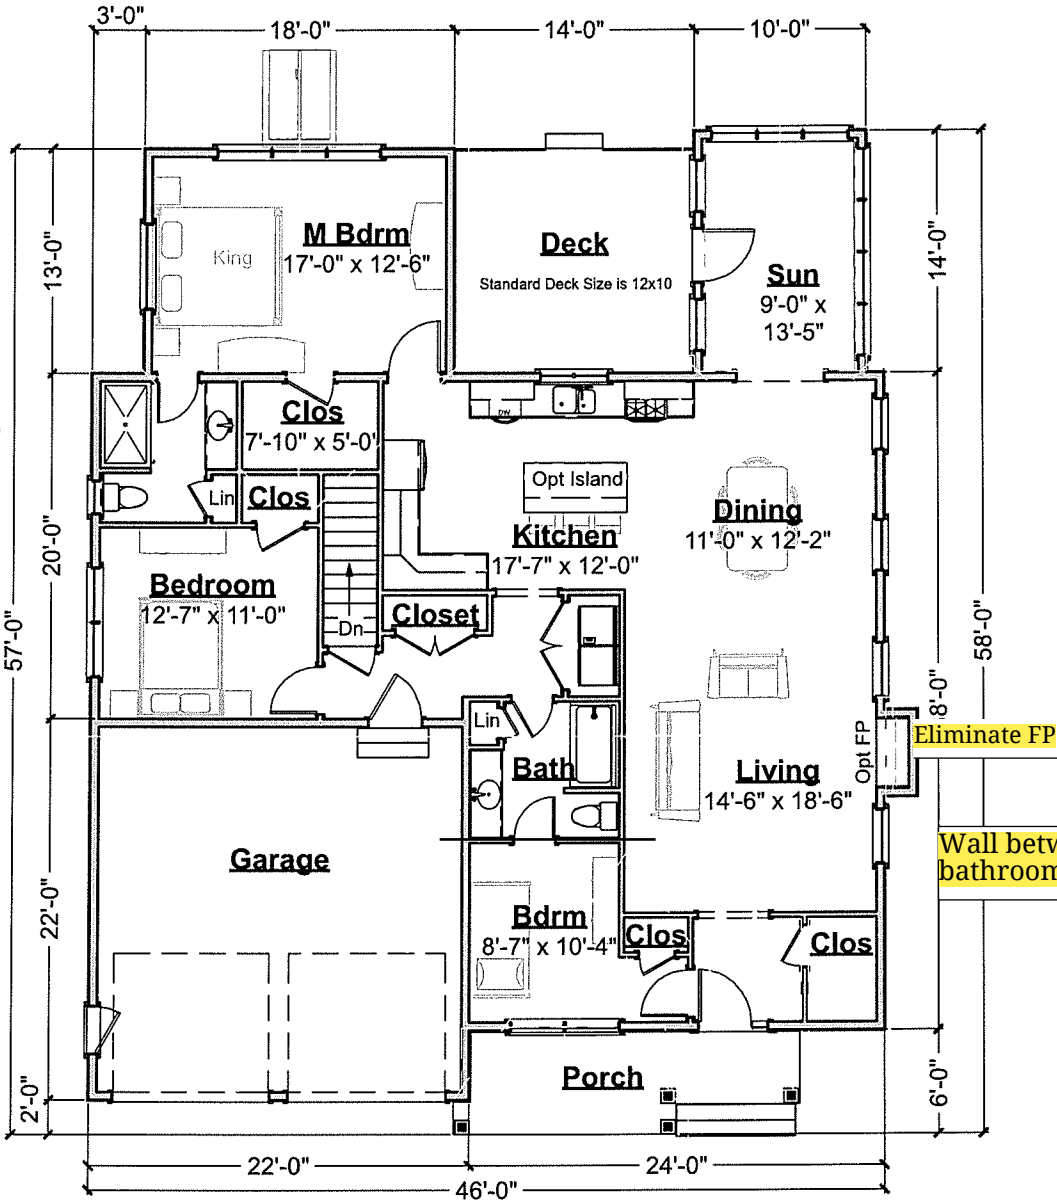

First Floor Plan  
Scale: 3/32" = 1'-0"

EDG  
01/19/21  
5:19 PM EST  
dotloop verified

MNG  
01/19/21  
5:04 PM EST  
dotloop verified

TML  
01/20/21  
7:37 AM EST  
dotloop verified