

April Yarrow Classic

326.124.v3 GR (11/25/2019)

© 2012 - 2019 Art Form Architecture, Inc., all rights reserved. You may not build this design without purchasing a license, even if you make changes. This design may have geographic restrictions.




603-431-9559

Window grids - Gridless on all
+Slider

11/22/21
13614 EST
dotloop verified
11/22/21
9:32 AM EST
dotloop verified

Needed for
load? Options?
JC

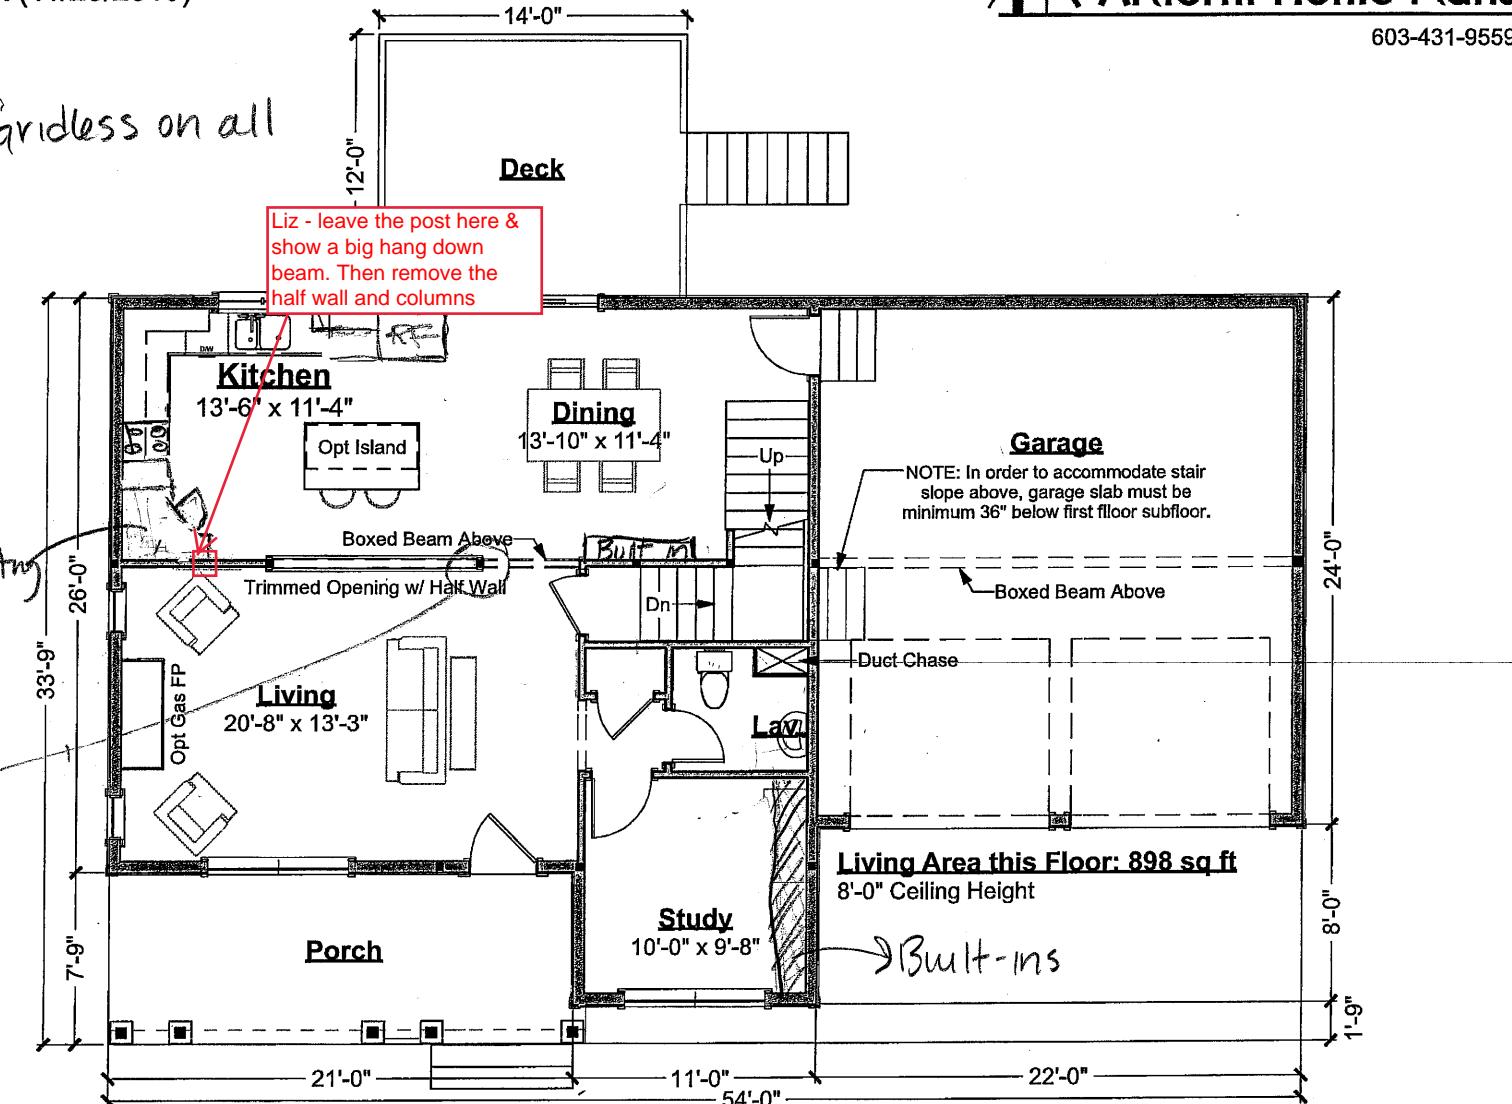

First Floor Plan

Scale: 1/8" = 1'-0"