

Fall W's/Kest
w/ 6 Fricks floor
+ 2 Windows
1 Window in Surround
+ Under Deck
1 ~~Deck~~


Hand-drawn floor plan of a bathroom. The plan shows a rectangular room with a door on the right wall. The dimensions are as follows:

- Overall width: 10'-0"
- Overall depth: 14'-0"
- Door width: 3'-5"
- Door height: 9'-0"
- Door label: Sun
- Handwritten notes:
 - 60"
 - Add Landing w/ stairs to Deck Com
 - Wrestle
 - Door

Add 4 To Garage Width

Fireplace Box To
Interview All
Way To Ceiling

Add Approx. 30 x 30 Fixed windows

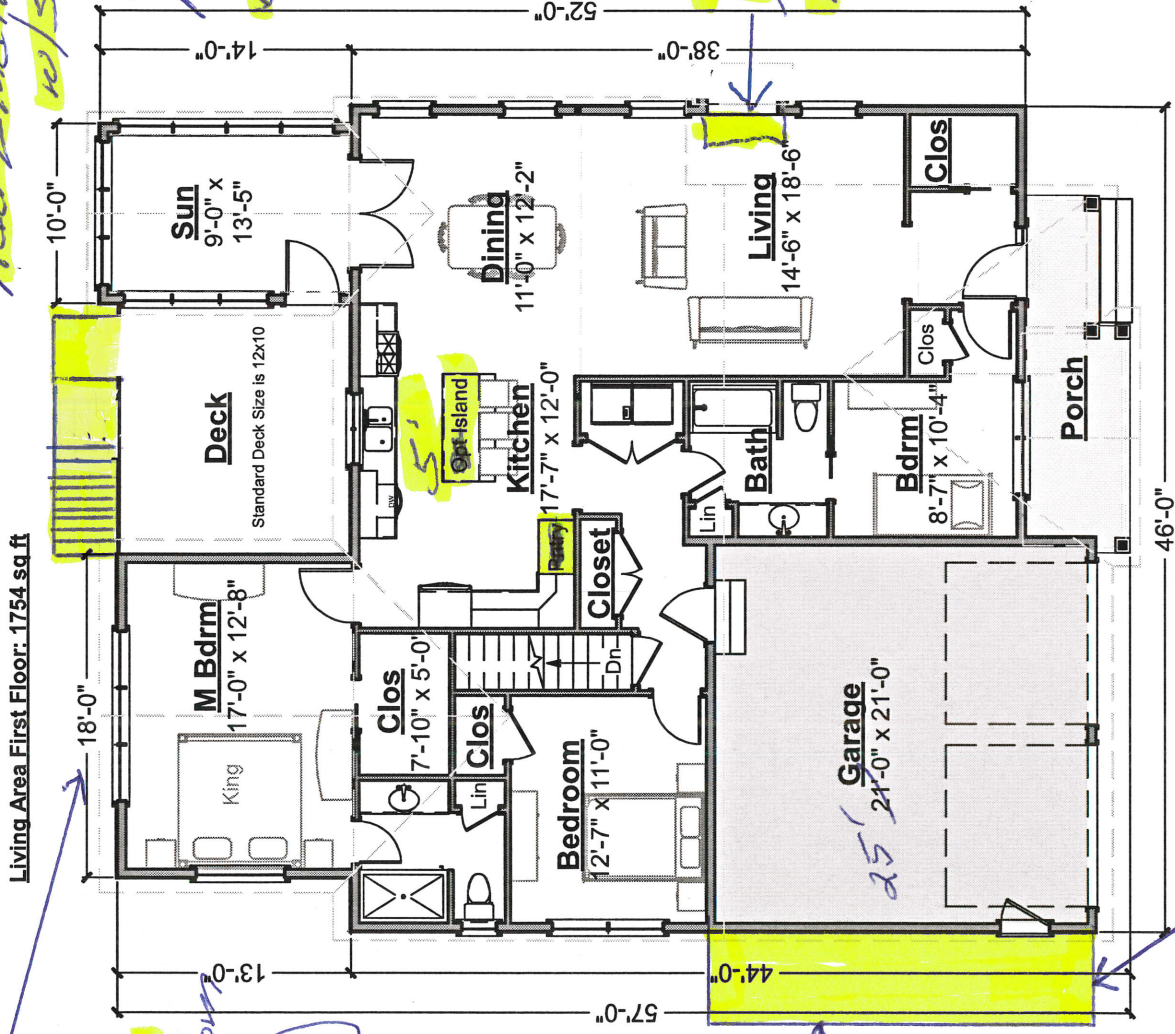

First Floor Plan
Scale: 3/32" = 1'-0"